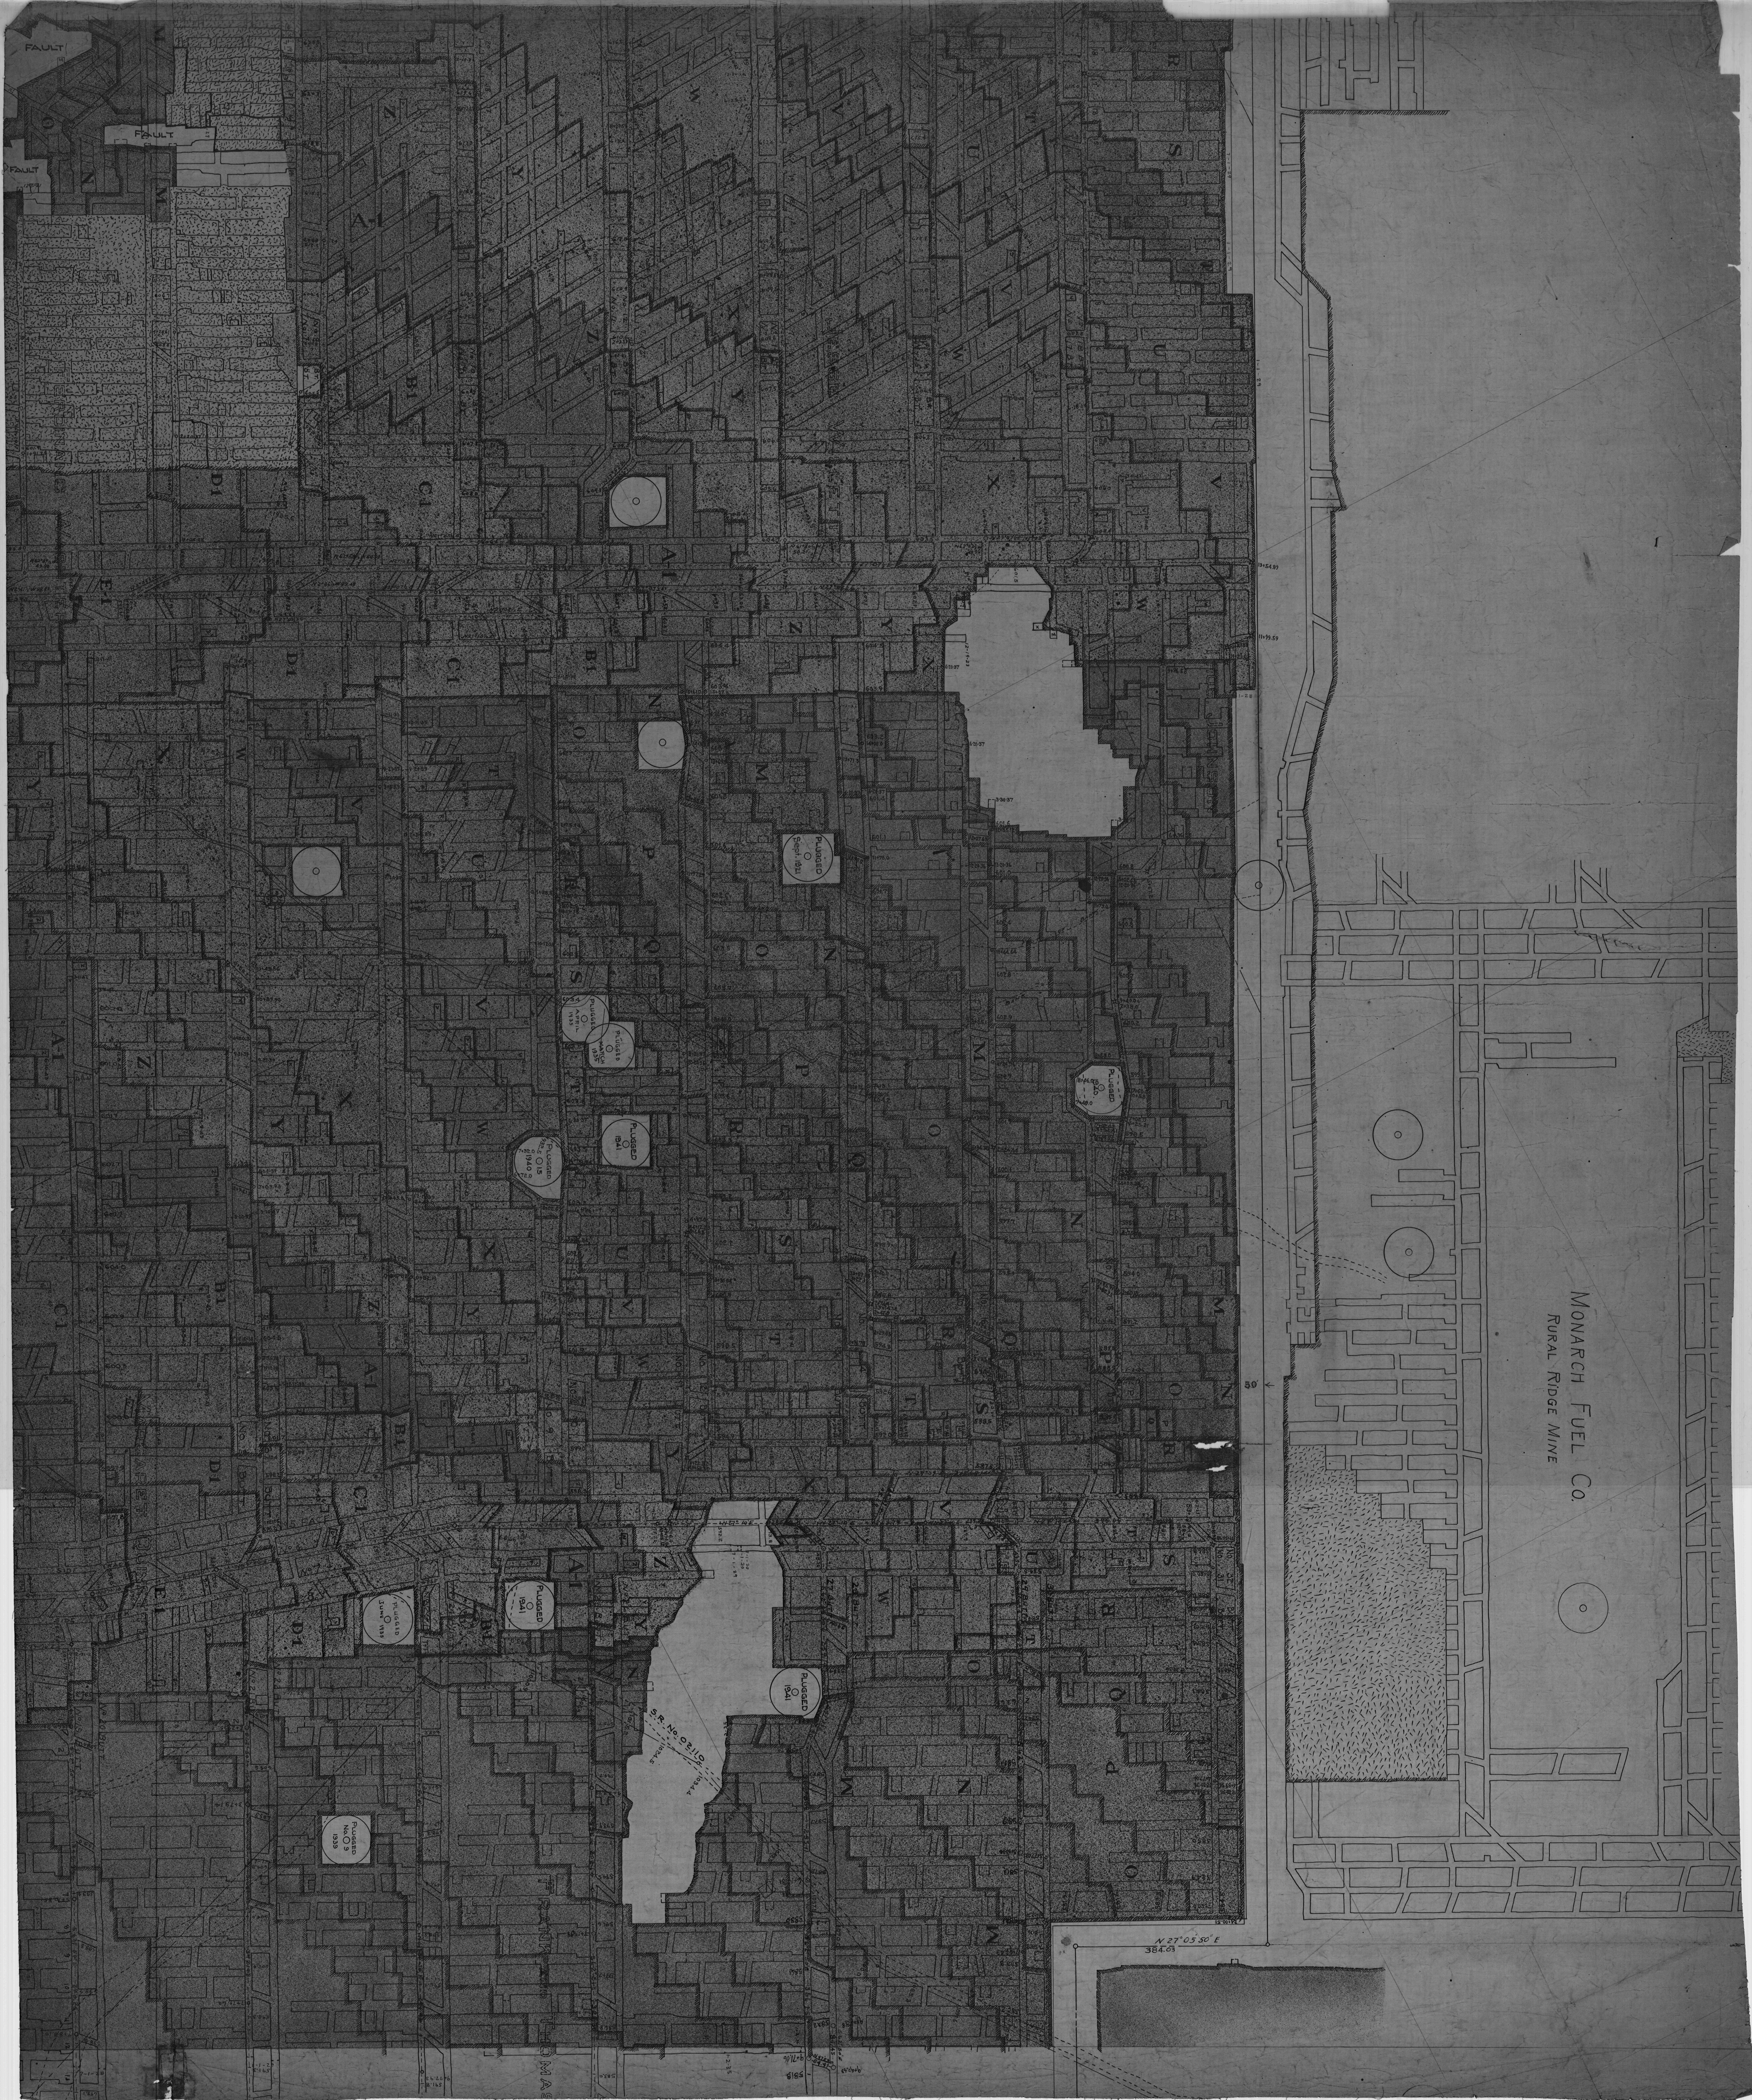
FAULT
FAULT
FAULT
A-1
B1
C1
D1
E1
PLUGGED Sept. 1921
PLUGGED APRIL 1935
PLUGGED MARCH 1935
PLUGGED 1941
PLUGGED 932.5 15 1940
PLUGGED 1920
PLUGGED JUNE 1935
PLUGGED 1941
PLUGGED 1941
PLUGGED No. 9 1939
S.R. No. 02110
13+54.89
11+99.59
1-28
7-1-29
1-1-29
1-1-29
12-19-23
6-20-37
3-36-37
No. 10 BUTT
No. 5 BUTT
No. 6
No. 7
No. 8
SIDE TRACK
N 27° 10' E
50'
N 27°05'50" E
384.03
24+00.51
MONARCH FUEL CO.
RURAL RIDGE MINE