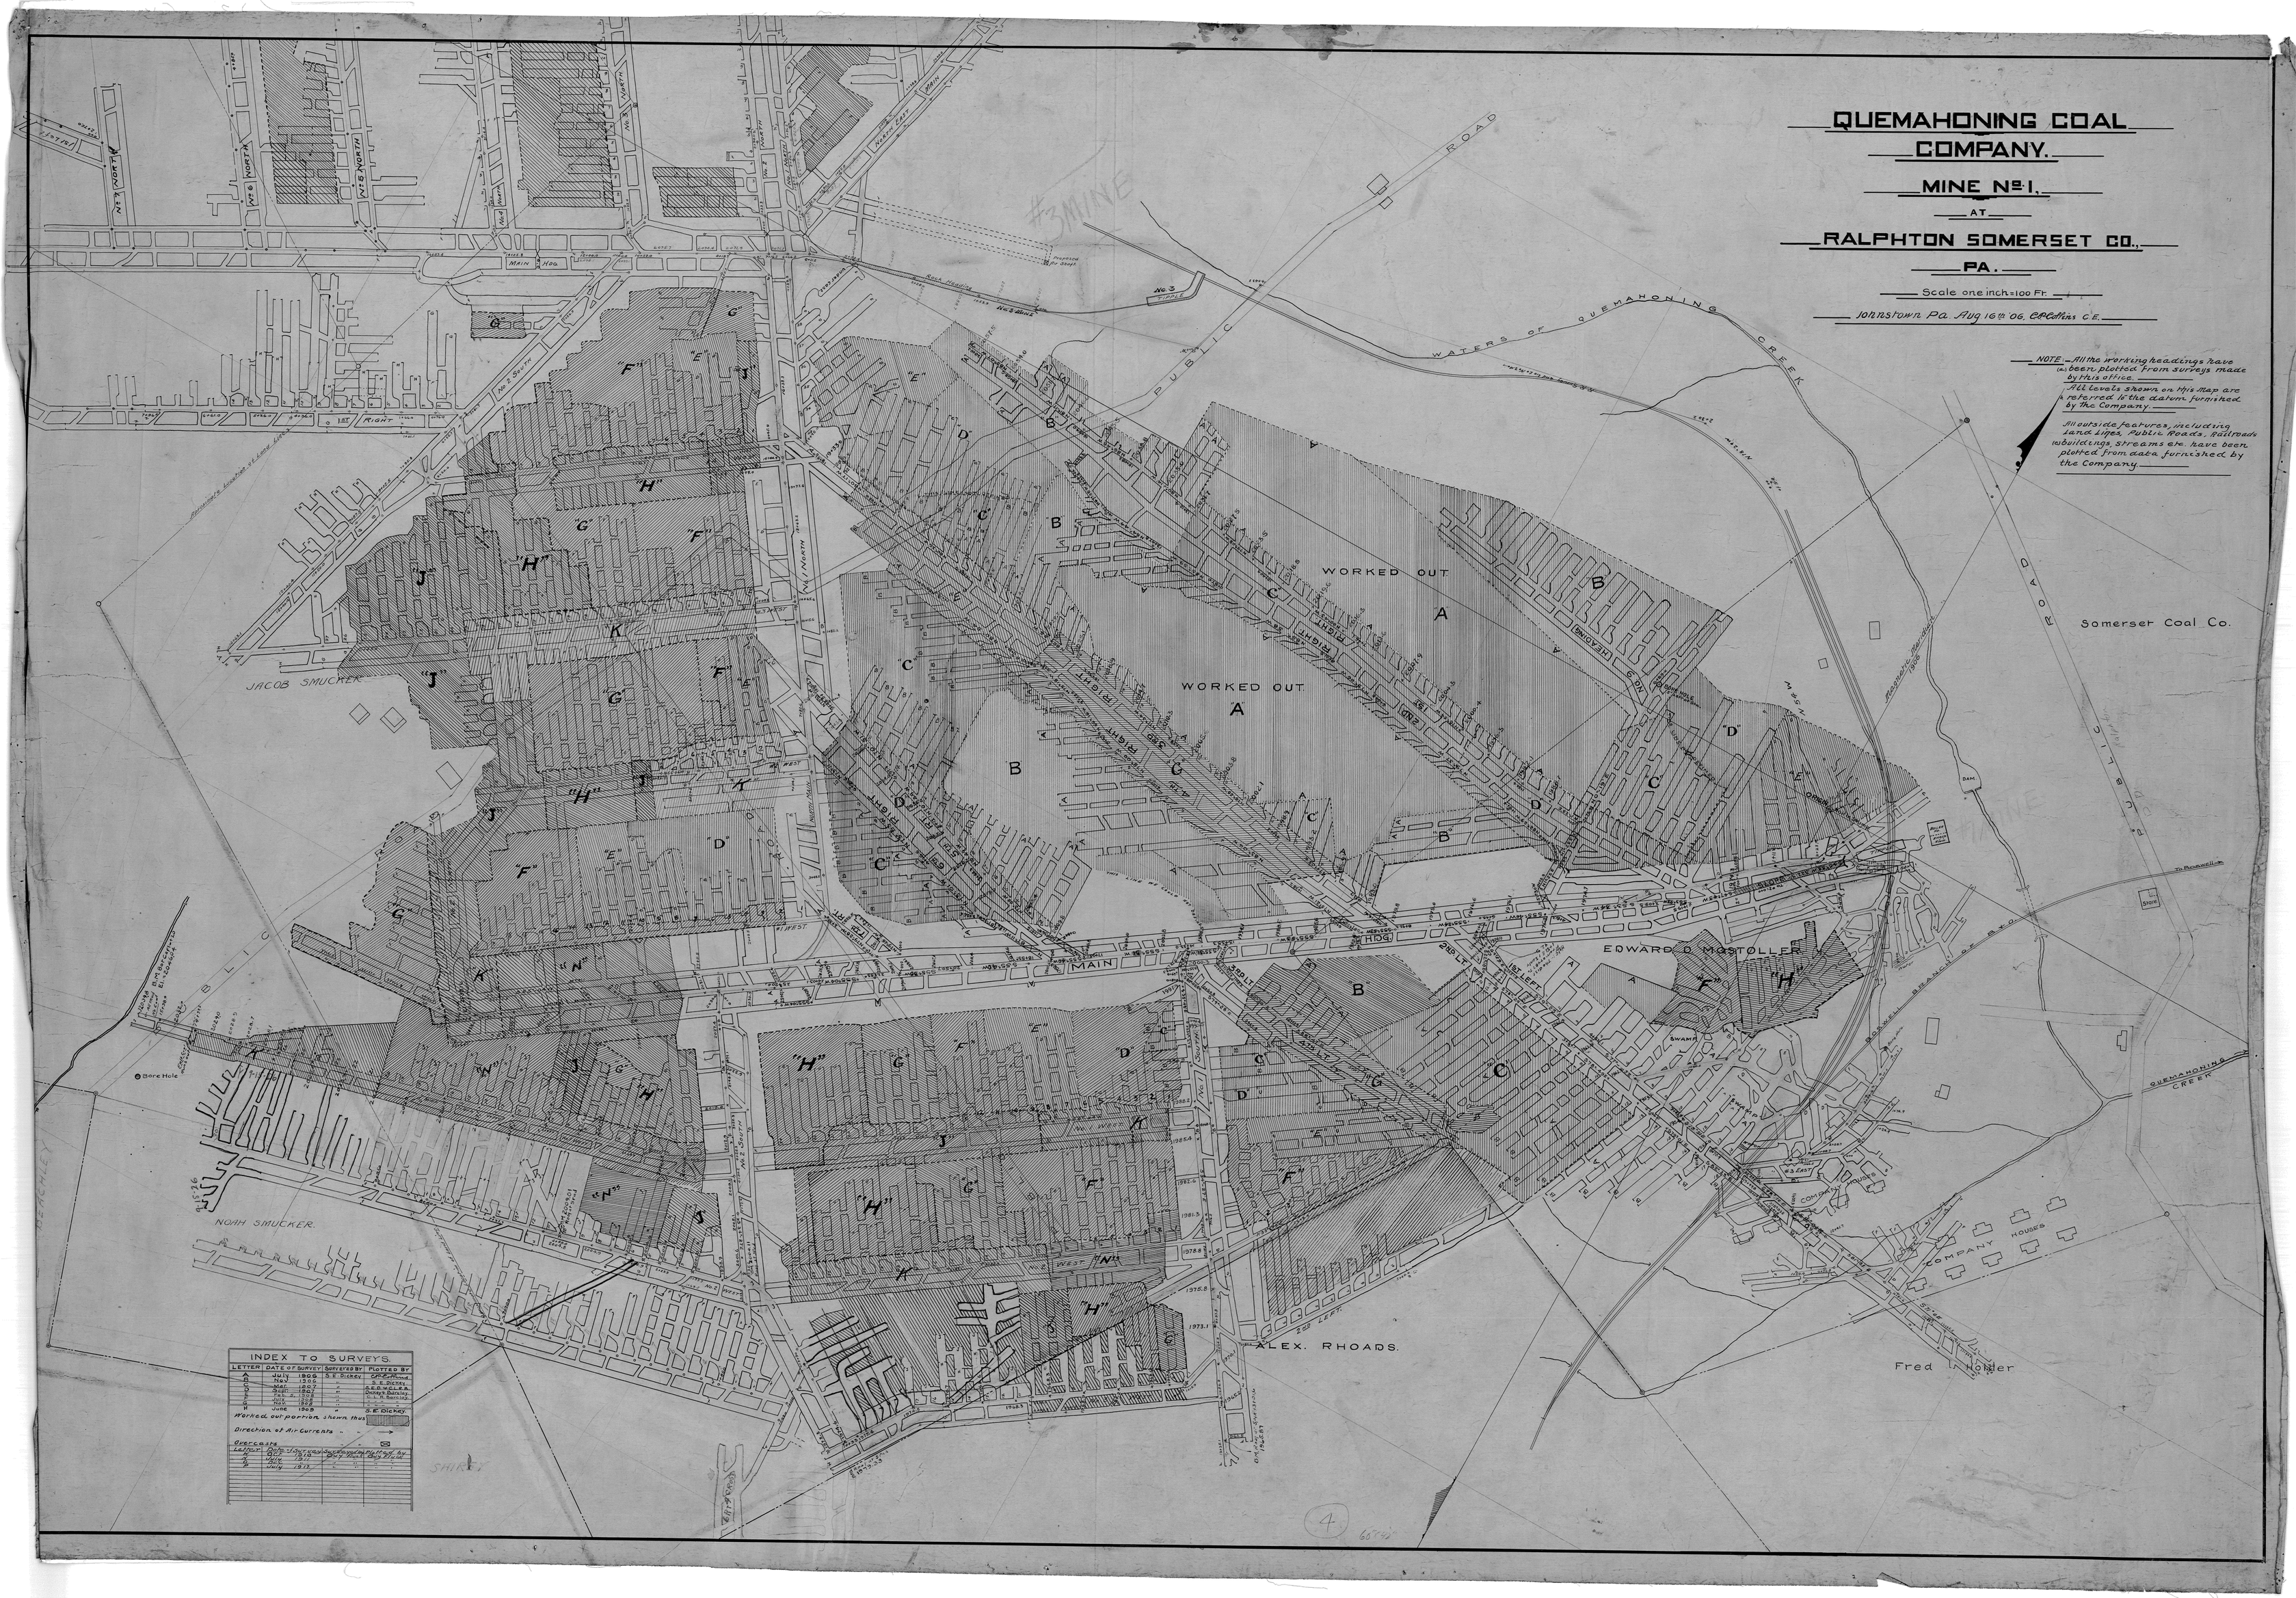
QUEMAHONING COAL COMPANY.
MINE No. 1,
AT
RALPHTON SOMERSET CO.,
PA.
Scale one inch=100 Ft.
Johnstown Pa. Aug. 16th '06. C.P. Collins C.E.
NOTE:- All the working headings have been plotted from surveys made by this office.
All levels shown on this Map are referred to the datum furnished by the Company.
All outside features, including Land Lines, Public Roads, Railroads, buildings, streams etc. have been plotted from data furnished by the Company.
WORKED OUT
WORKED OUT
JACOB SMUCKER
NOAH SMUCKER
EDWARD D. MOSTOLLER
ALEX. RHOADS.
Fred Holder
Somerset Coal Co.
PUBLIC ROAD
WATERS OF QUEMAHONING CREEK
QUEMAHONING CREEK
COMPANY HOUSES
MAIN
INDEX TO SURVEYS.
LETTER | DATE OF SURVEY | SURVEYED BY | PLOTTED BY
A | July 1906 | S.E. Dickey | C.P. Collins
B | Nov 1906 | " | S.E. Dickey
C | Mar. 1907 | " | C.E.D. McLEA
D | Sept. 1907 | " | Dickey & Barclay
E | Feb. 2 1908 | " | Dickey & Barclay
F | July 1908 | " | " "
G | Nov. 1908 | " | " "
H | June 1909 | " | S.E. Dickey
Worked out portion shown thus
Direction of Air Currents
Overcasts
Letter | Date of Survey | Surveyed by | Plotted by
A | Oct. 1910 | Dry Fork | Dry Fork
B | July 1911 | " | "
C | July 1912 | " | "