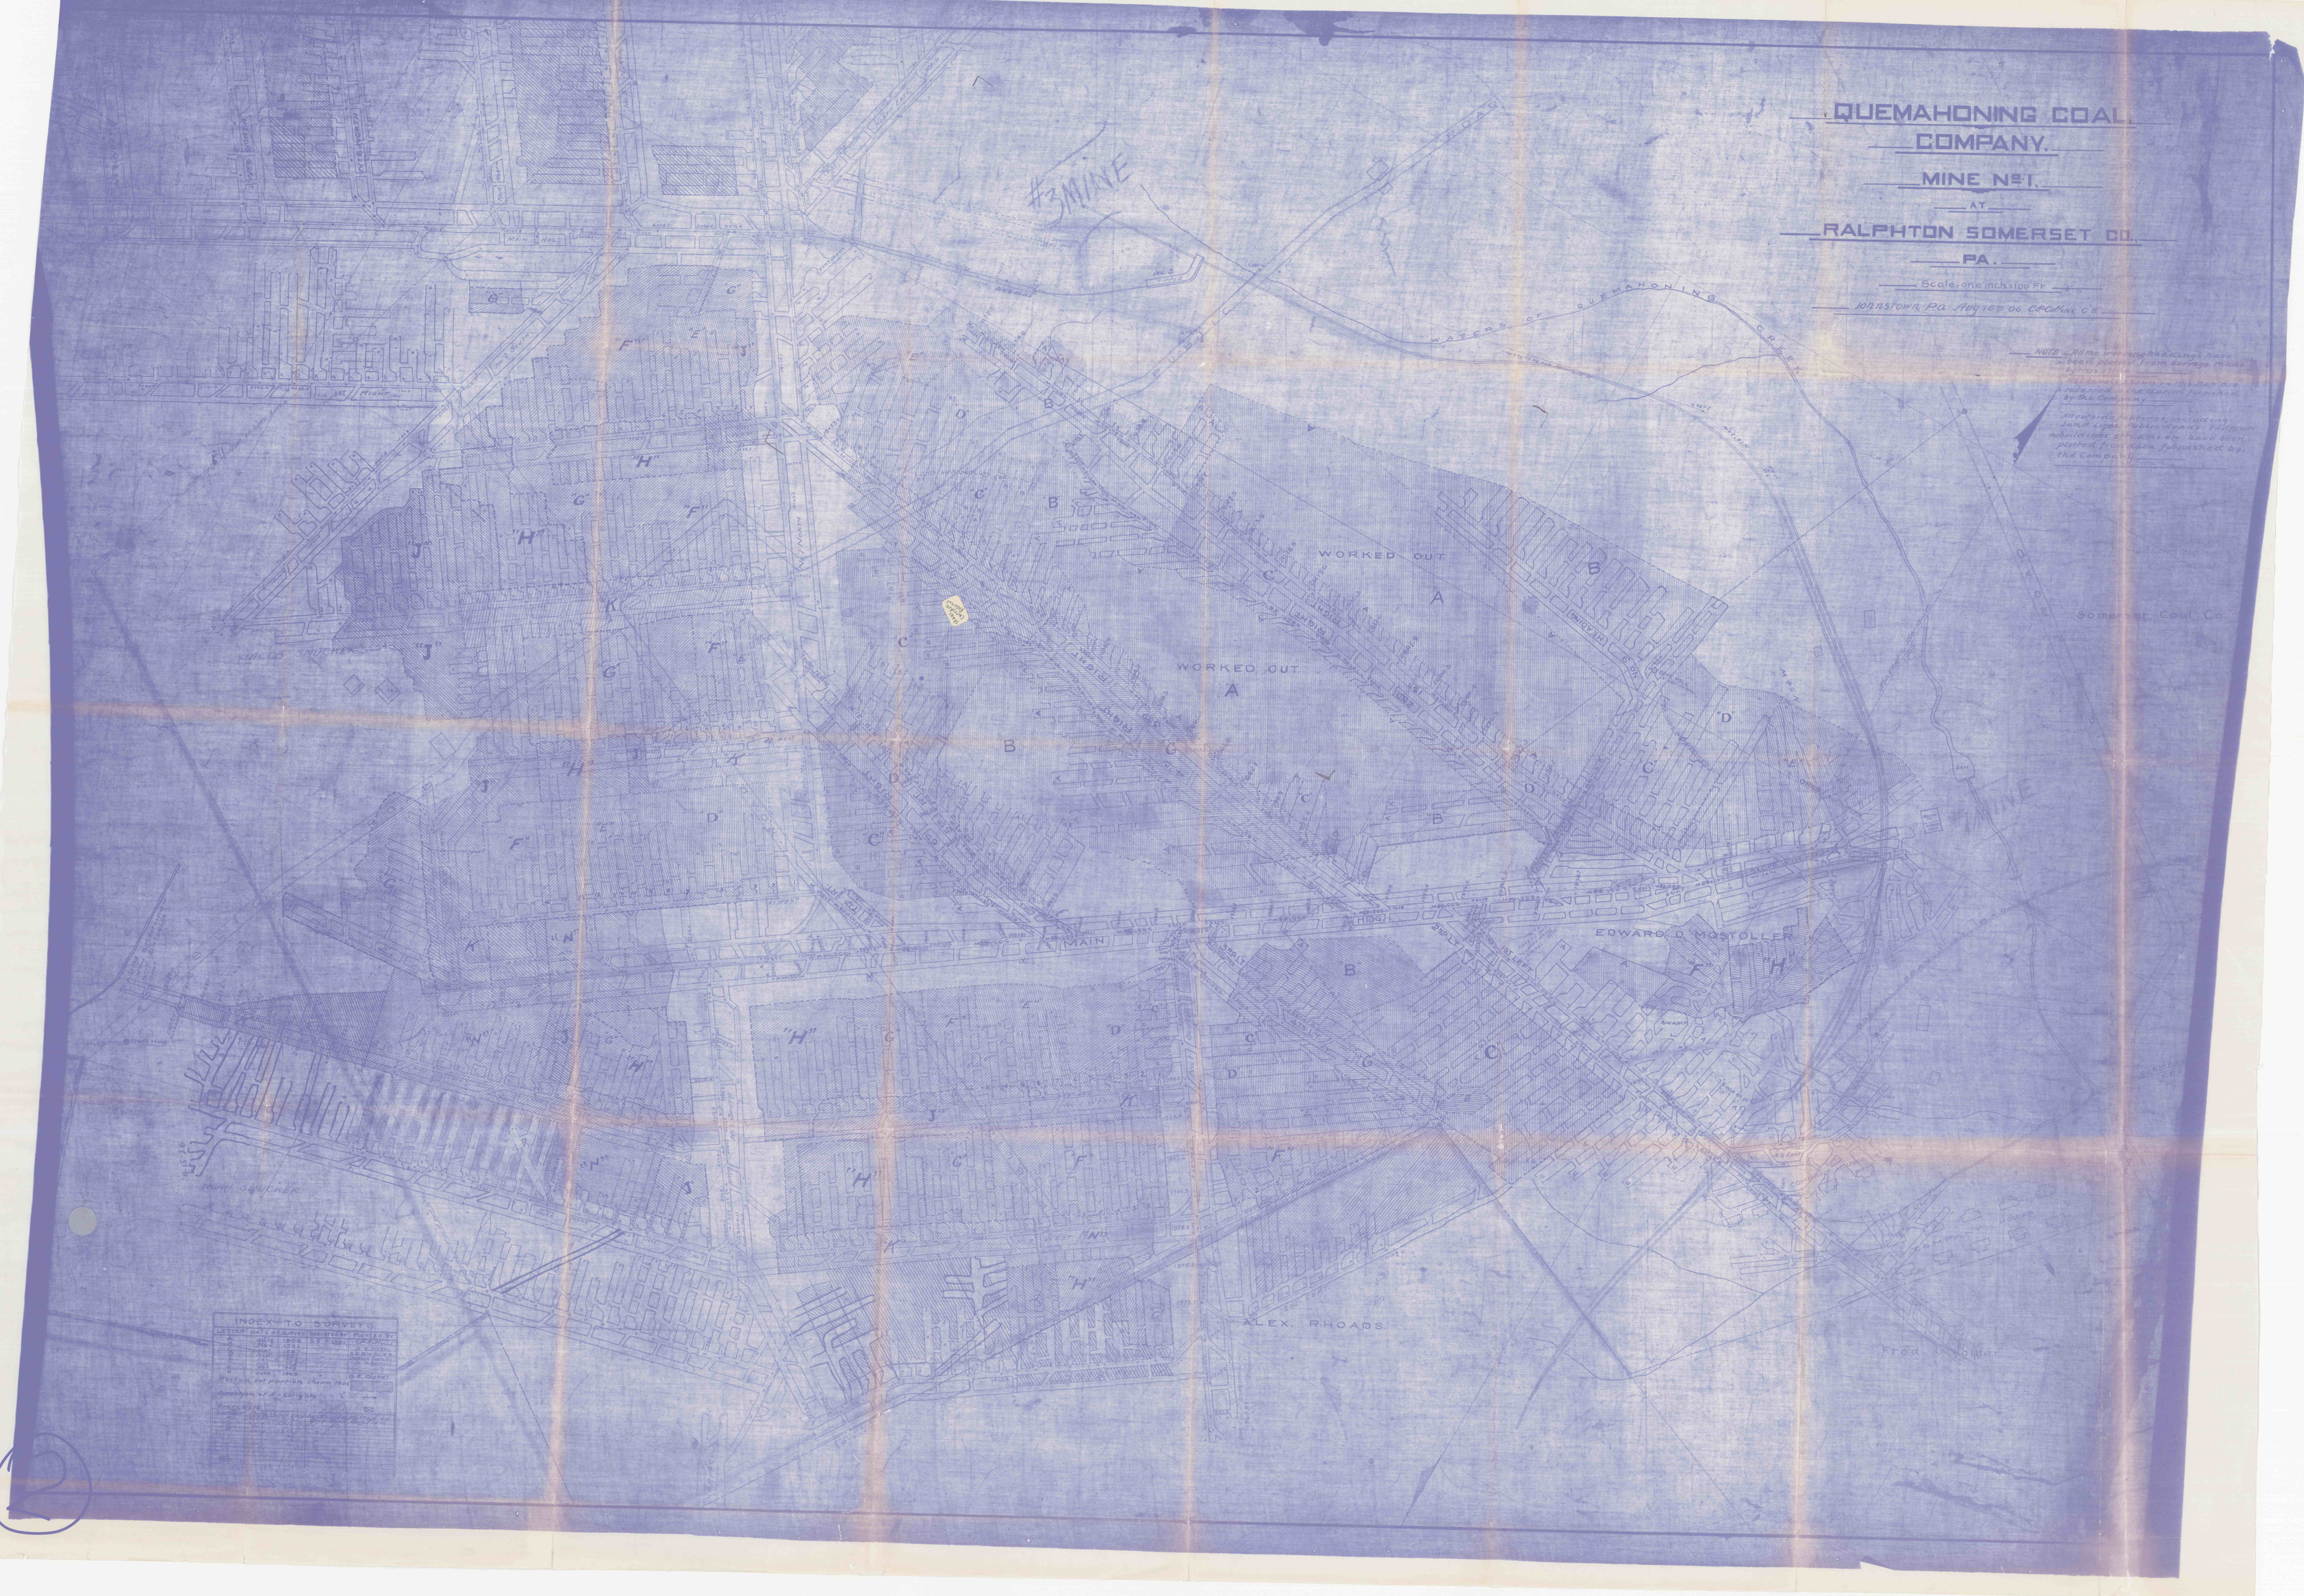
QUEMAHONING COAL COMPANY.
MINE No. 1.
AT
RALPHTON SOMERSET CO.
PA.
Scale: one inch = 100 Ft.
Johnstown, Pa. Aug 10th '06. E.P. Cox C.E.
NOTE - All the workings shown have been plotted from surveys made by the Company.
All surface features, contours and land lines, public roads, railroads, buildings, houses etc. have been plotted from data furnished by the Company.
WORKED OUT
A
WORKED OUT
A
B
C
D
E
F
G
H
J
K
N
MAIN
EDWARD D. MOSTOLLER
ALEX. RHOADS
Somerset Coal Co.
Fred Miller
INDEX TO SURVEYS
LETTER | DATE | SURVEYOR | PLOTTED BY
A | JULY 1906 | S.E. DIPPY | S.E. DIPPY
B | JULY 1906 | " | S.E. DIPPY
C | JULY 1906 | " | S.E. DIPPY
D | JULY 1906 | " | S.E. DIPPY
E | JUNE 1906 | " | S.E. DIPPY
F | JUNE 1906 | " | S.E. DIPPY
Workings of Aug. 1906 shown thus
Workings of Aug. 1906
Scale 1 in. = 100 ft.
Surveys made by S.E. Dippy, Aug. 1906
Surveys made by S.E. Dippy, Aug. 1906
