


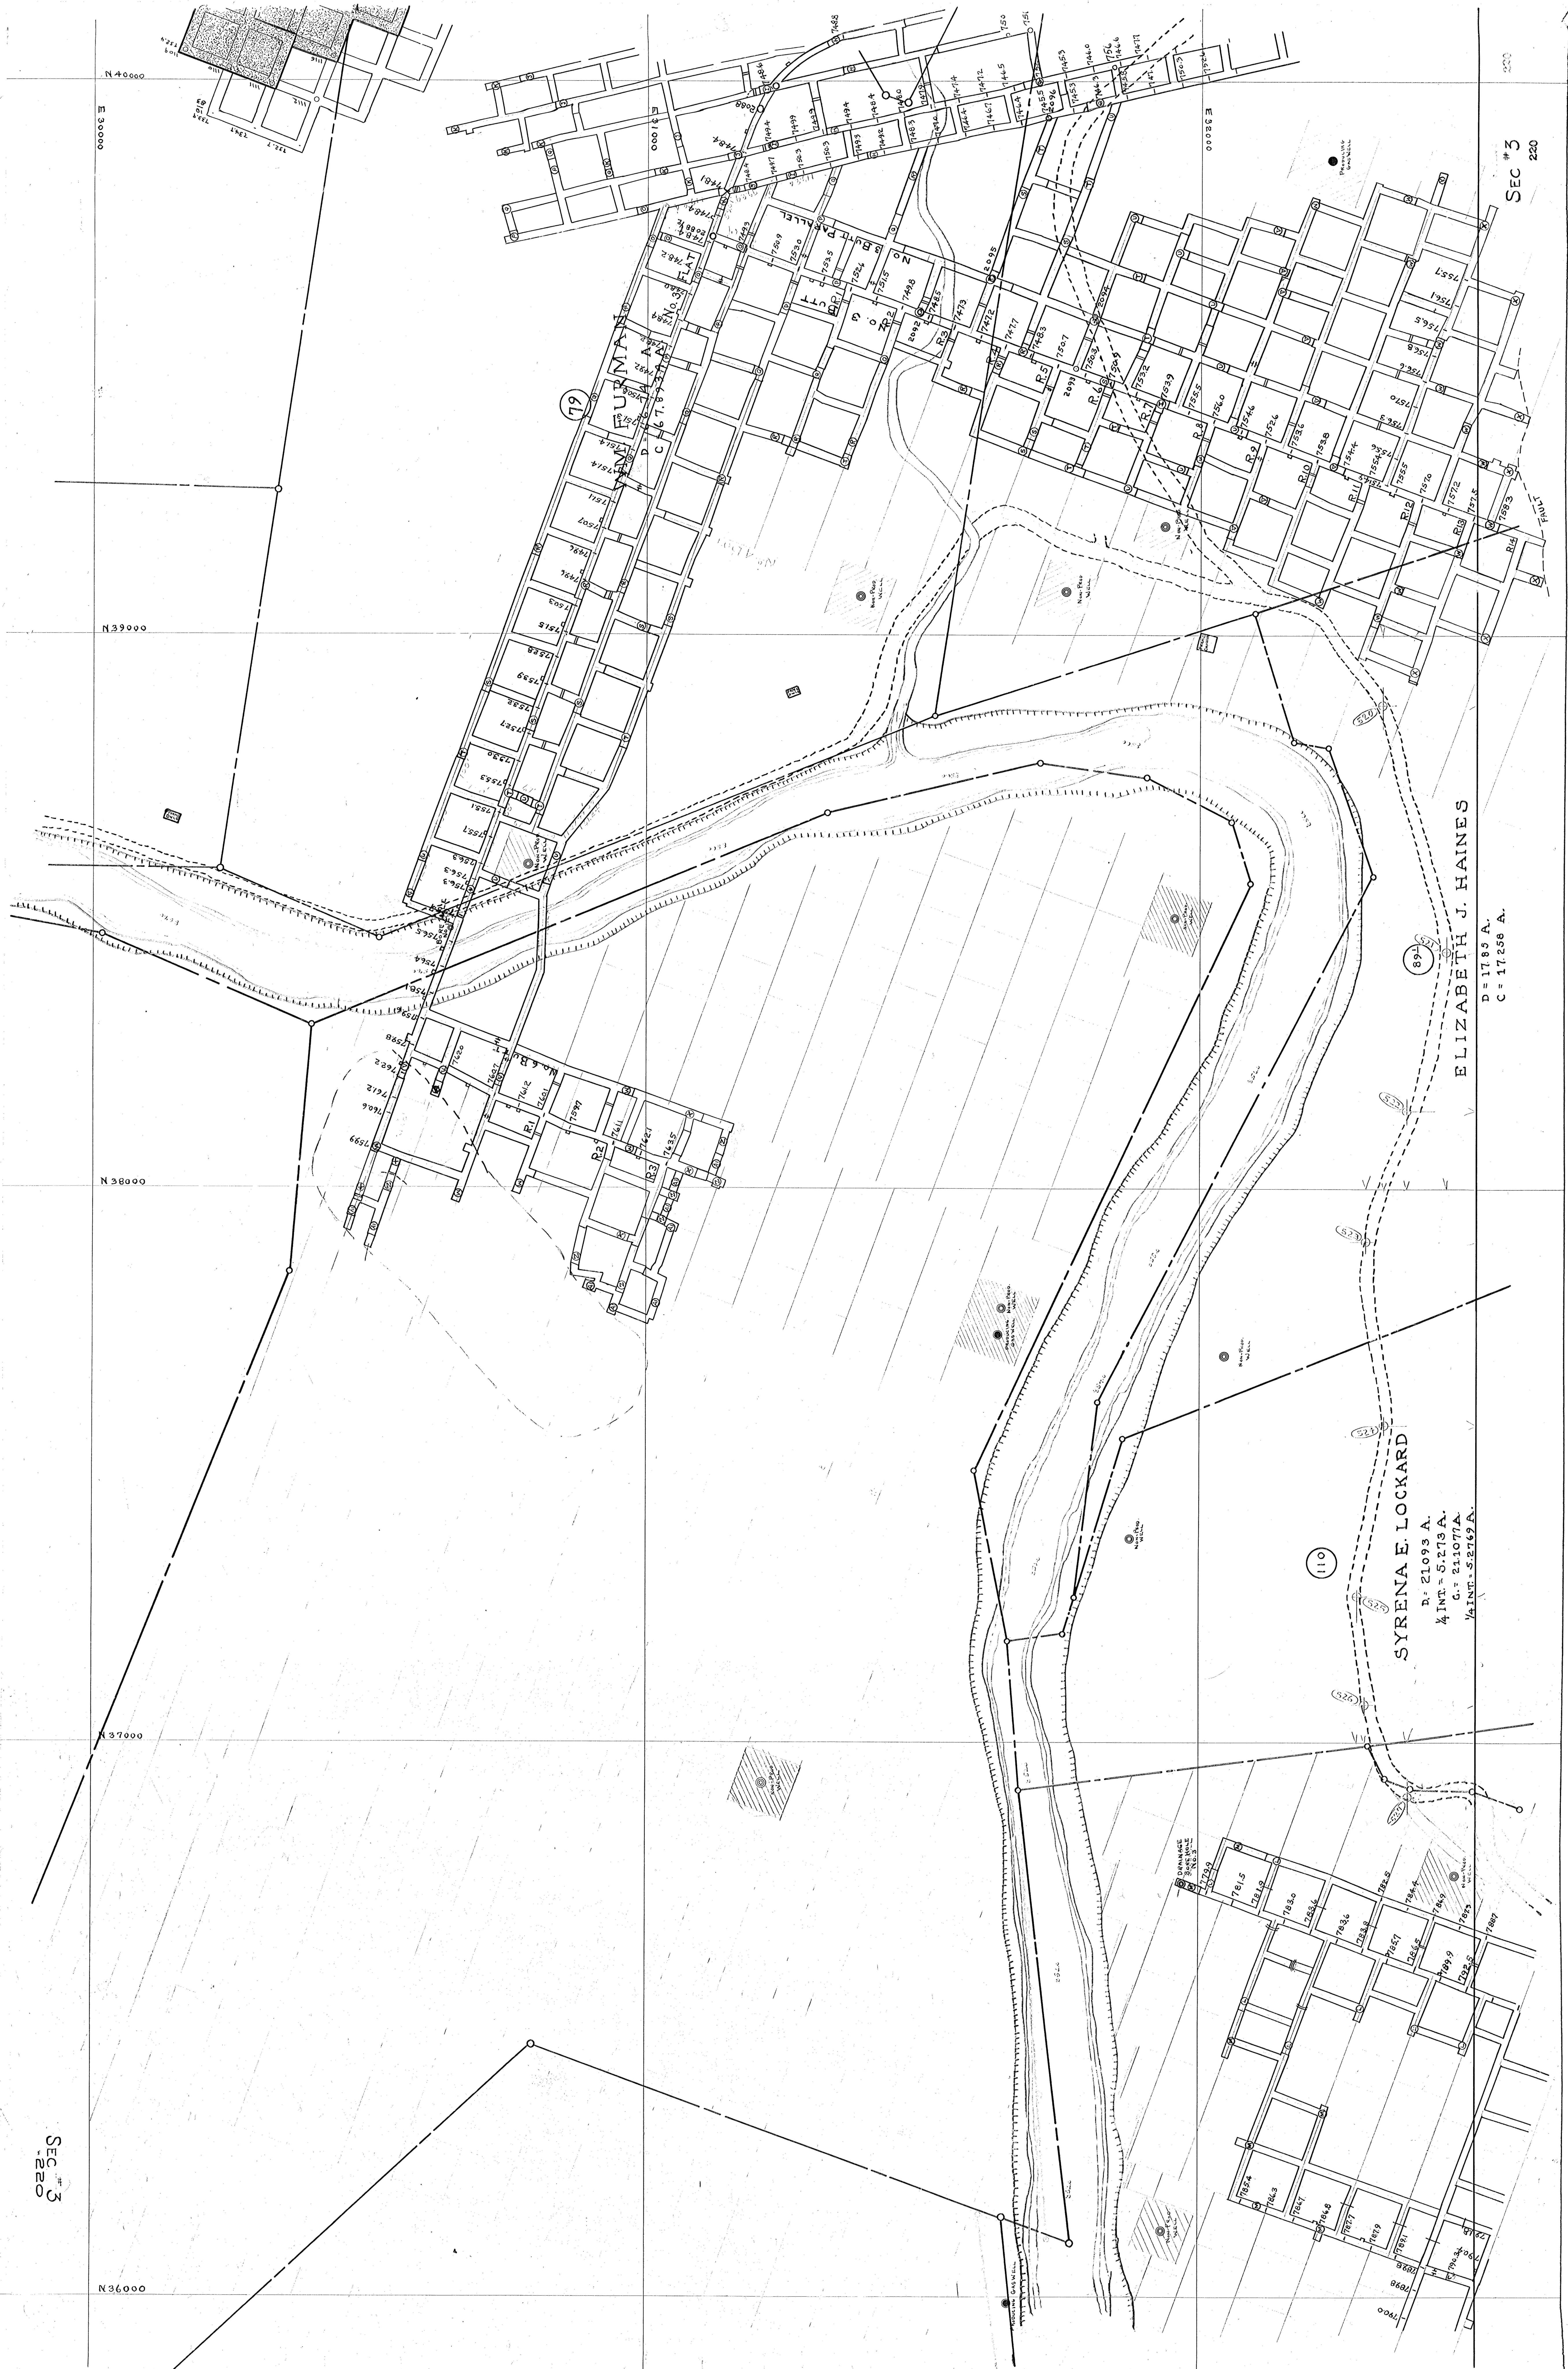

SEC #3

SEC #3

SYRENA E. LOCKARD

D. 21093 A.
1/4 INT. 52173 A.
1/4 C. 211077A.
1/4 INT. 52149 A.

ELIZABETH J. HAINES

D. 1789 A.
C. 17258 A.