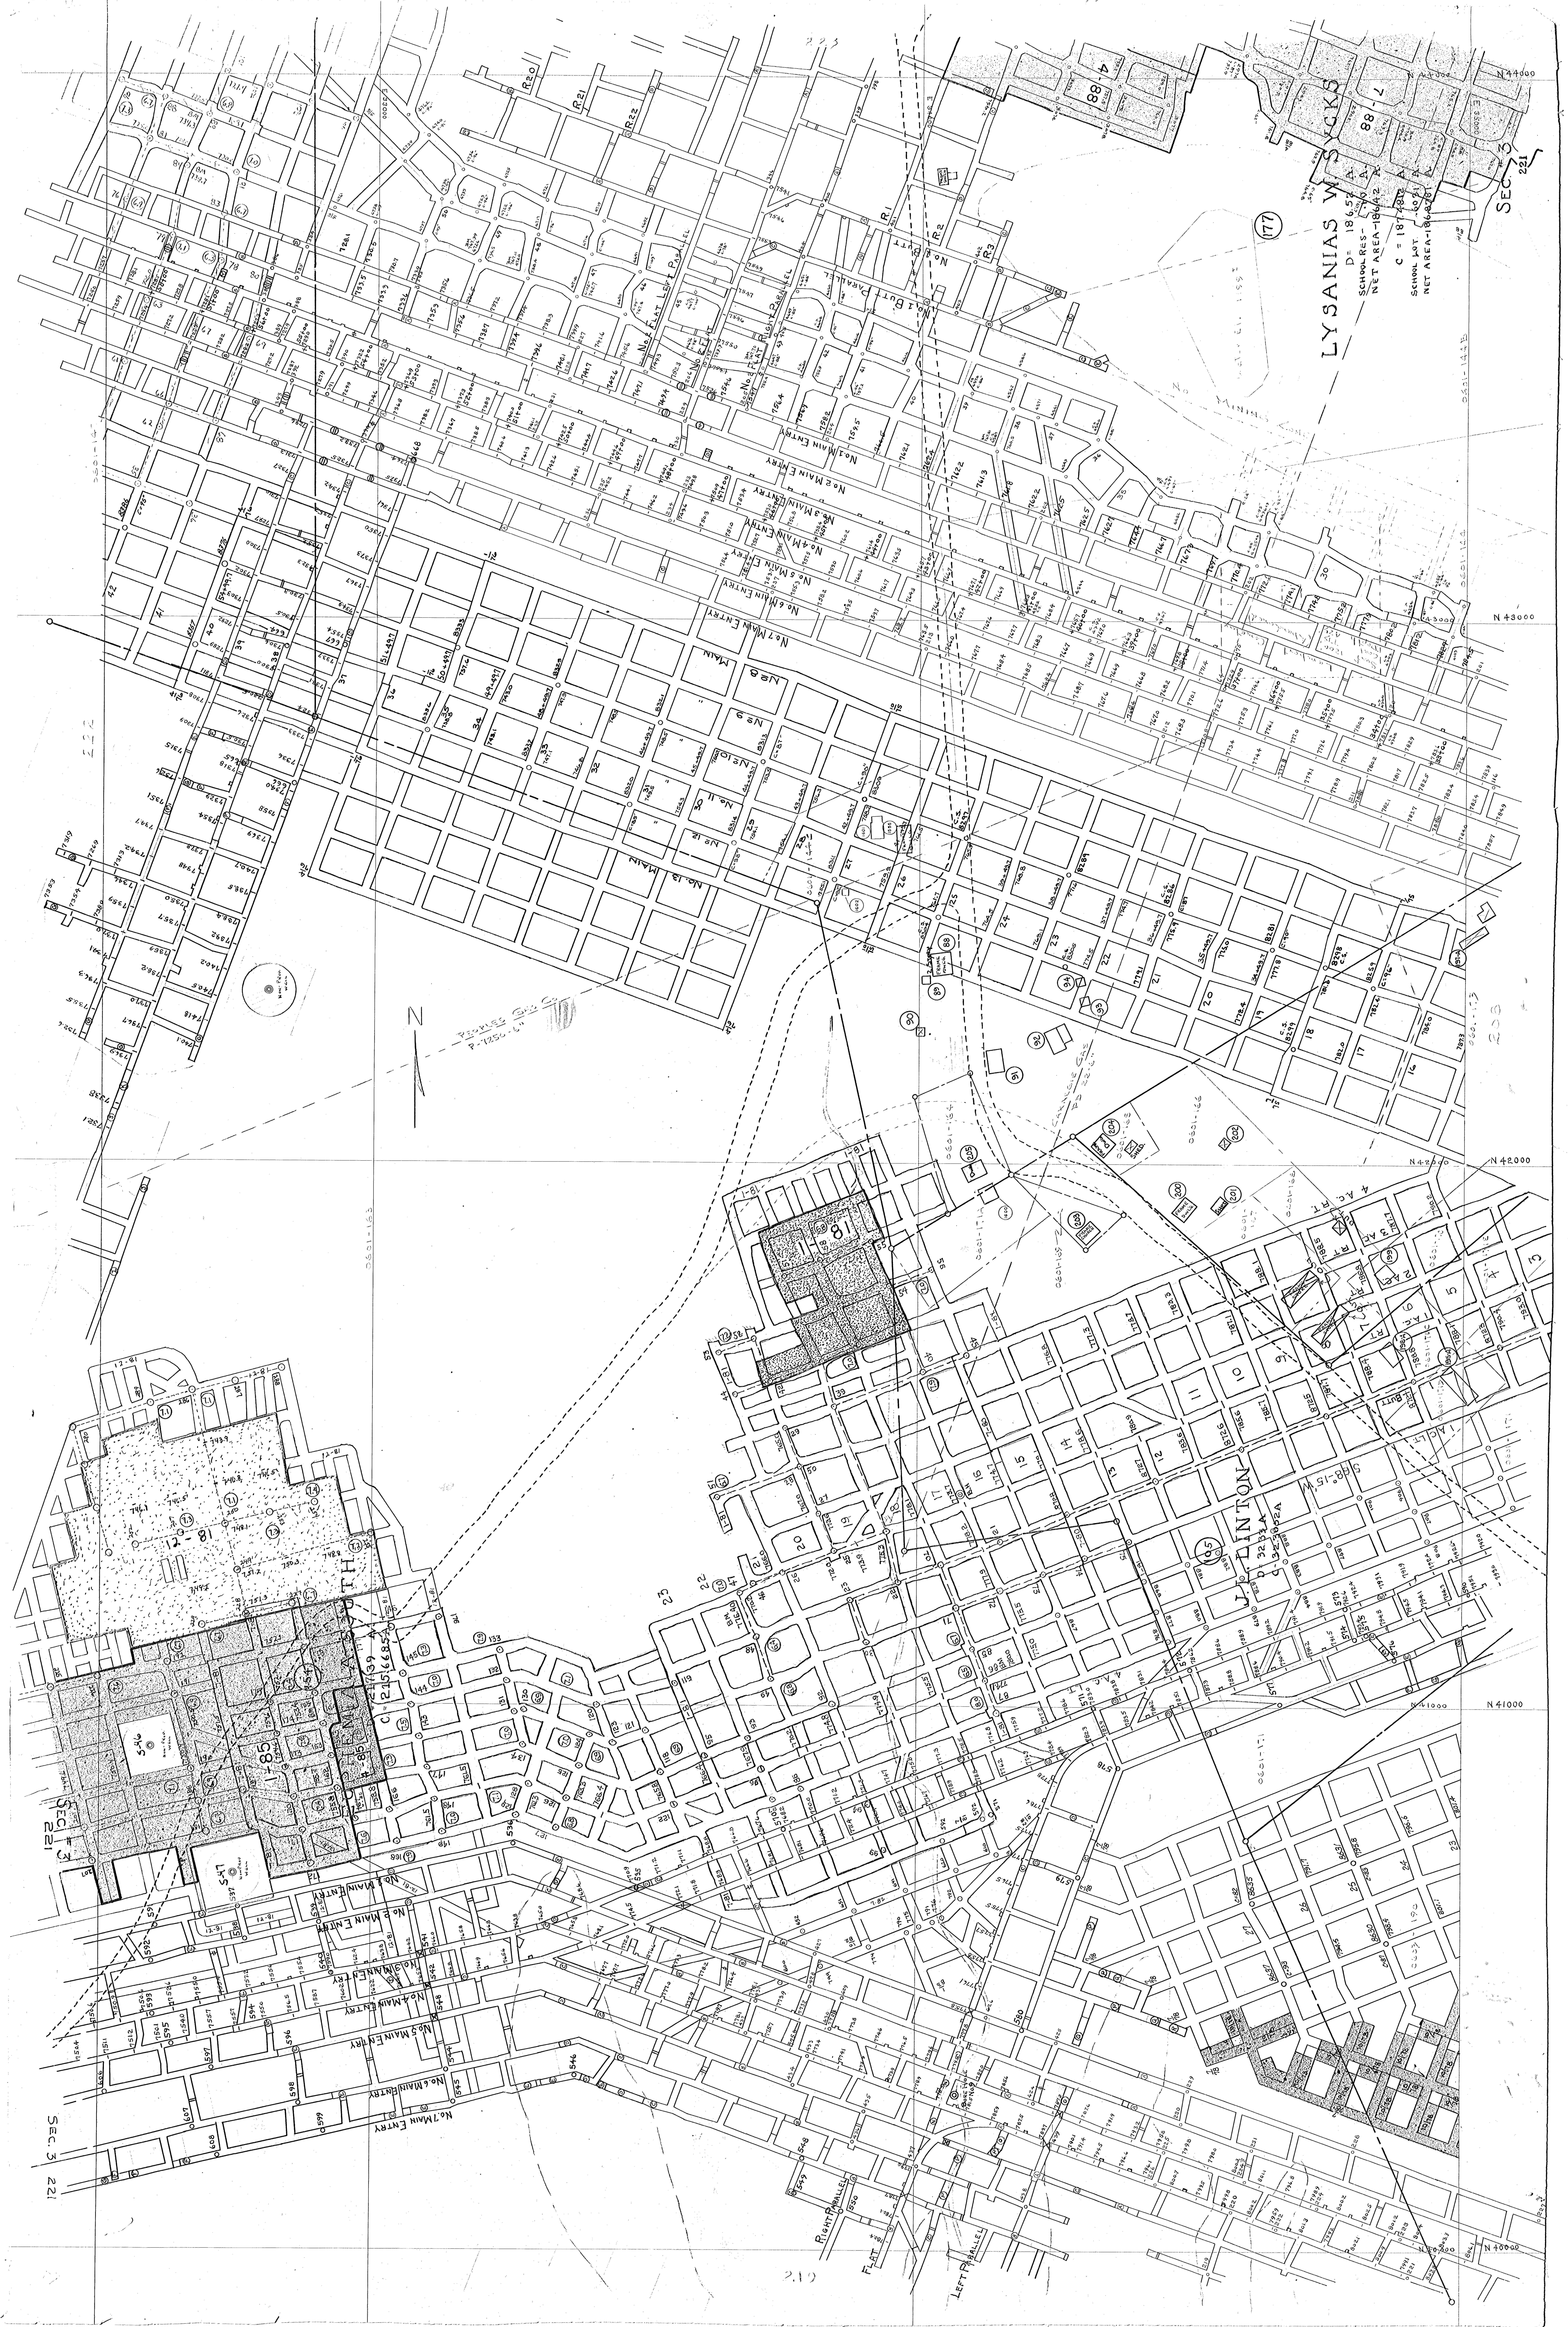
LYSANIAS W. SYCKS
D = 186.52
SCHOOL RES - 1.10
NET AREA - 186.42
C = 187.401
SCHOOL LOT - 1.0
NET AREA - 186.781
177
4-88
7-88
SEC. 3 221
N 44000
N 43000
N 42000
N 41000
N 40000
E 33000
E 35000
223
222
208
219
R.20
R.21
R.22
R.1
R.2
R.3
No.1 BUTT PARALLEL
No.1 FLAT RIGHT PARALLEL
No.2 FLAT LEFT PARALLEL
No.2 FLAT
No.1 MAIN ENTRY
No.2 MAIN ENTRY
No.3 MAIN ENTRY
No.4 MAIN ENTRY
No.5 MAIN ENTRY
No.6 MAIN ENTRY
No.7 MAIN ENTRY
No.8 MAIN
No.9
No.10
No.11
No.12
No.13 MAIN
PEOPLES GAS CO.
P-7250-6"
CARNEGIE GAS
N
NON-PROD. WELL
FRAME DWLG.
FRAME CHURCH
SHED
4 AC. RT.
3 AC. RT.
2 AC. RT.
1 AC. RT.
BUTT
J. J. LINTON
D = 323.3 A
C = 323.052 A
S 8°-15' W
1-81
12-81
4-85
1-85
S-46
S-47
C = 21.739 A
215.6685
SEC. 3 221
RIGHT PARALLEL
FLAT
LEFT PARALLEL
BORE HOLE
0601-163
0601-164
0601-165
0601-166
0601-171
0601-144
0601-144B
0601-190
2.19