


SECTION No. 4
226
E-25,000
N-25,000

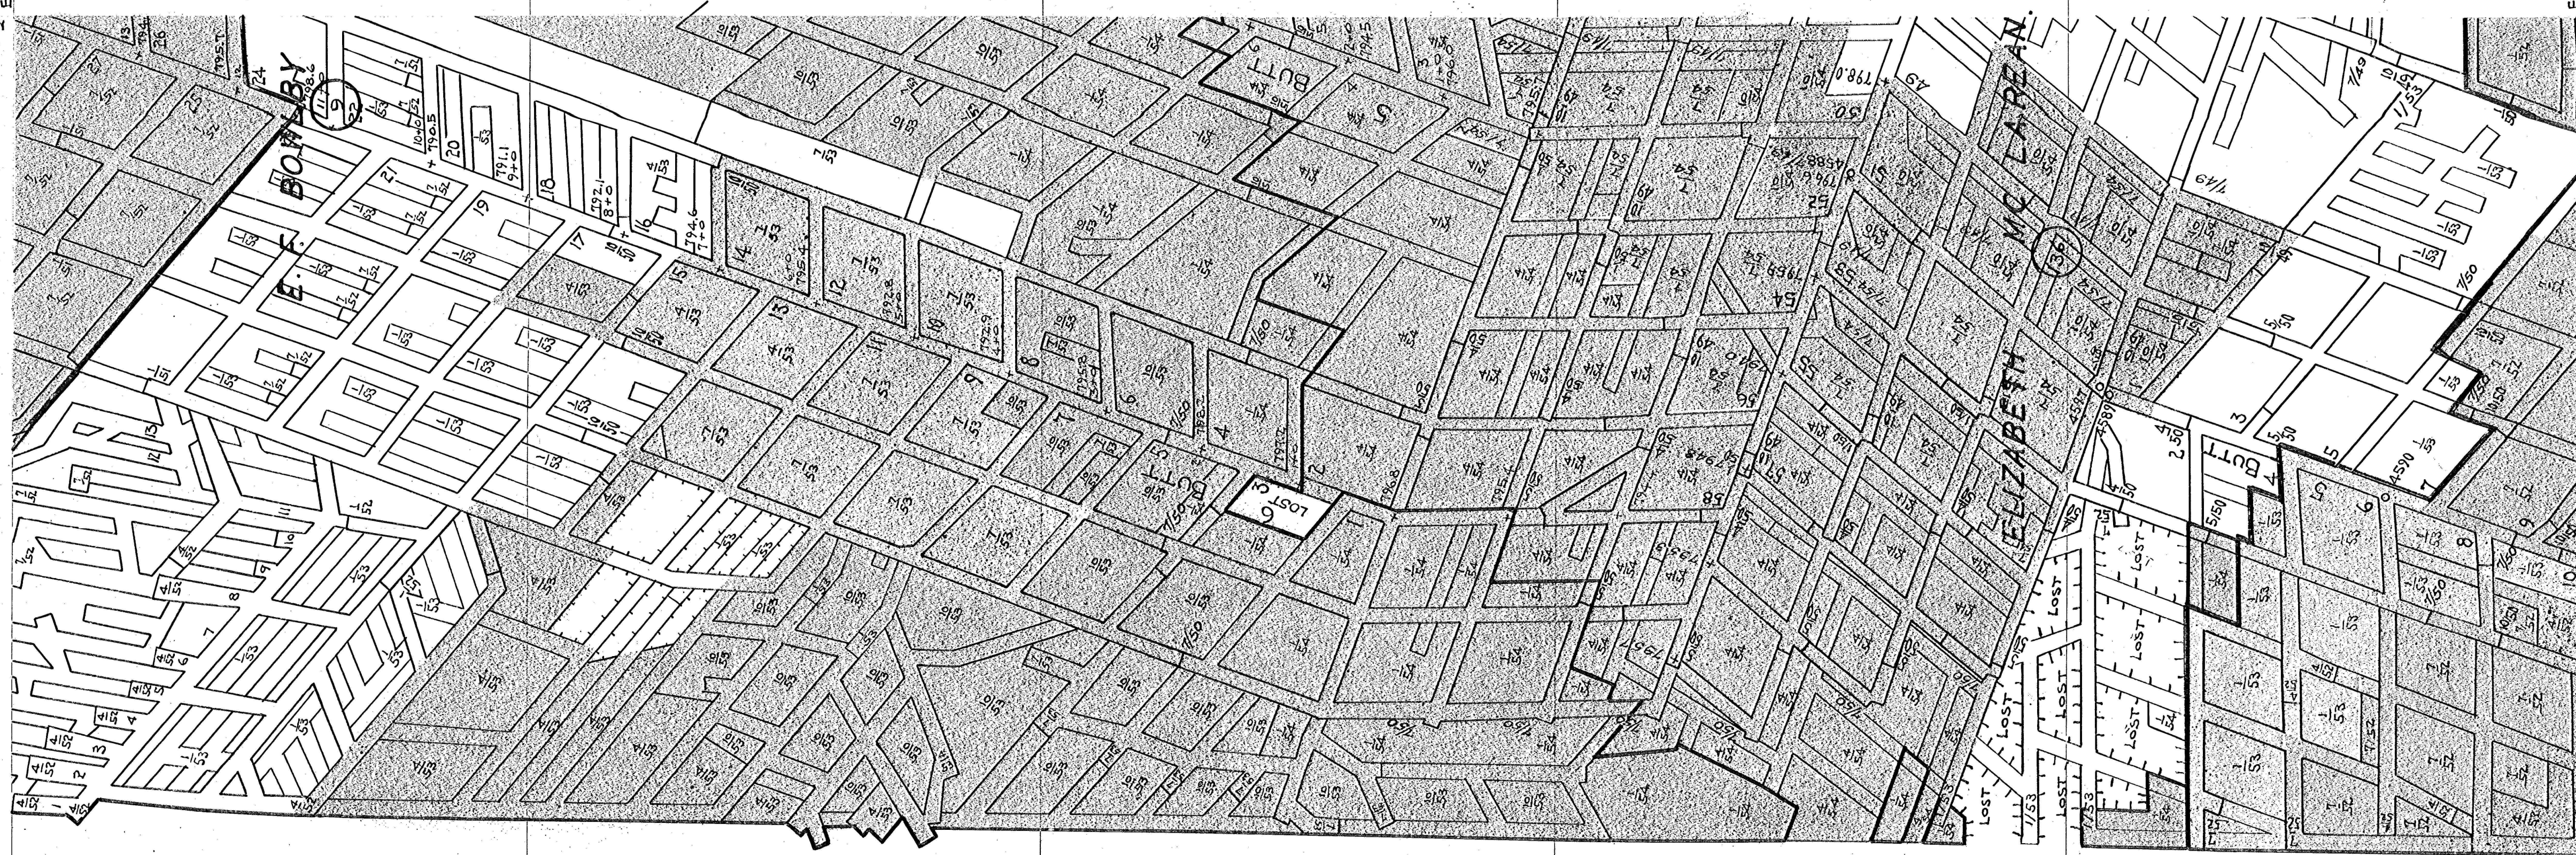

SECTION No. 4
226
E-27,500
N-27,000

SECTION No. 4
226

N-25,000

E-27,500