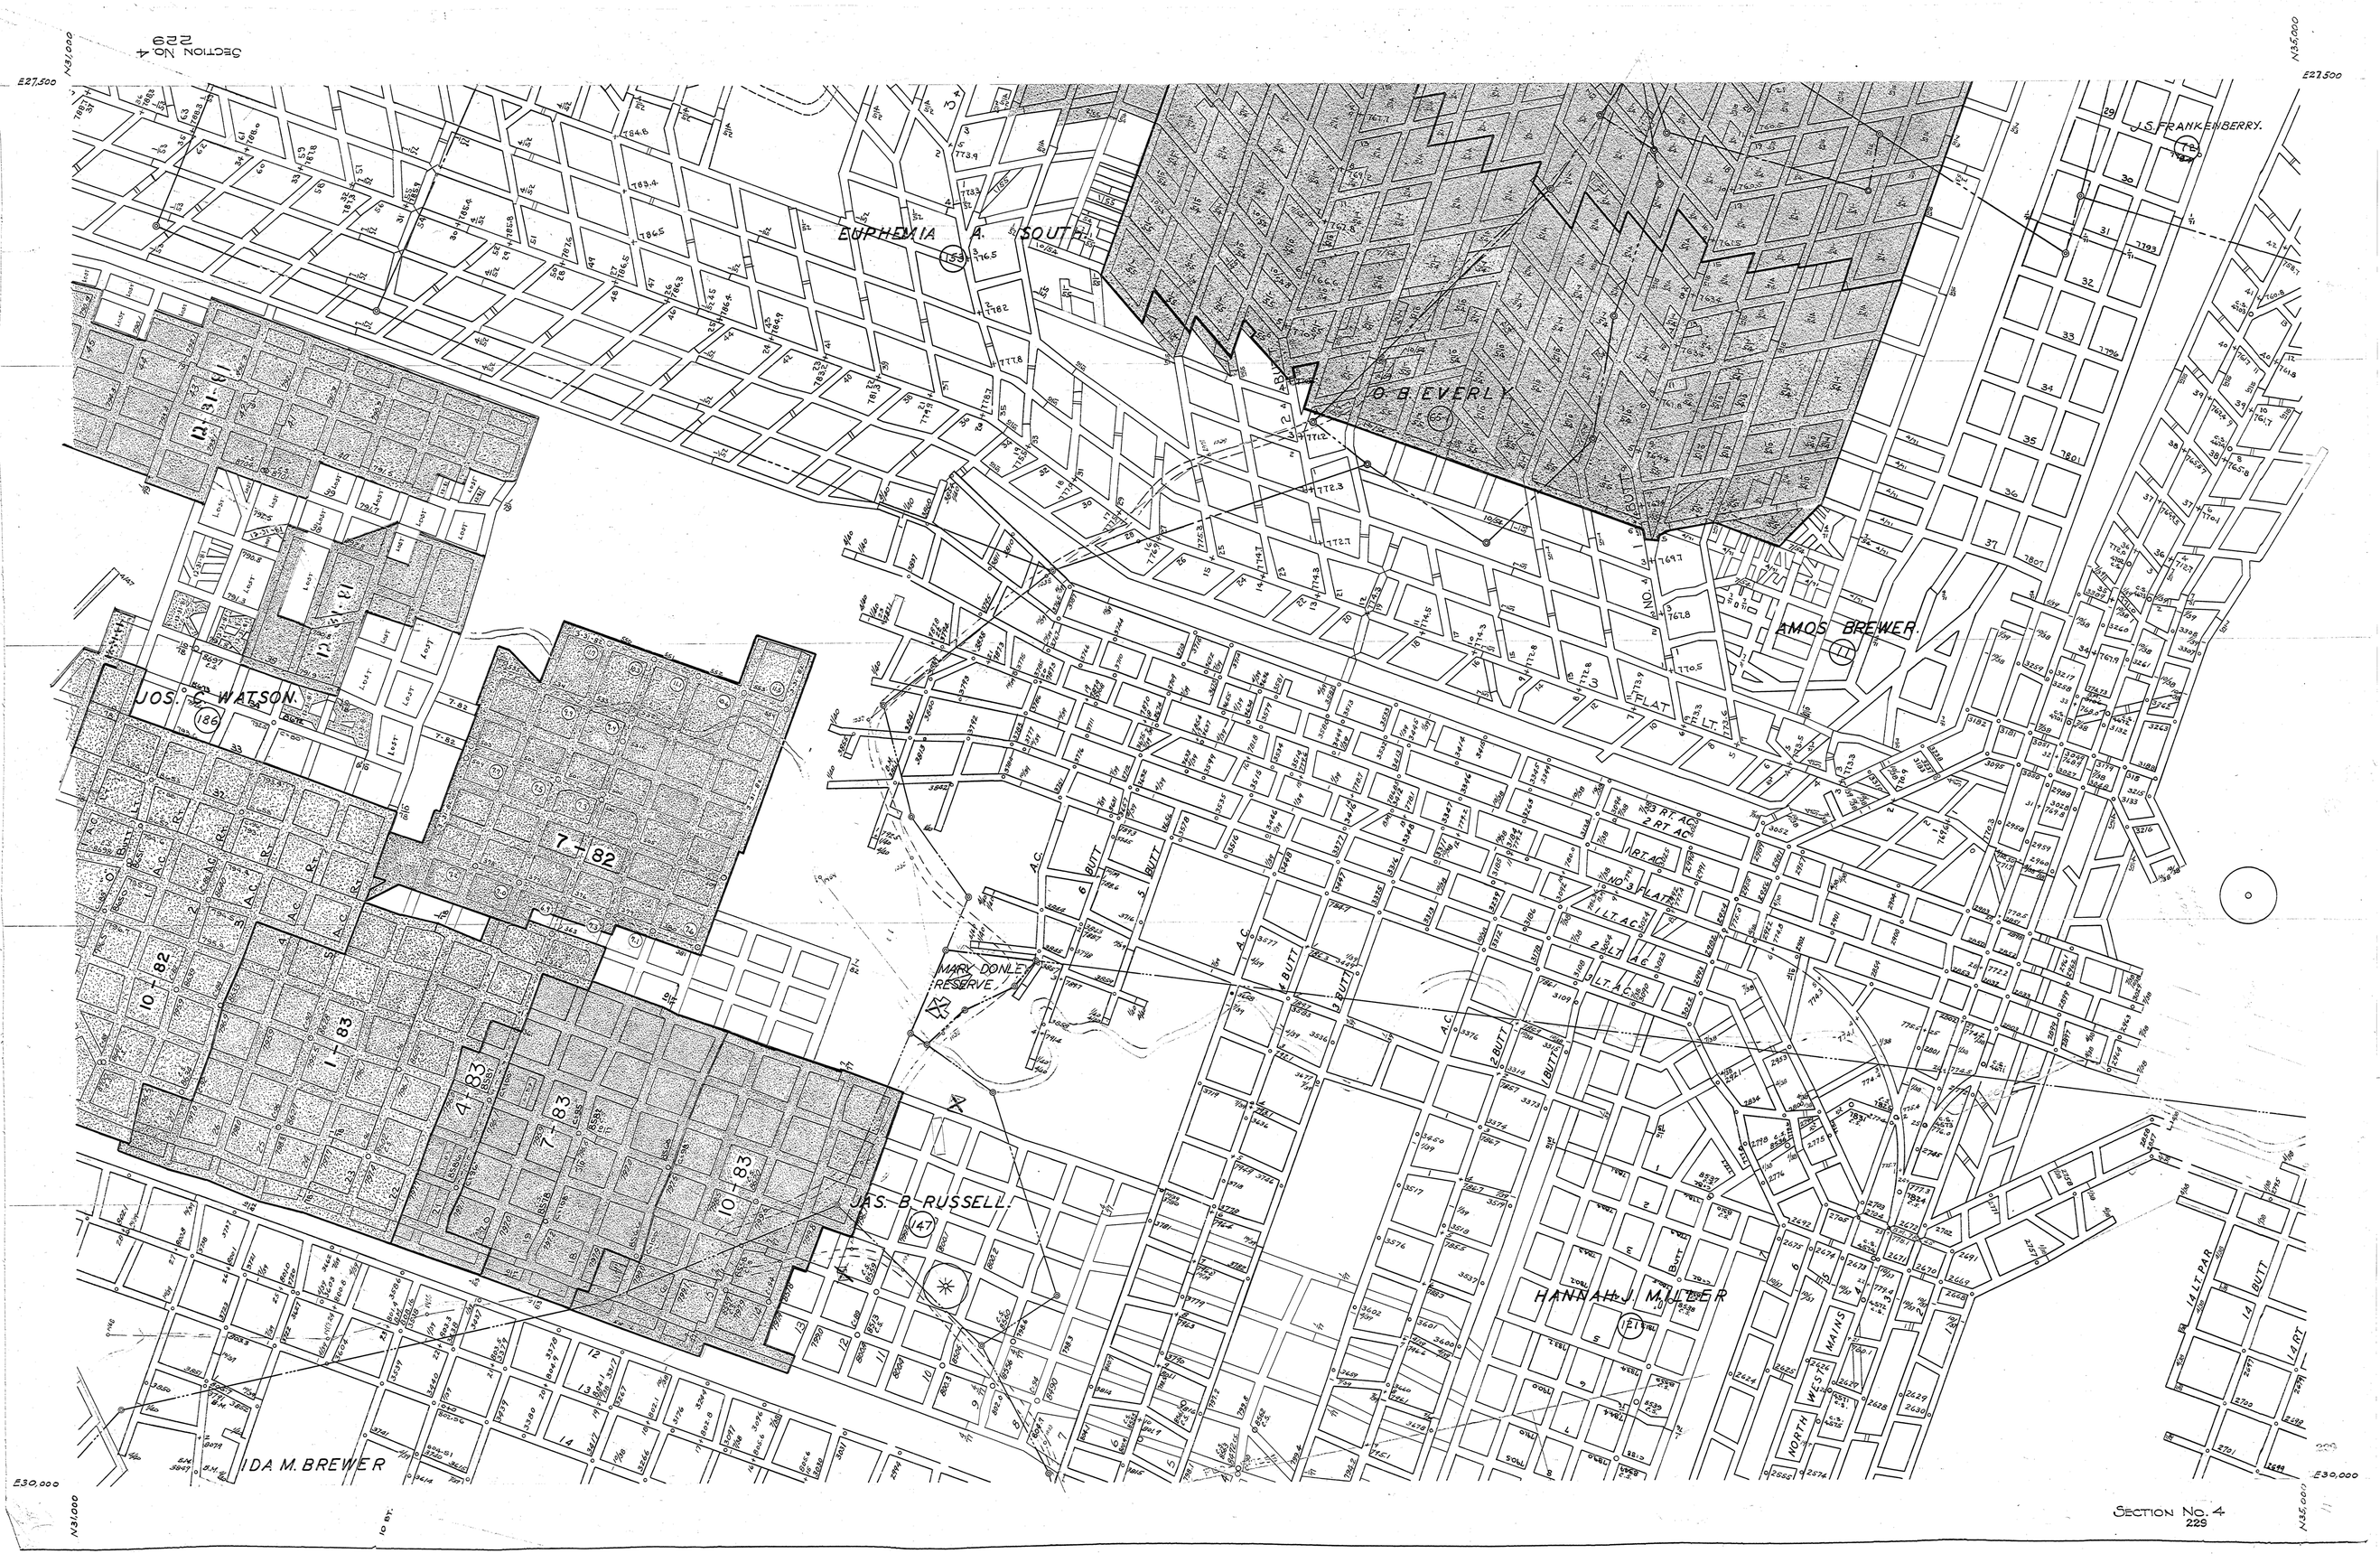
SECTION No. 4
229
E27,500
N31,000
N35,000
E30,000
EUPHEMIA A. SOUTH
O. B. EVERLY
J. S. FRANKENBERRY
AMOS BREWER
JOS. C. WATSON
MARY DONLEY RESERVE
JAS. B. RUSSELL
HANNAH J. MILLER
IDA M. BREWER
NORTH WEST MAINS
7-82
10-82
1-83
4-83
7-83
10-83
12-31-81
SECTION No. 4
229