
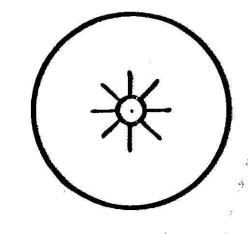



22

SECTION No. 6
235

E 25500

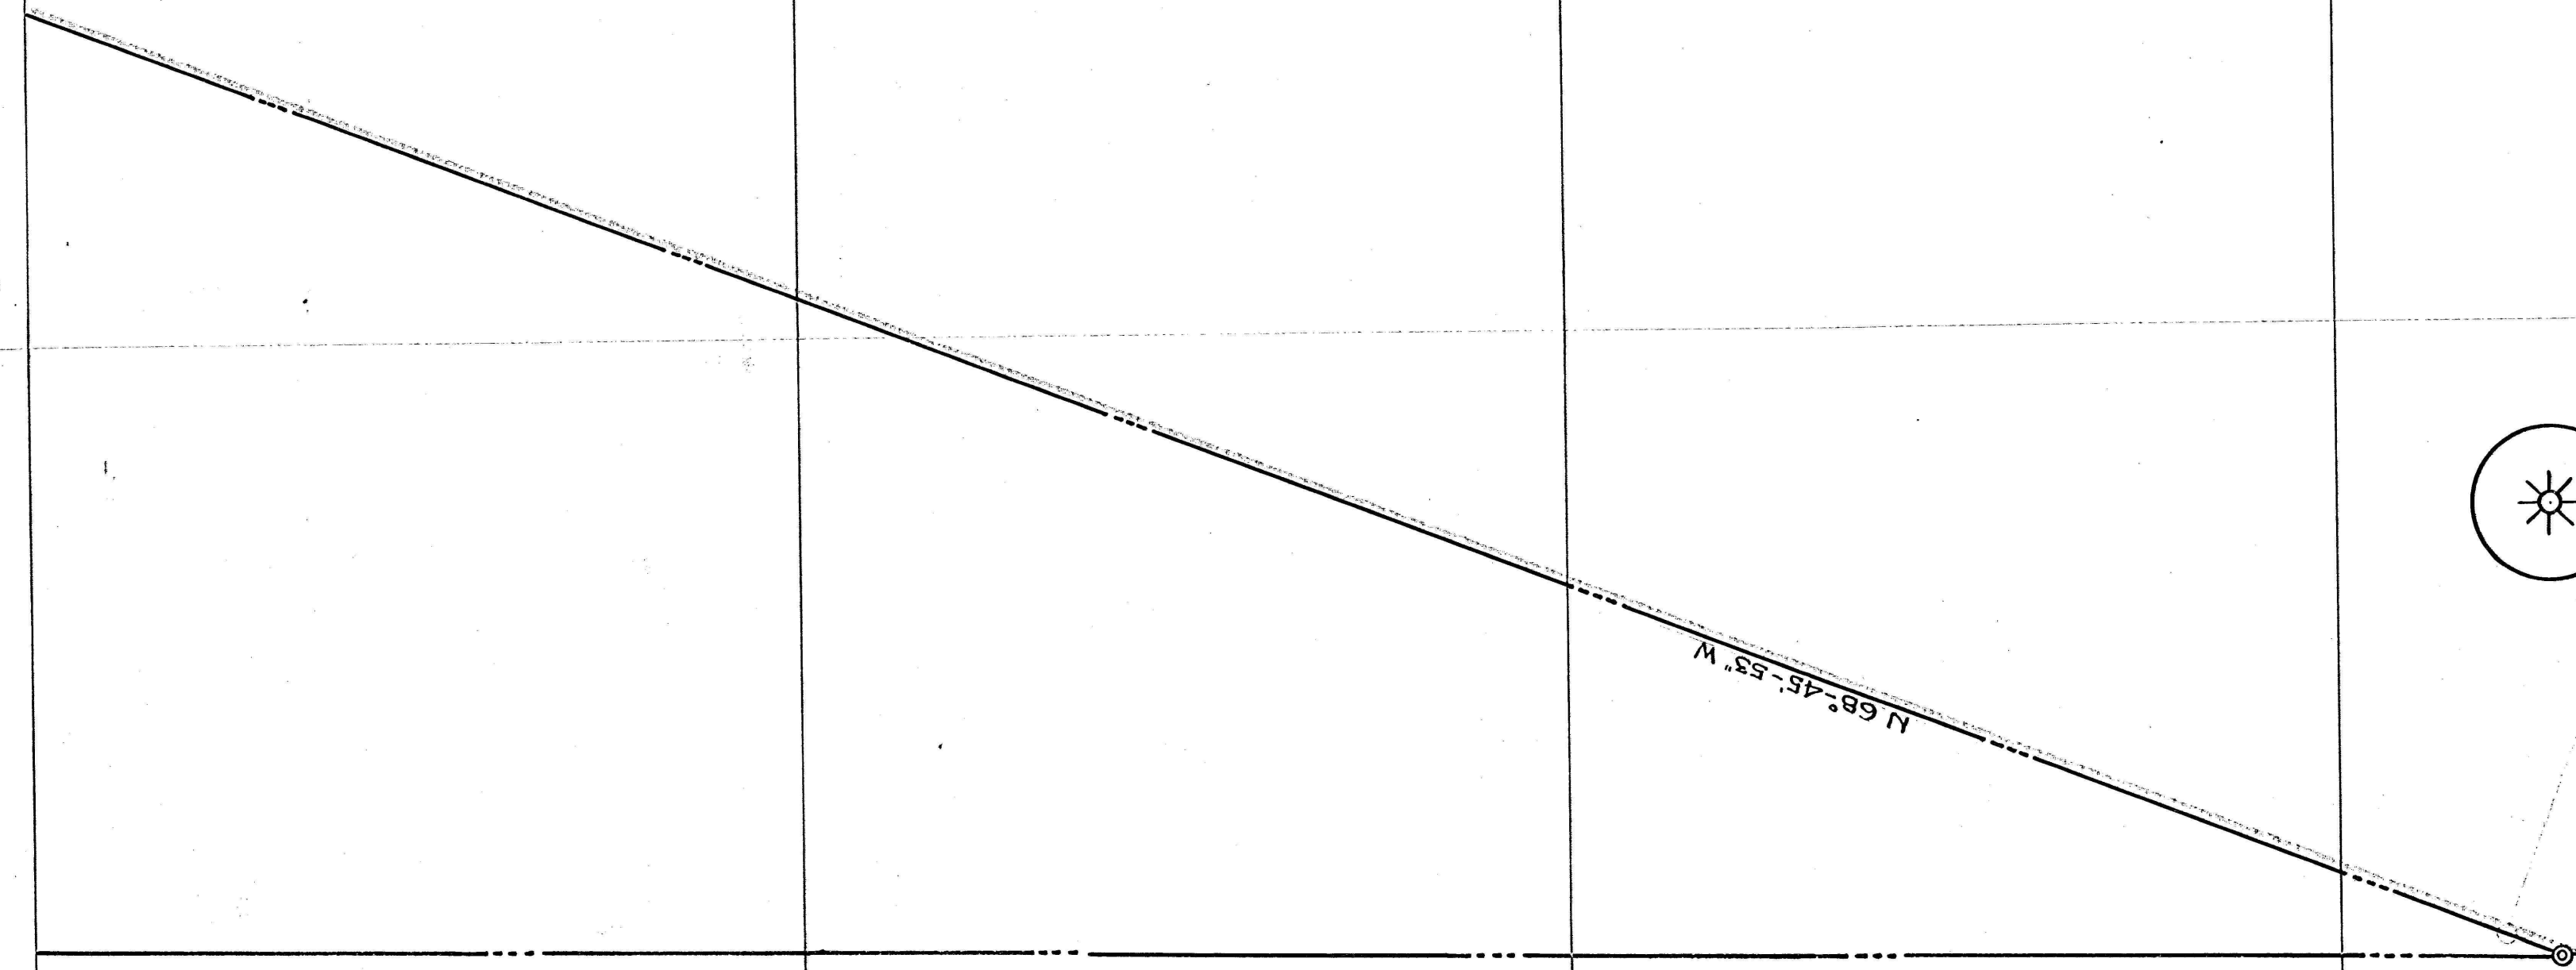

E. F. BOWLER
9

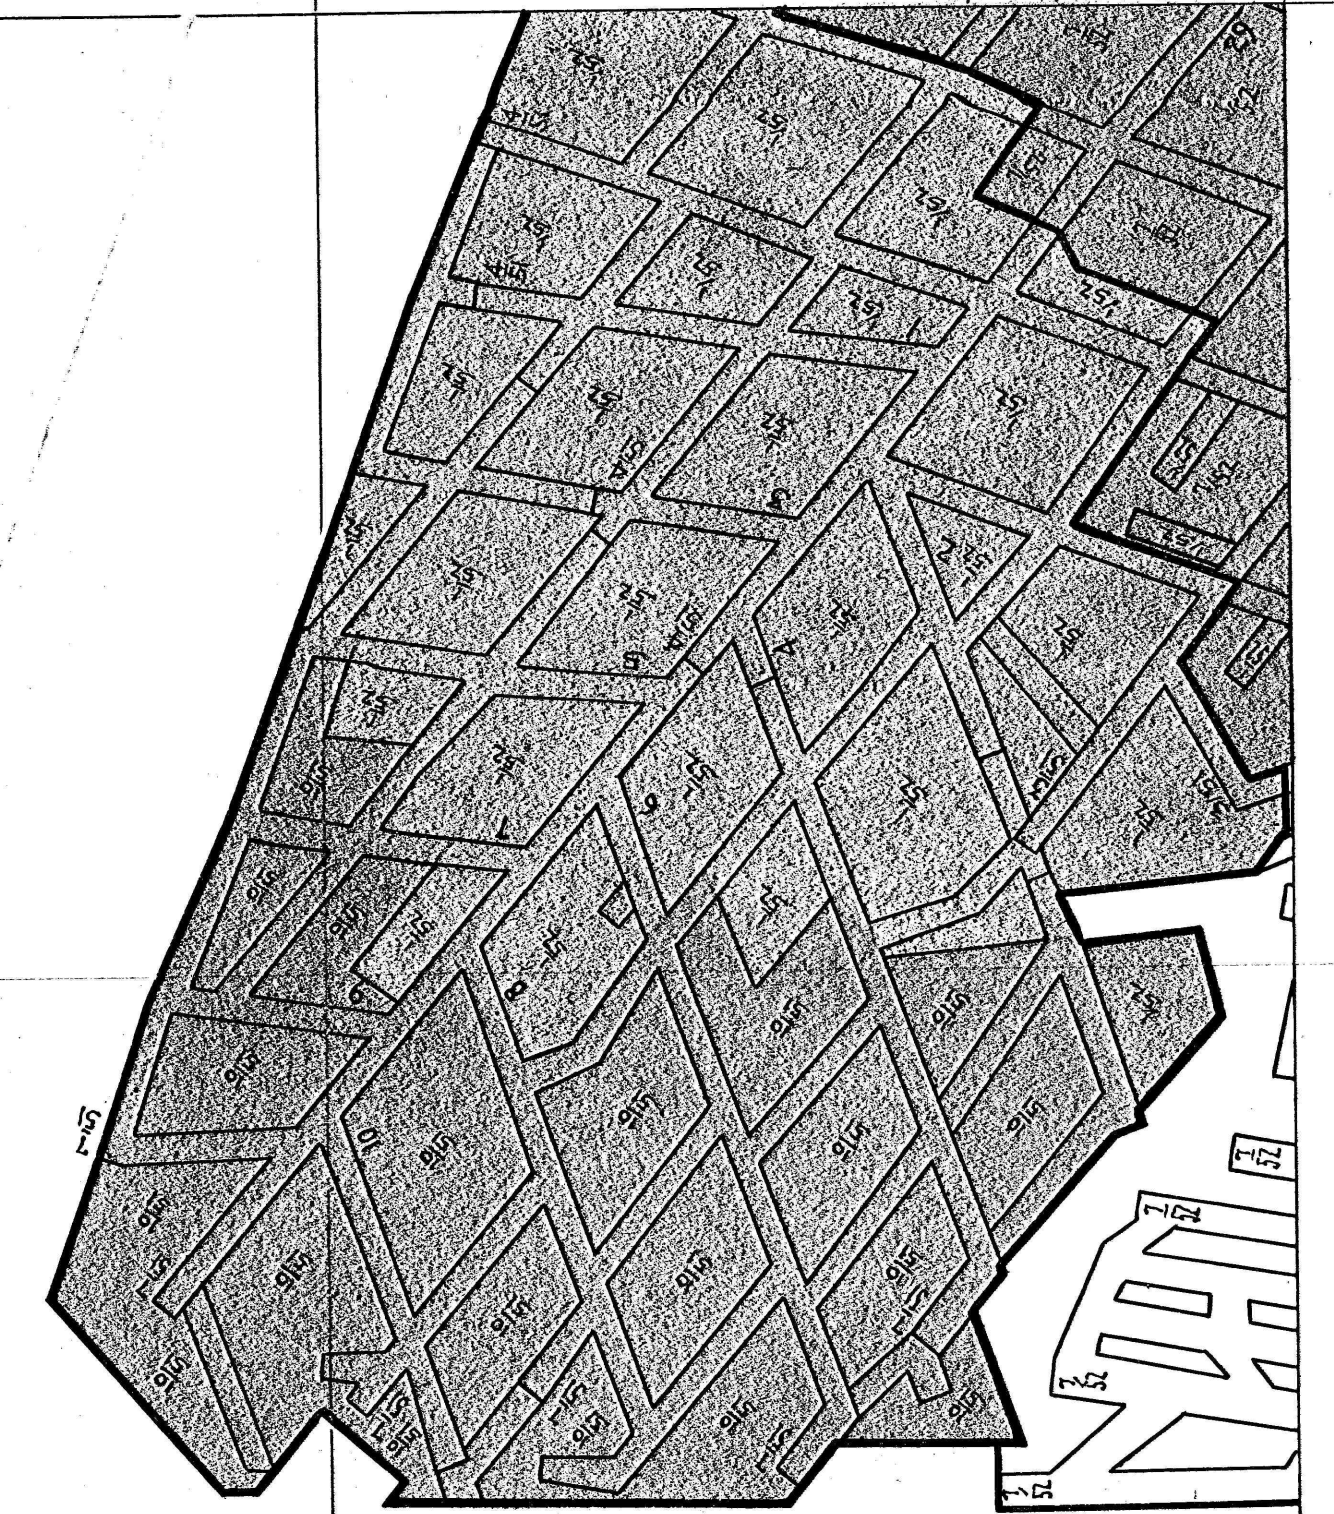

filmed

E 25500

N - 25500

SECTION No. 6
235

N - 25500

235