


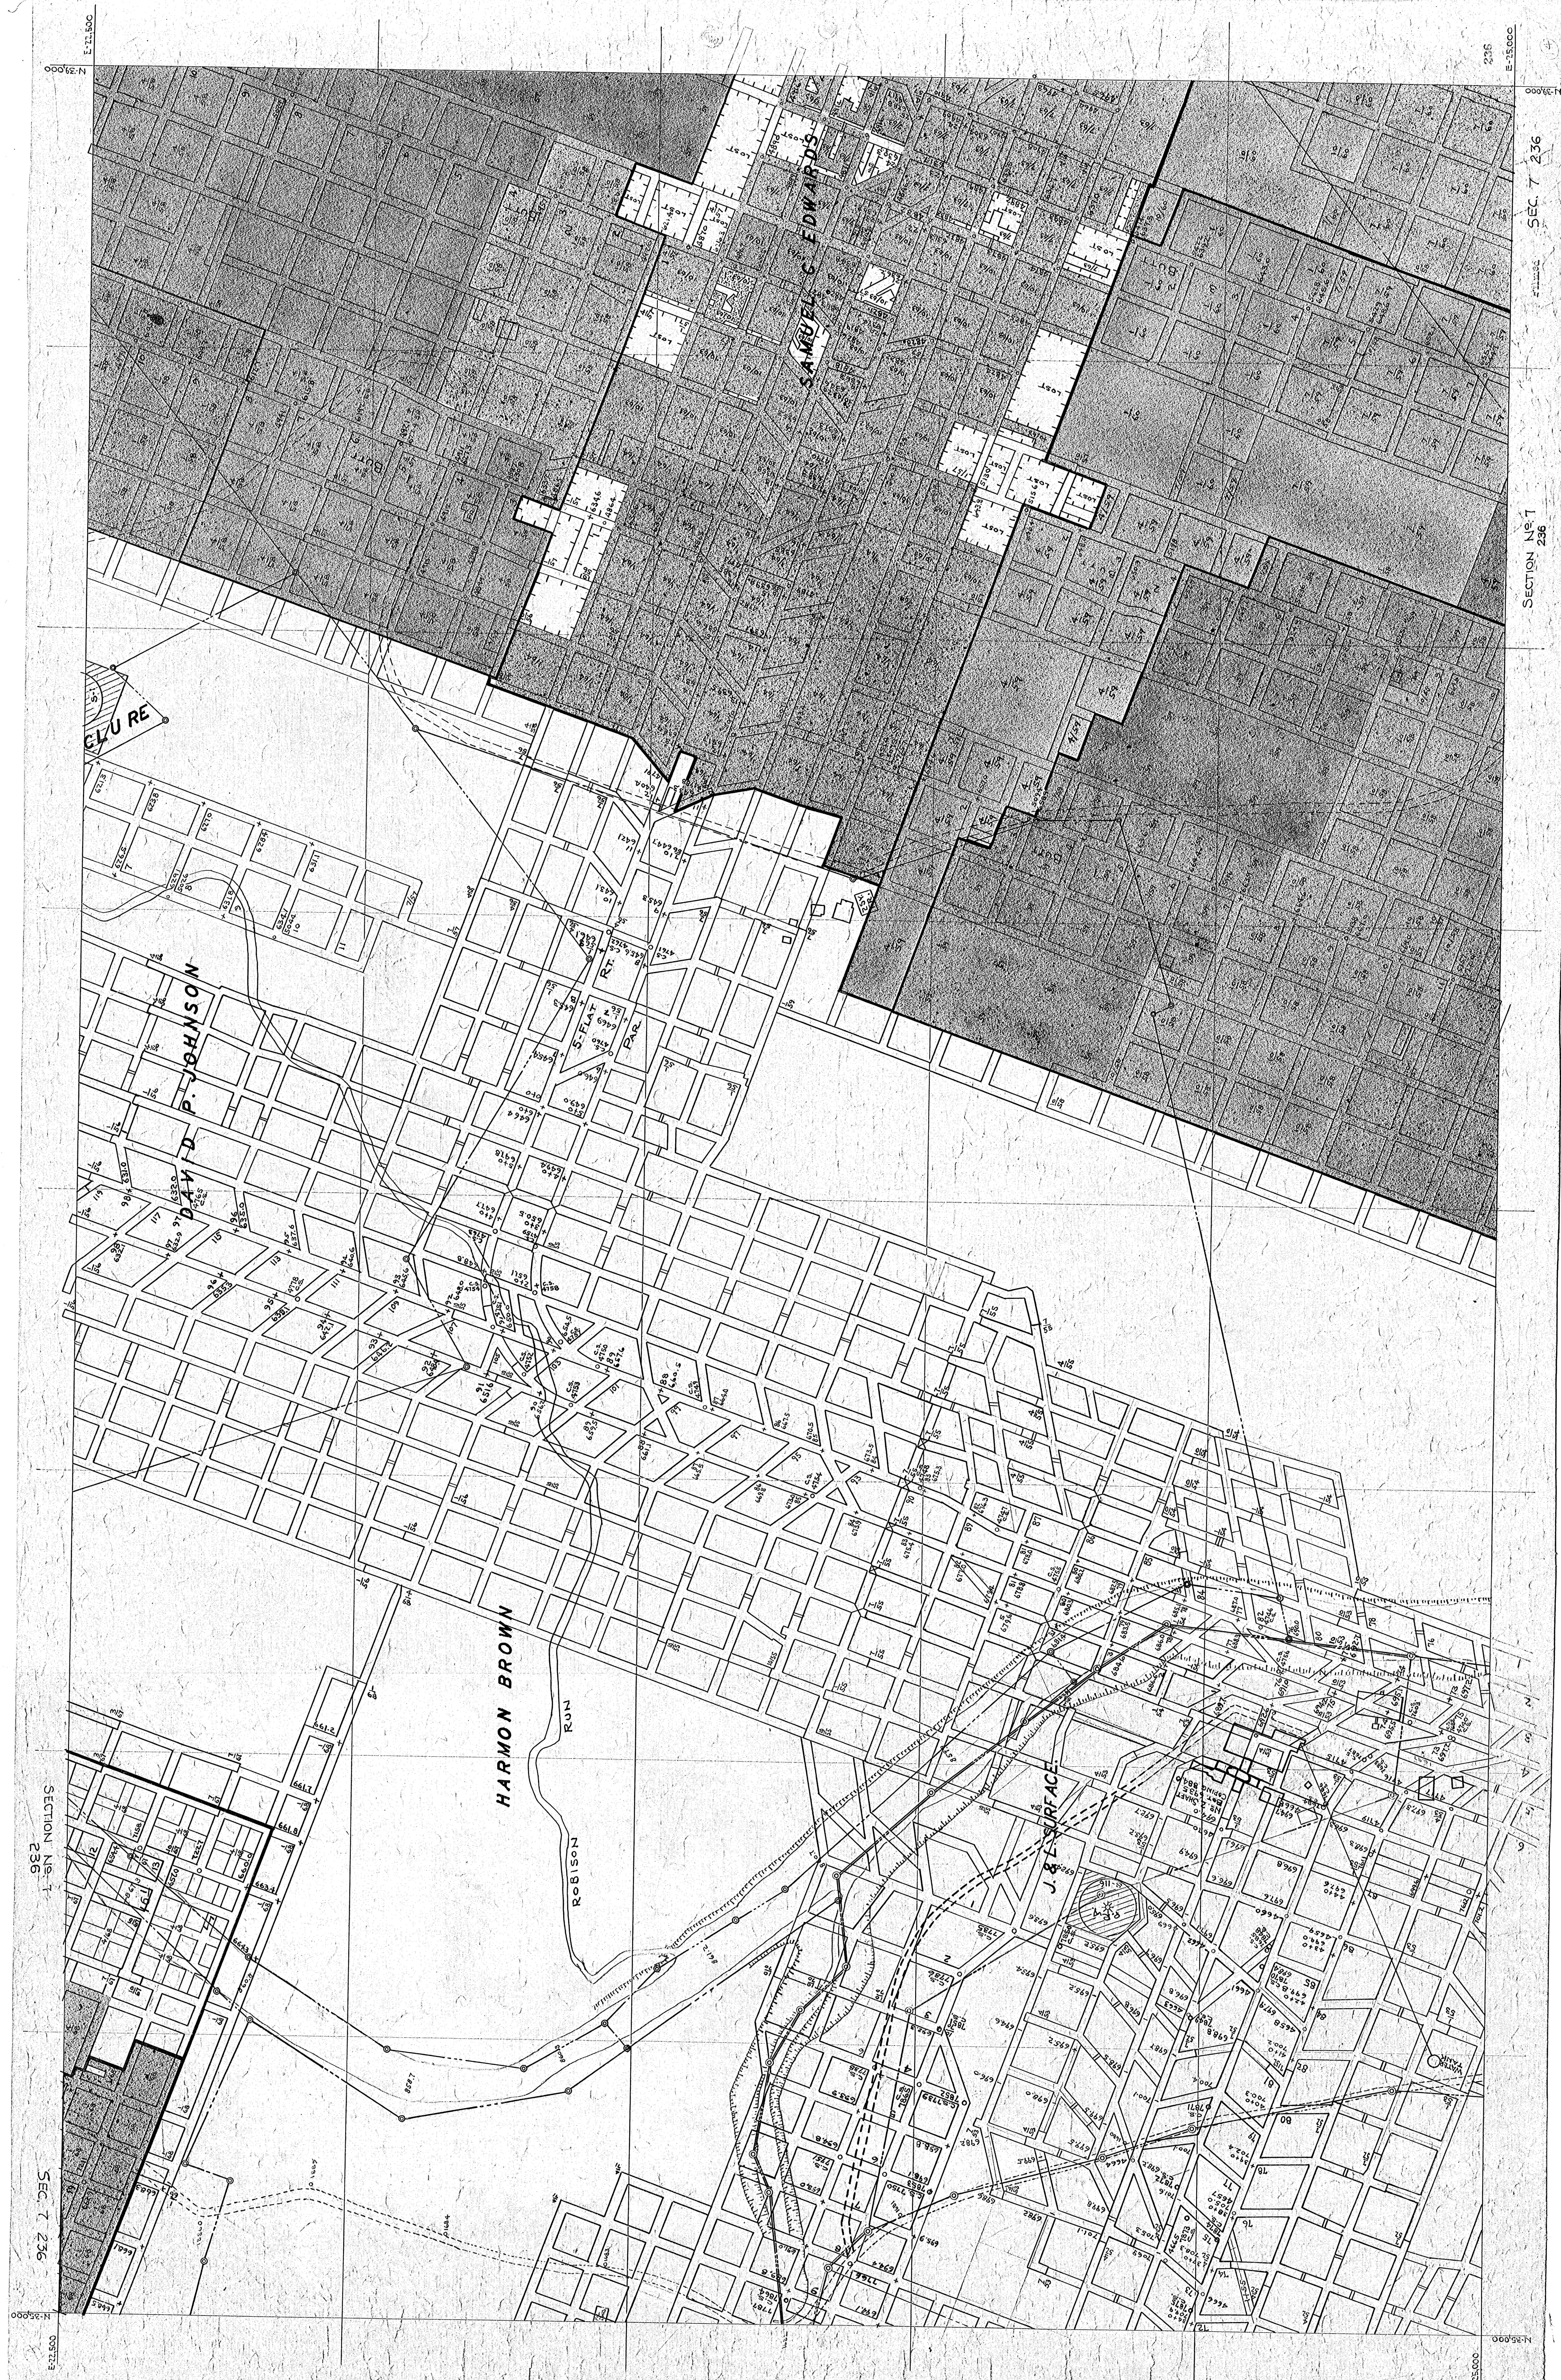

SECTION N. 1
236

SECTION N. 1
236

SECTION N. 1
236