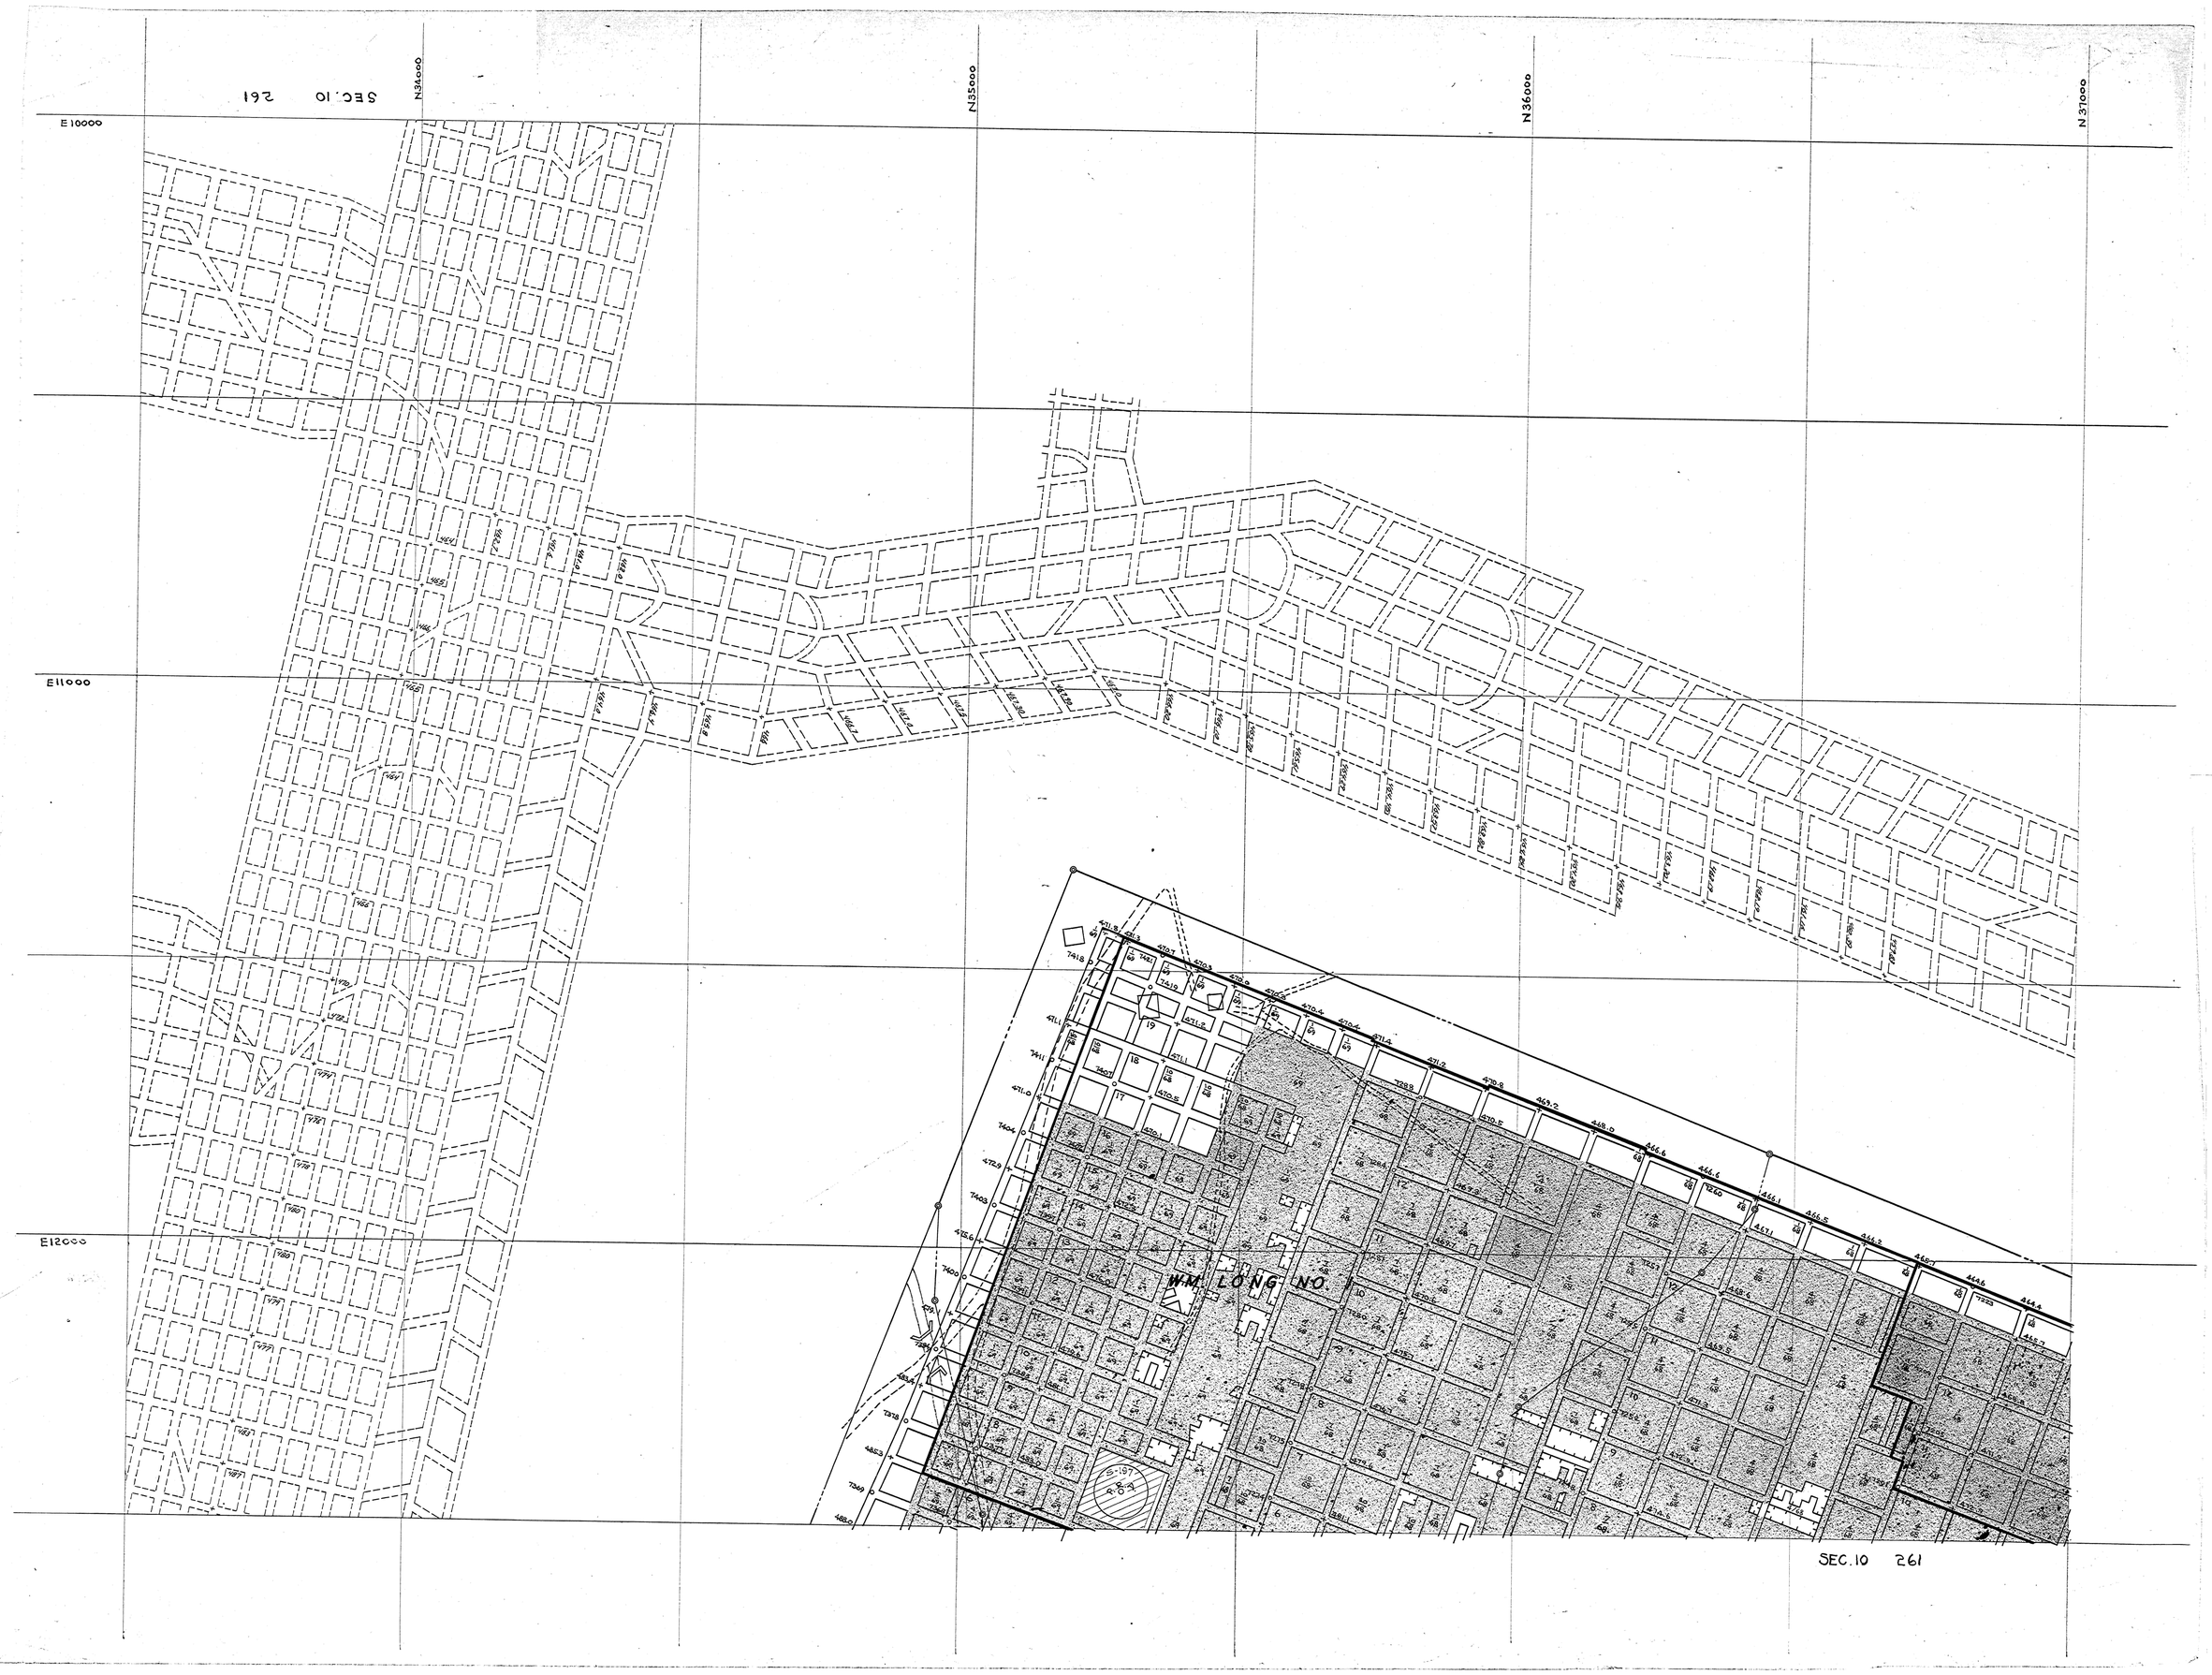
SEC. 10 261
N34000
N35000
N36000
N37000
E10000
E11000
E12000
WM. LONG NO. 1
SEC. 10 261