


SHAN. SEC. 13
No. 274



EMANUEL BEALL

MARIAH LIVENGOOD & RACHEL

SHAN. SEC. 13
No. 274

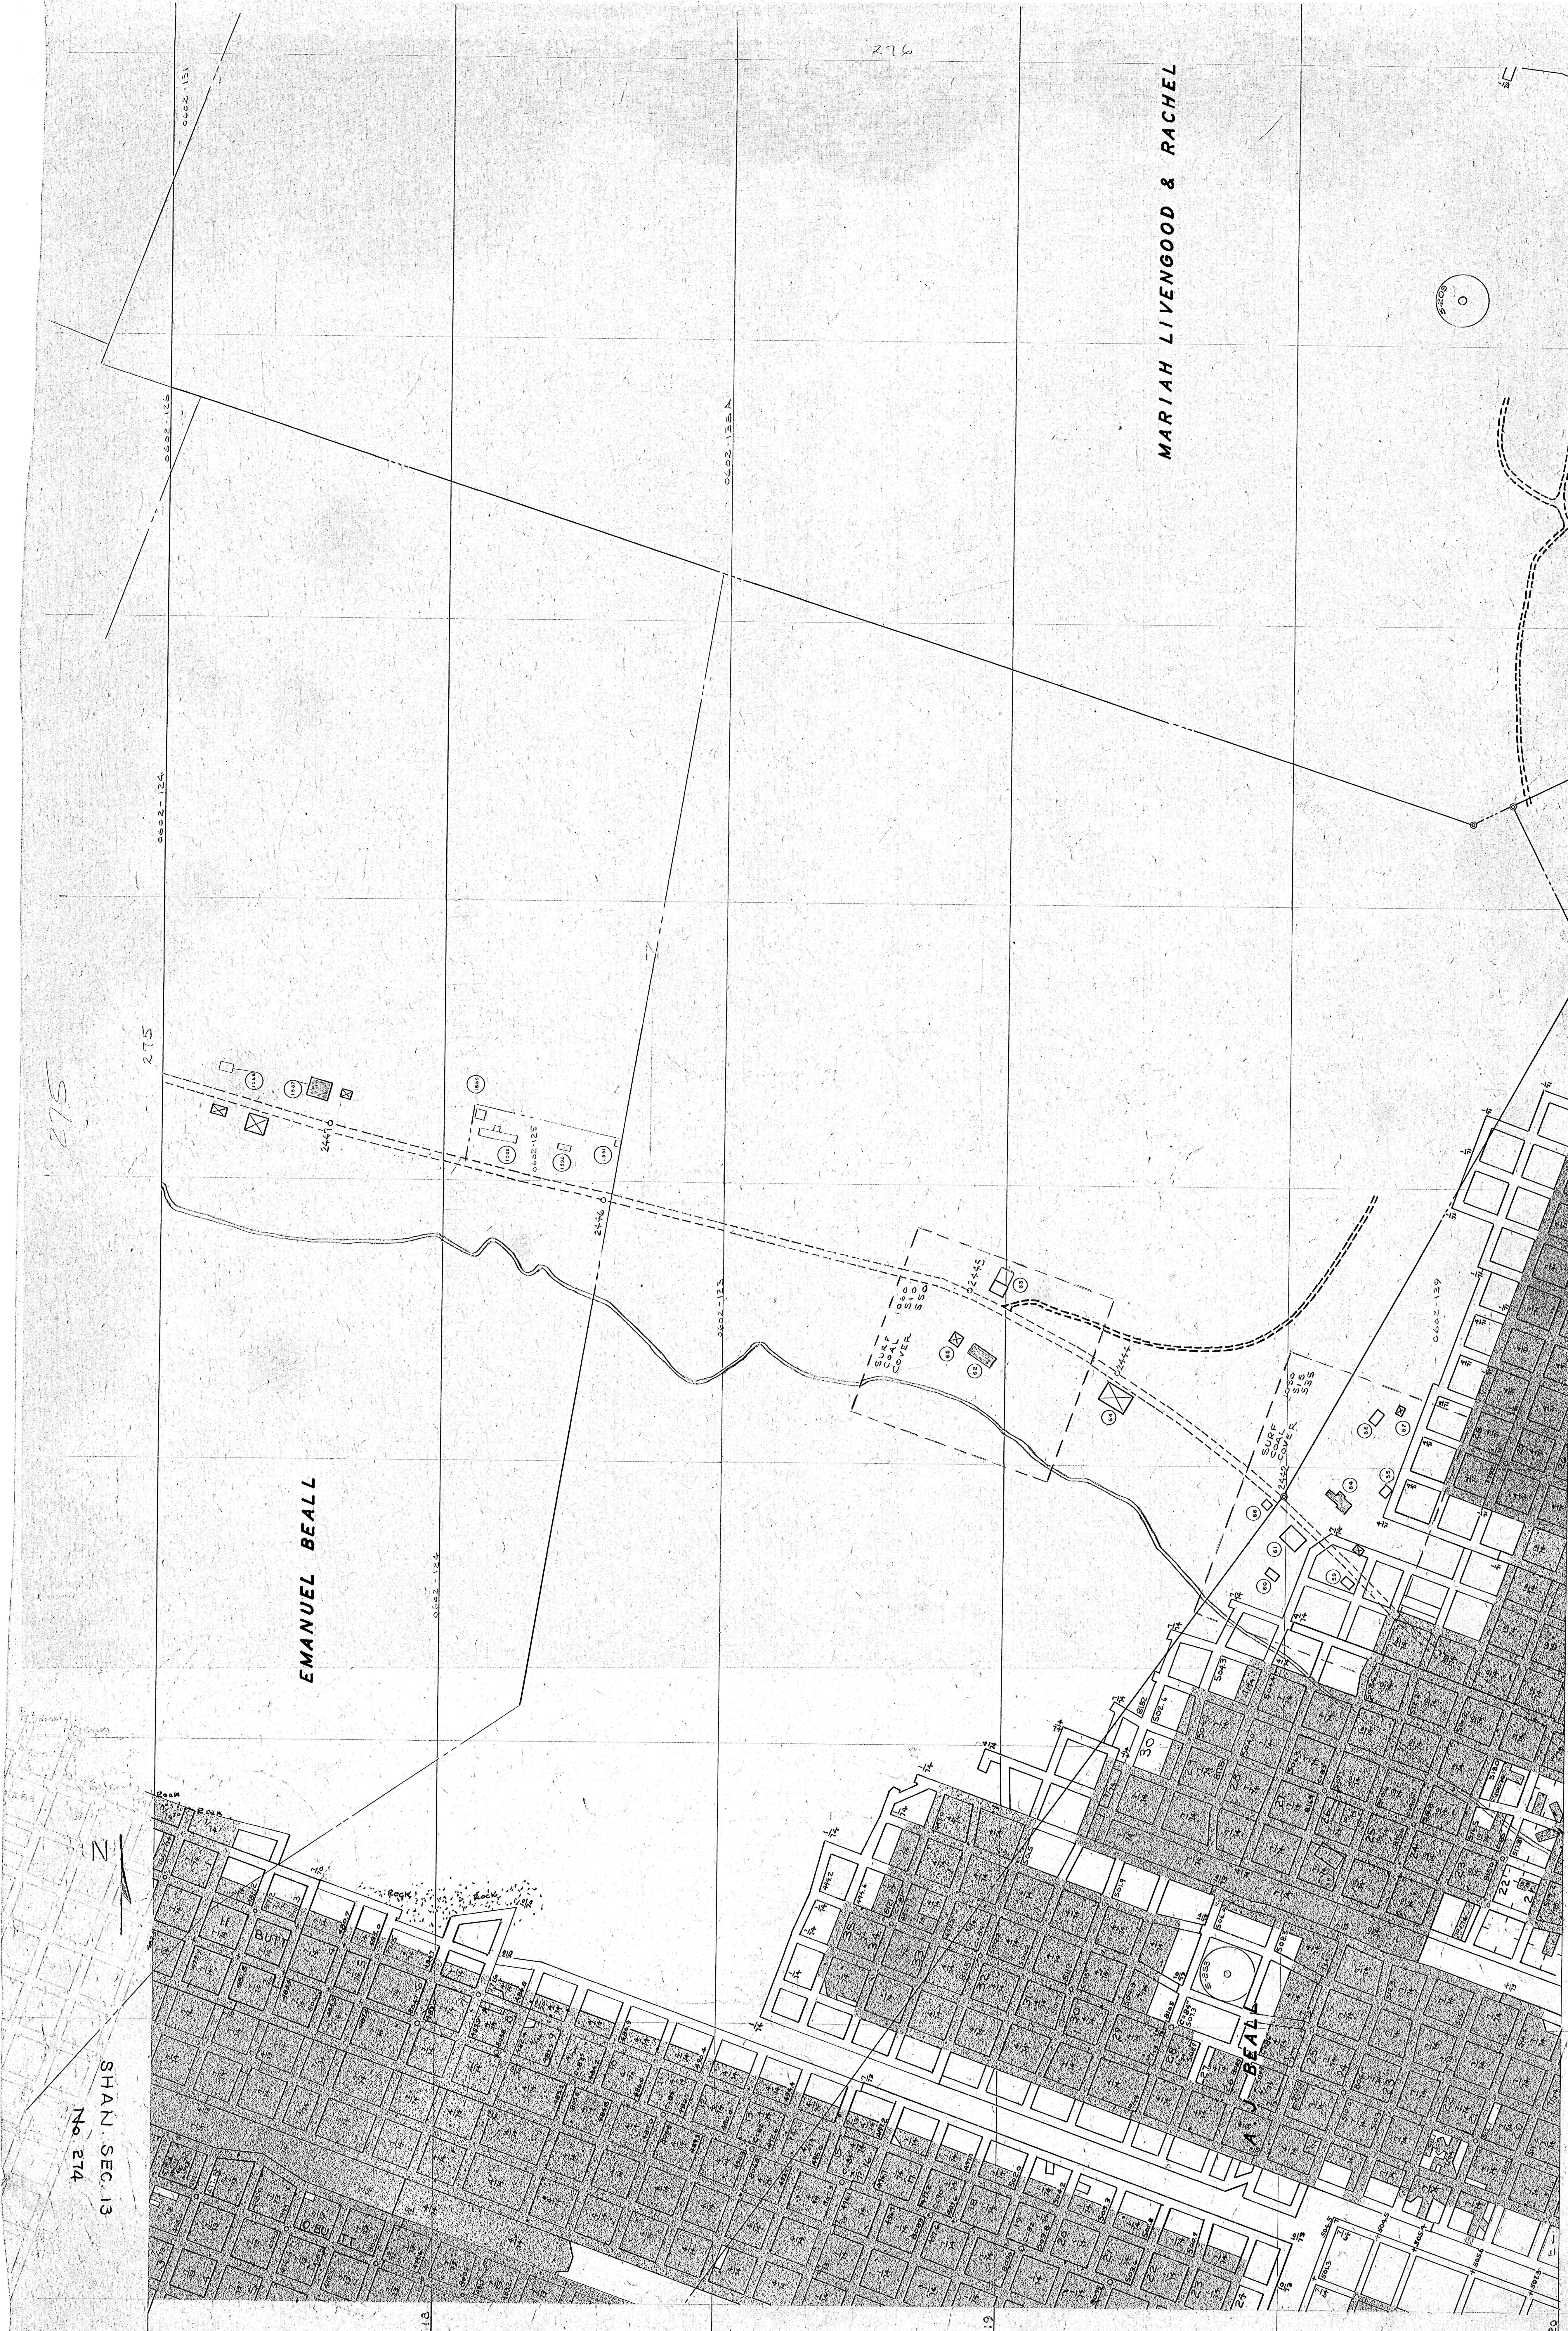

N46000

N41000

N48000

N49000