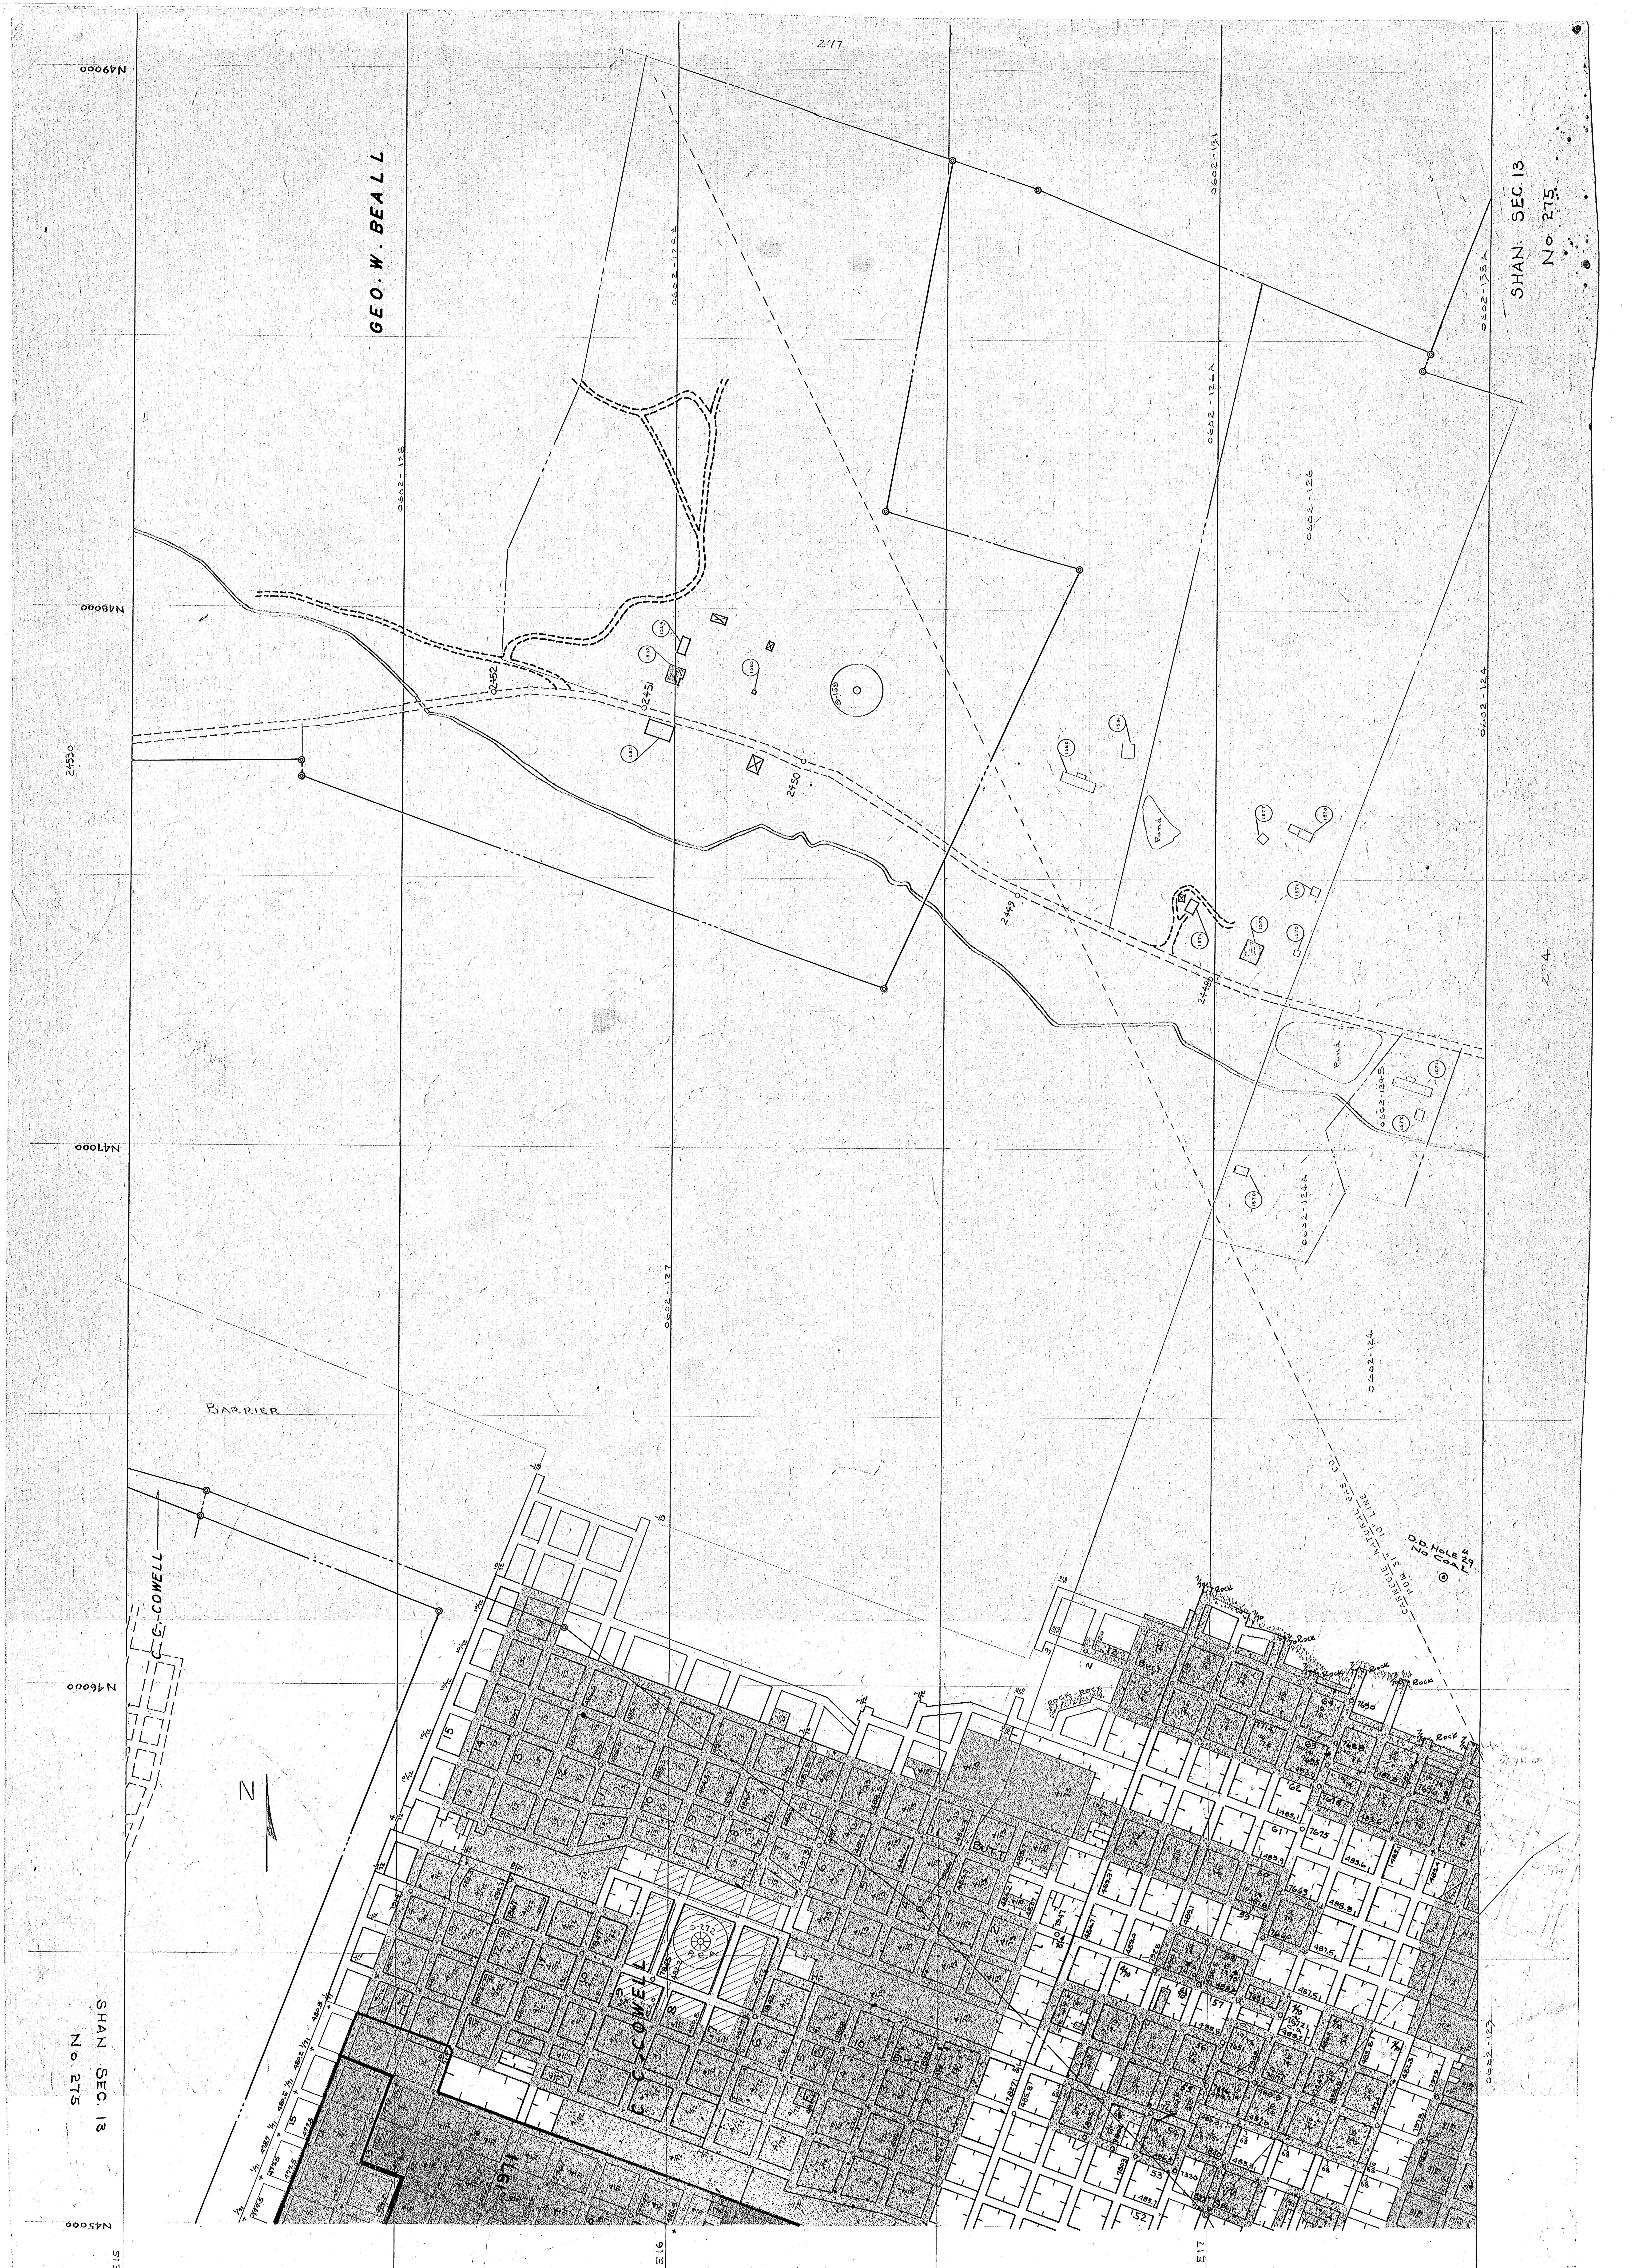
277
SHAN. SEC. 13
No. 275
GEO. W. BEALL
N49000
N48000
N47000
N46000
N45000
E15
E16
E17
0602-128
0602-128A
0602-131
0602-133A
0602-126A
0602-126
0602-124
0602-124B
0602-124A
0602-127
0602-123
24530
2452
2451
2450
2449
2448
Pond
274
BARRIER
C.C. COWELL
BUTT
N
15
151
152
CARNEGIE NATURAL GAS CO. 10" LINE
D.D. HOLE #29 NO COAL
Rock
SHAN SEC. 13
No. 275