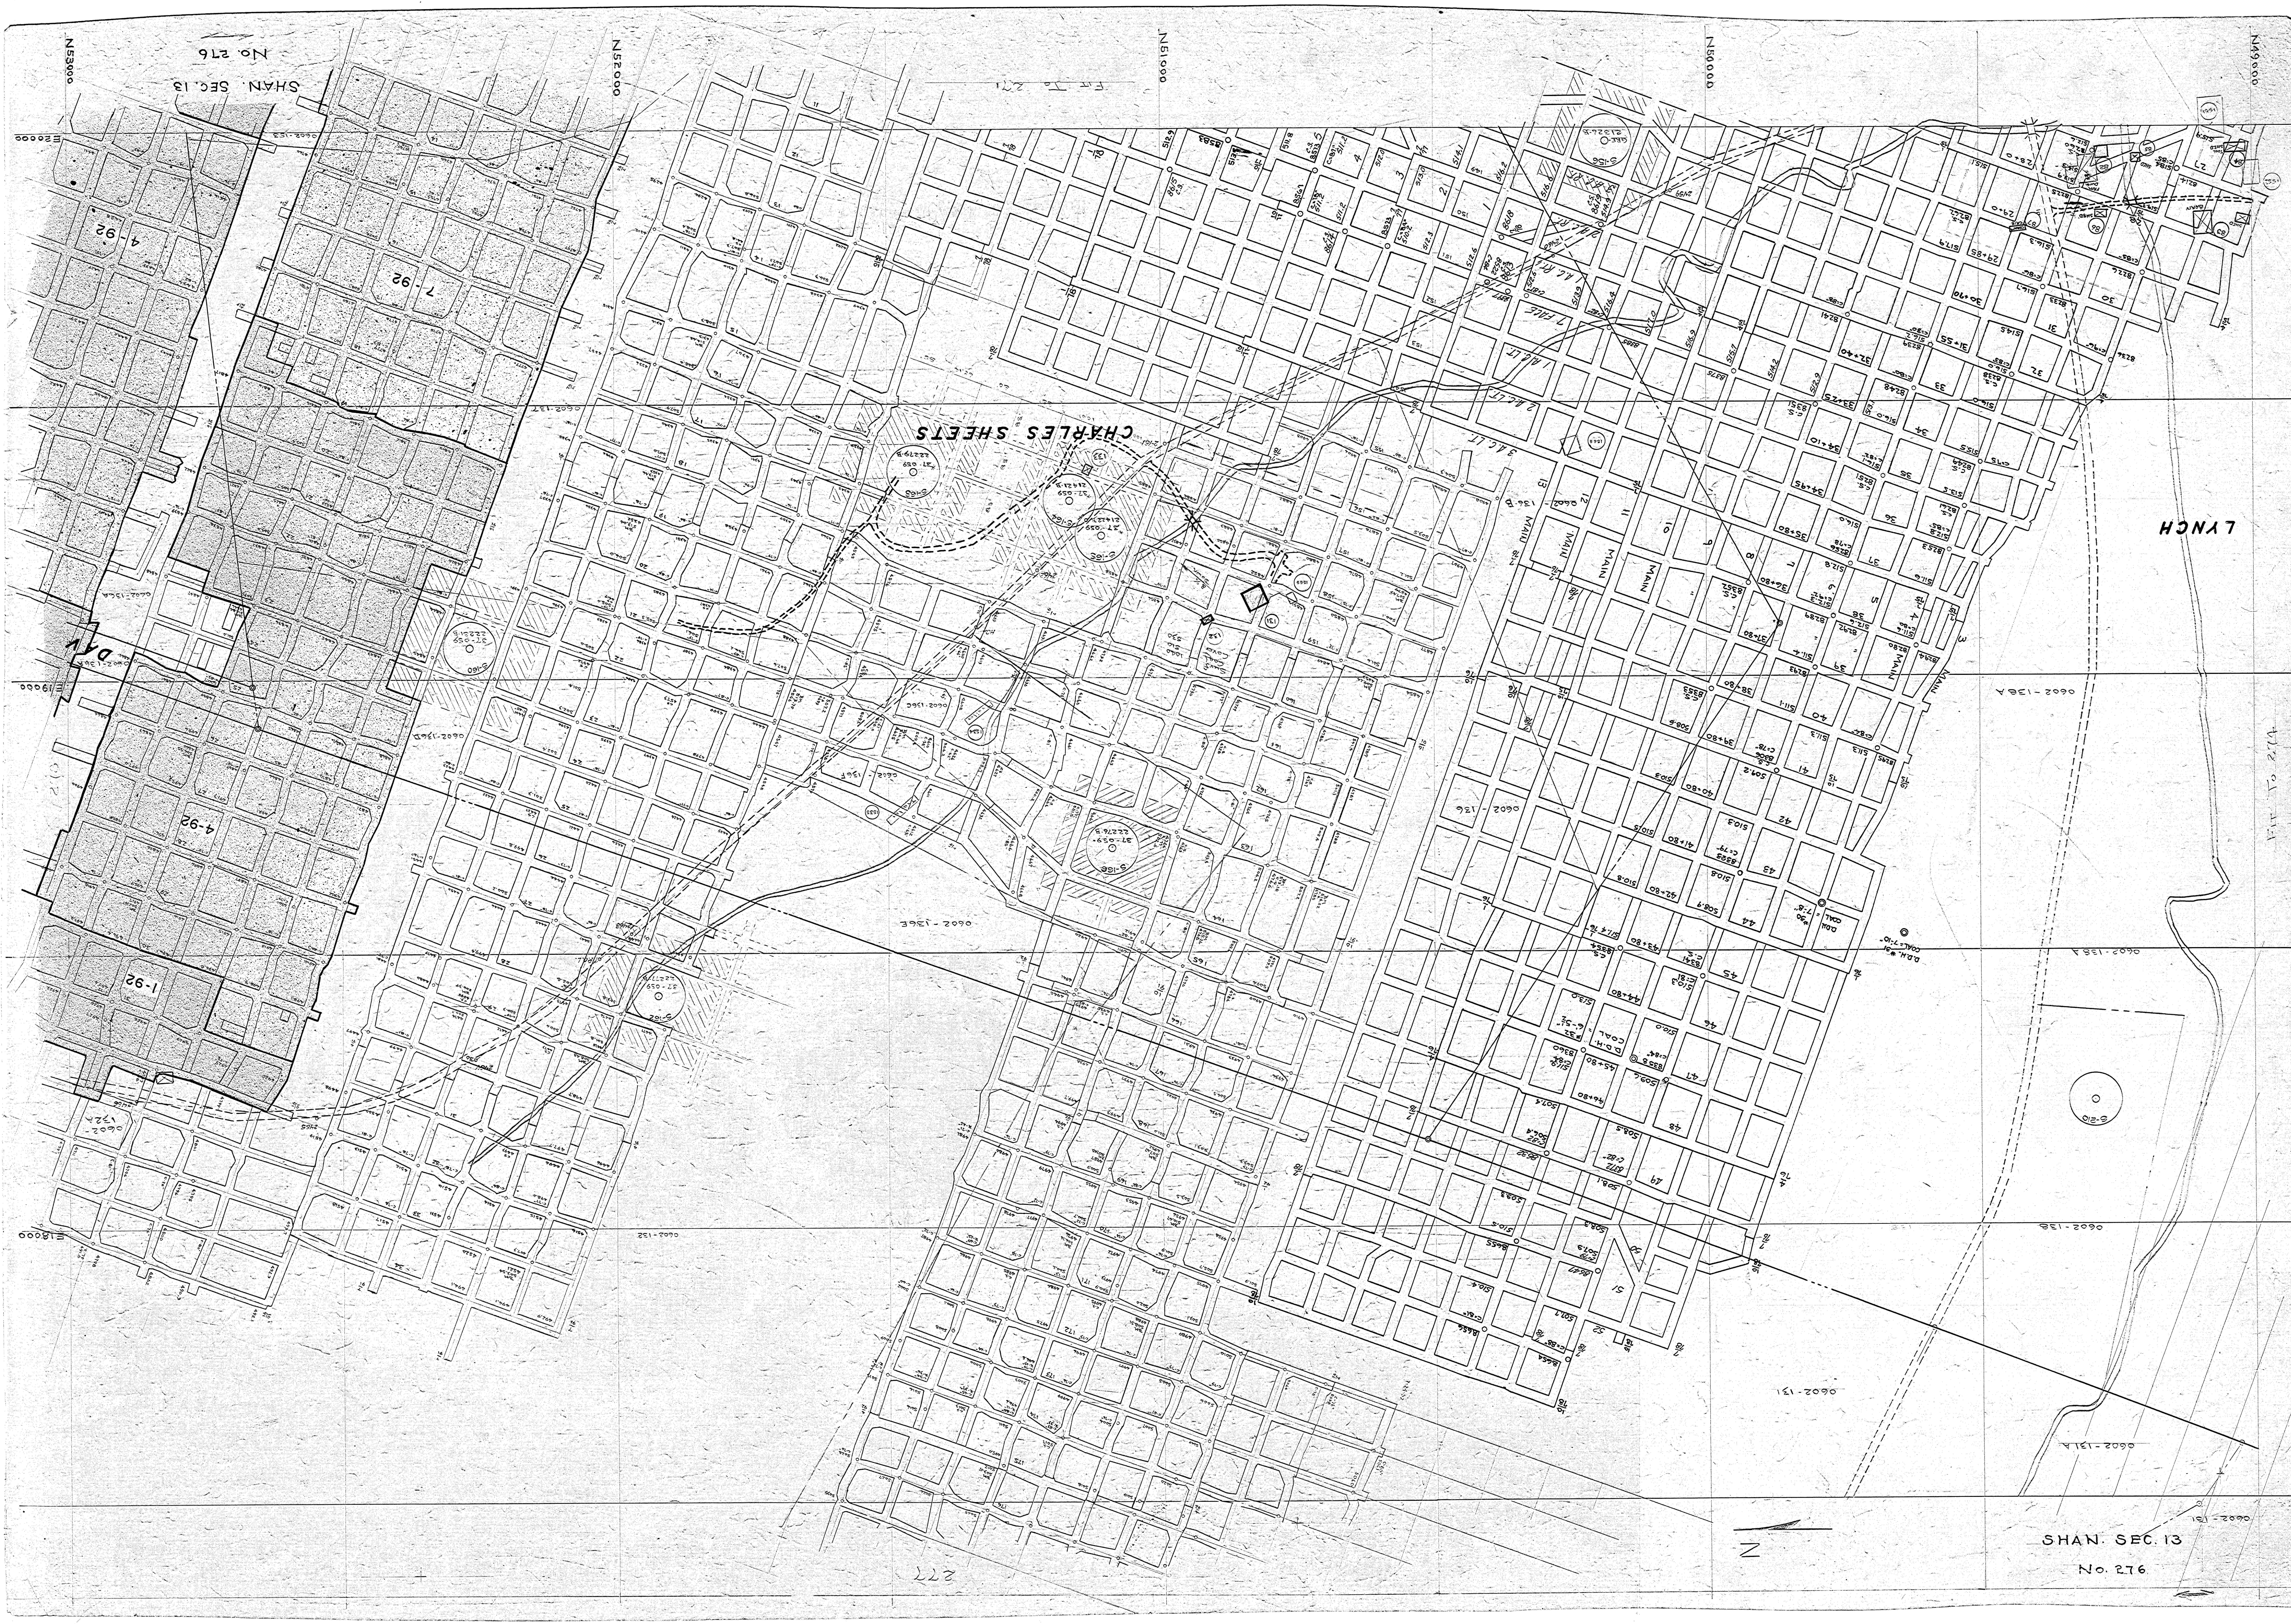
SHAN. SEC. 13
No. 276
N53000
N52000
N51000
N50000
N49000
E20000
E19000
E18000
1-92
4-92
7-92
DAV
CHARLES SHEETS
LYNCH
MAIN
Fit To 271
Fit To 274
277
N
0602-131
0602-131A
0602-132
0602-136
0602-136A
0602-136B
0602-136E
0602-137
0602-138
0602-138A