SHAN. SEC. 13
No. 278

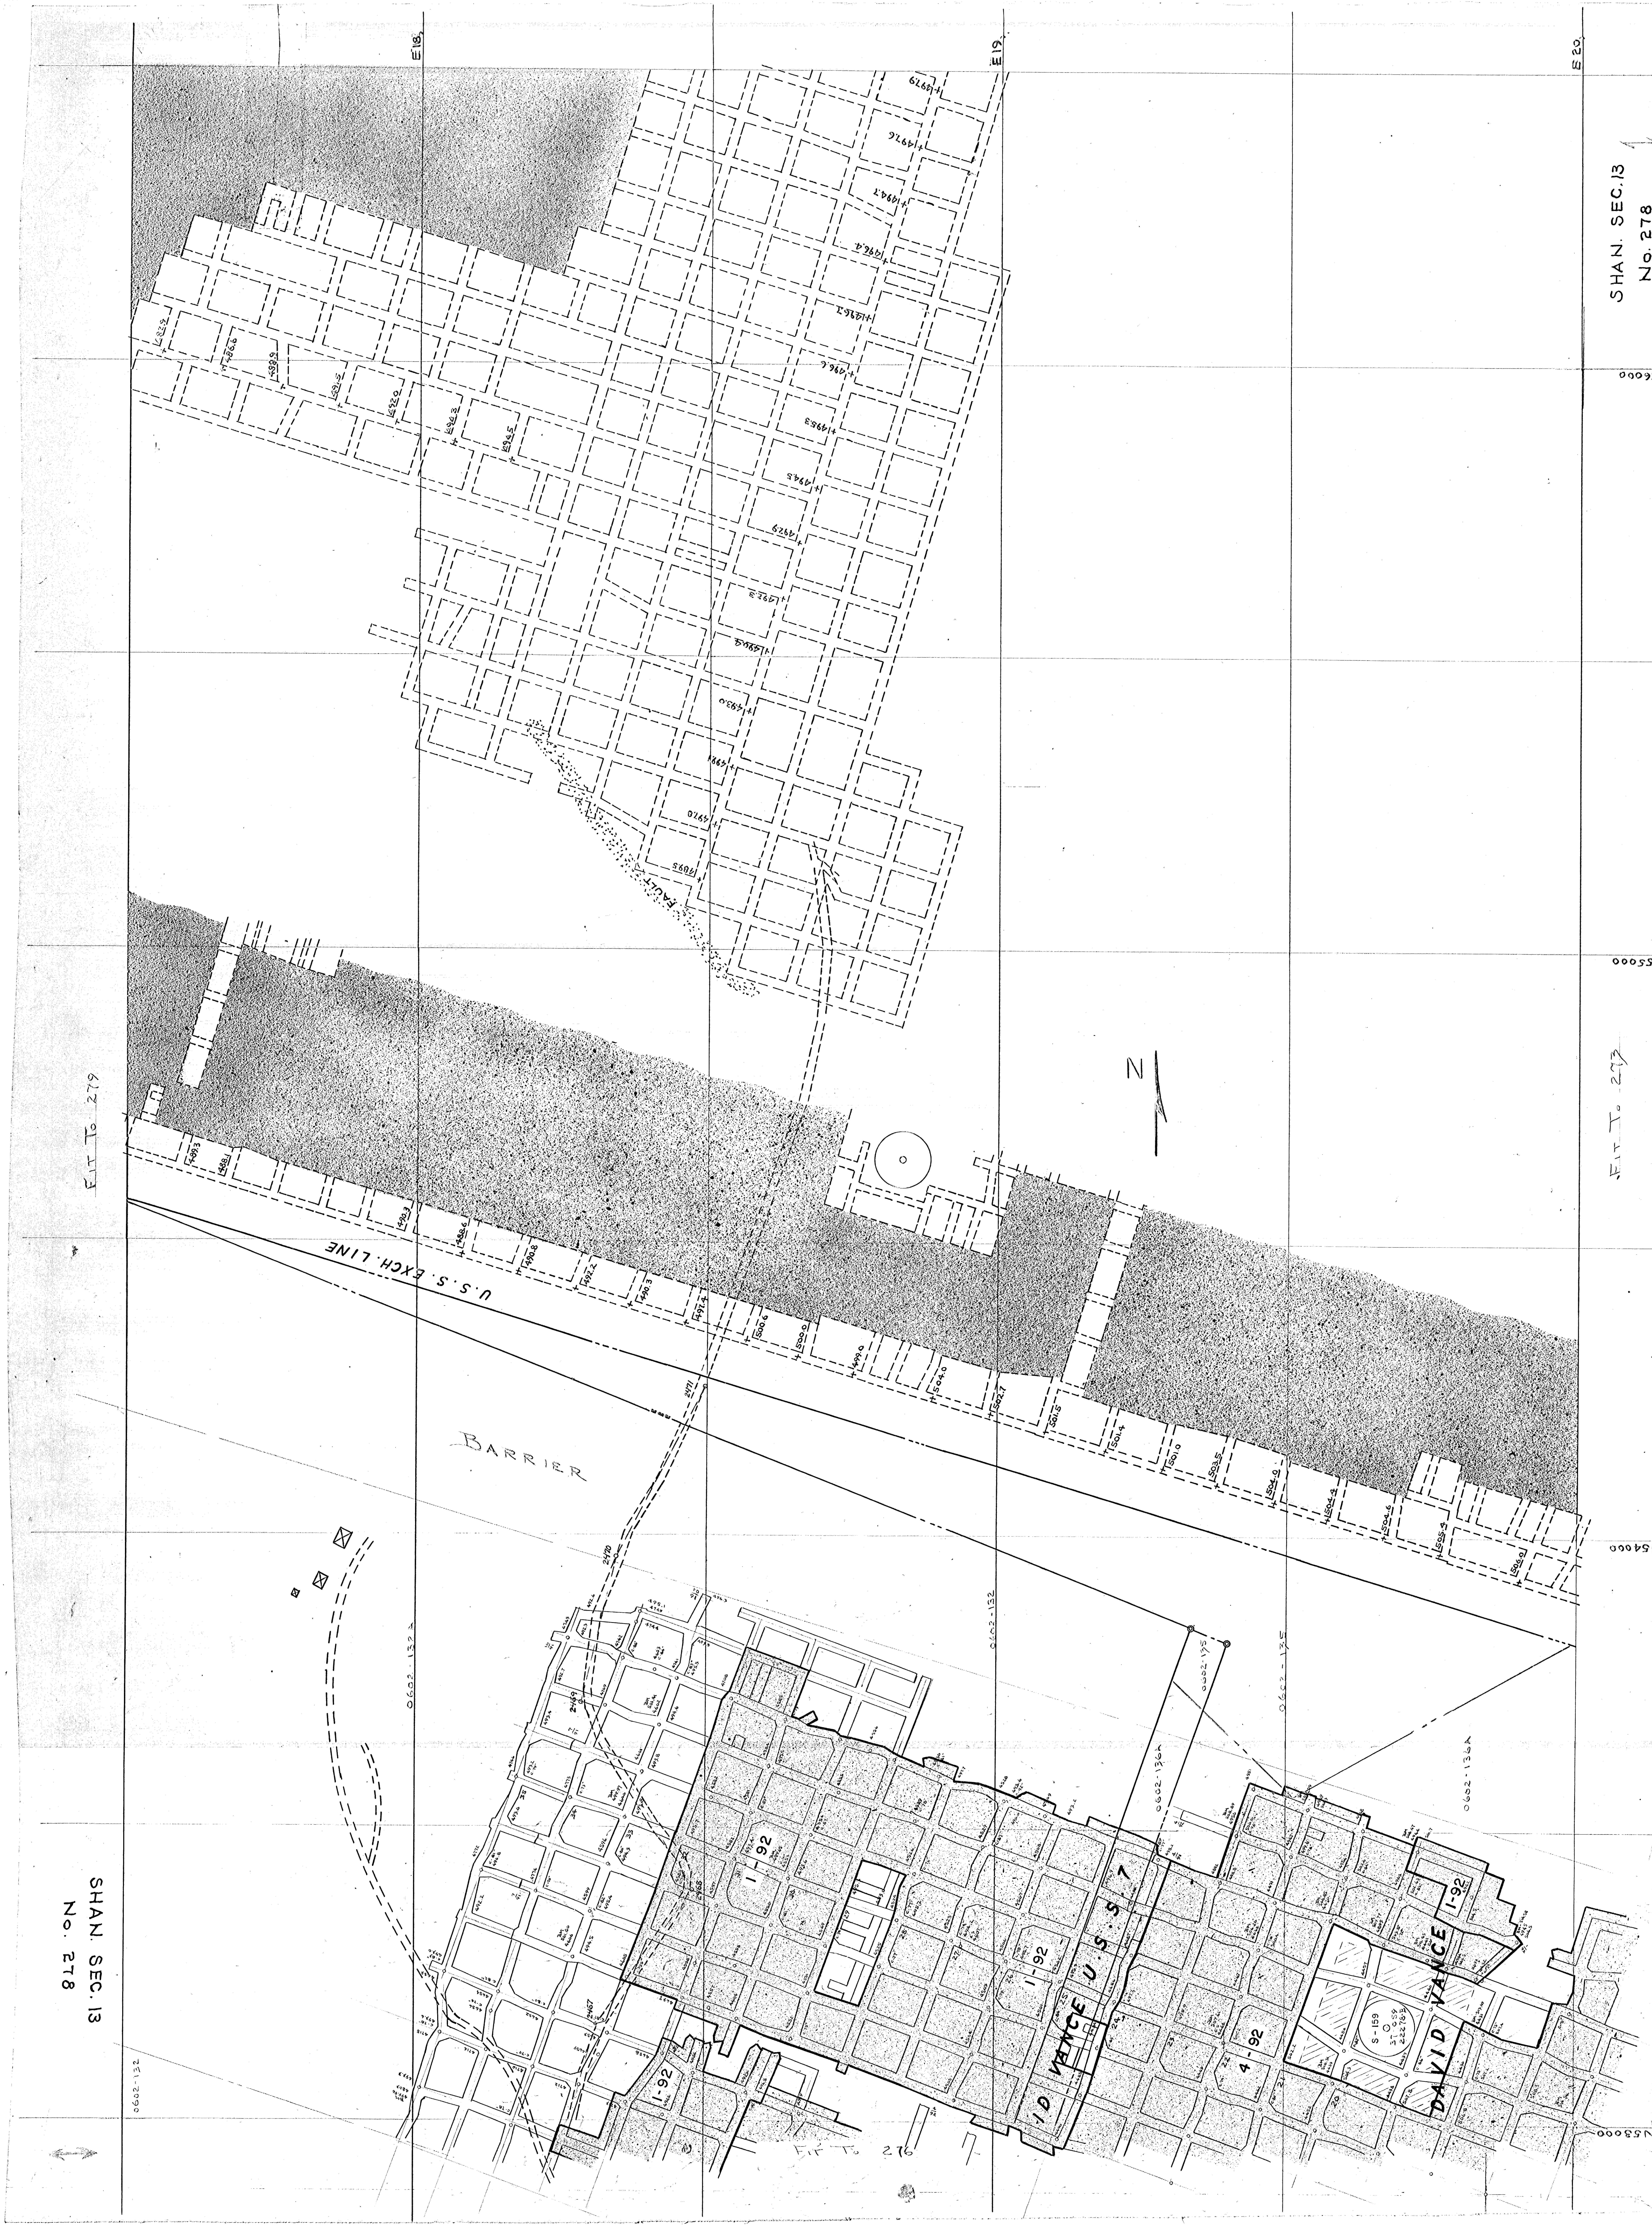
E18
E19
E20
N56000
N55000
N54000
N53000
N
FIT TO 279
FIT TO 273
FIT TO 276
U.S.S. EXCH. LINE
BARRIER
FAULT
+497.9
+497.6
+494.7
+496.4
+496.3
+496.6
+495.3
+494.5
+492.9
+492.3
+499.4
+493.0
+499
+497.0
+489.5
482.9
486.6
488.9
491.5
492.0
494.3
494.5
489.3
488.1
490.3
488.6
490.8
492.2
490.3
497.4
500.6
500.0
499.0
504.0
502.7
501.5
501.4
501.0
503.5
504.0
504.4
504.6
505.4
506.0
2471
2470
2469
2468
2467
0602-132
0602-135
0602-136A
I-92
4-92
U.S.S. 7
DAVID VANCE
S-159

SHAN. SEC. 13
No. 278