

SHAN. SEC. 13
No. 279

MARIAH LIVENGOD & RACHEL LYNCH

J. B. ROBERTS

1105 - 101

0602-104

0602-103

0602-132



BARRIER

BARRIER

0602-132A

278

SHAN. SEC. 13
No. 279

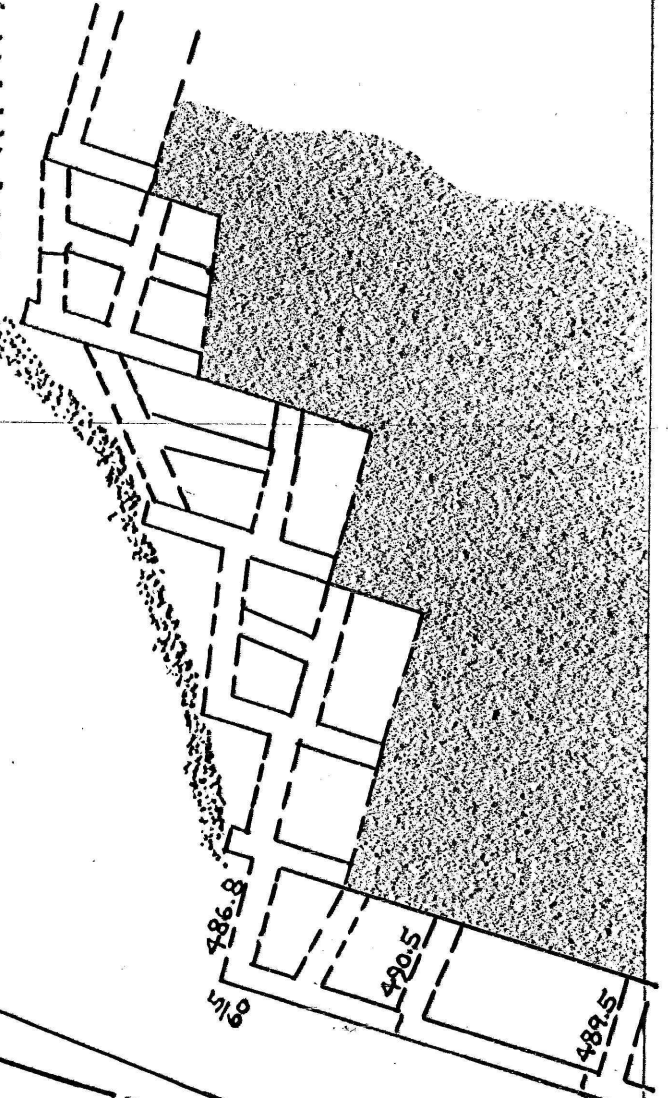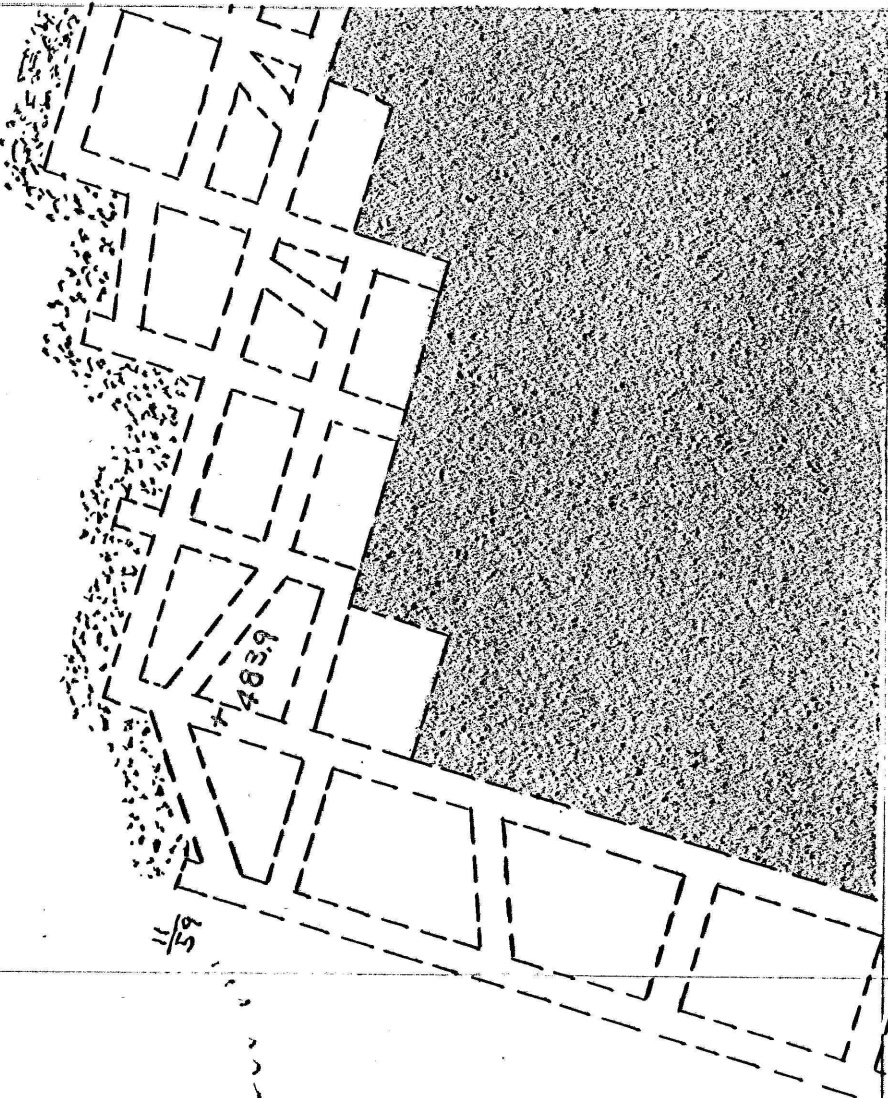

N53000

N54000

N55000

N56000

254

E15000

E16000

E17000

277