




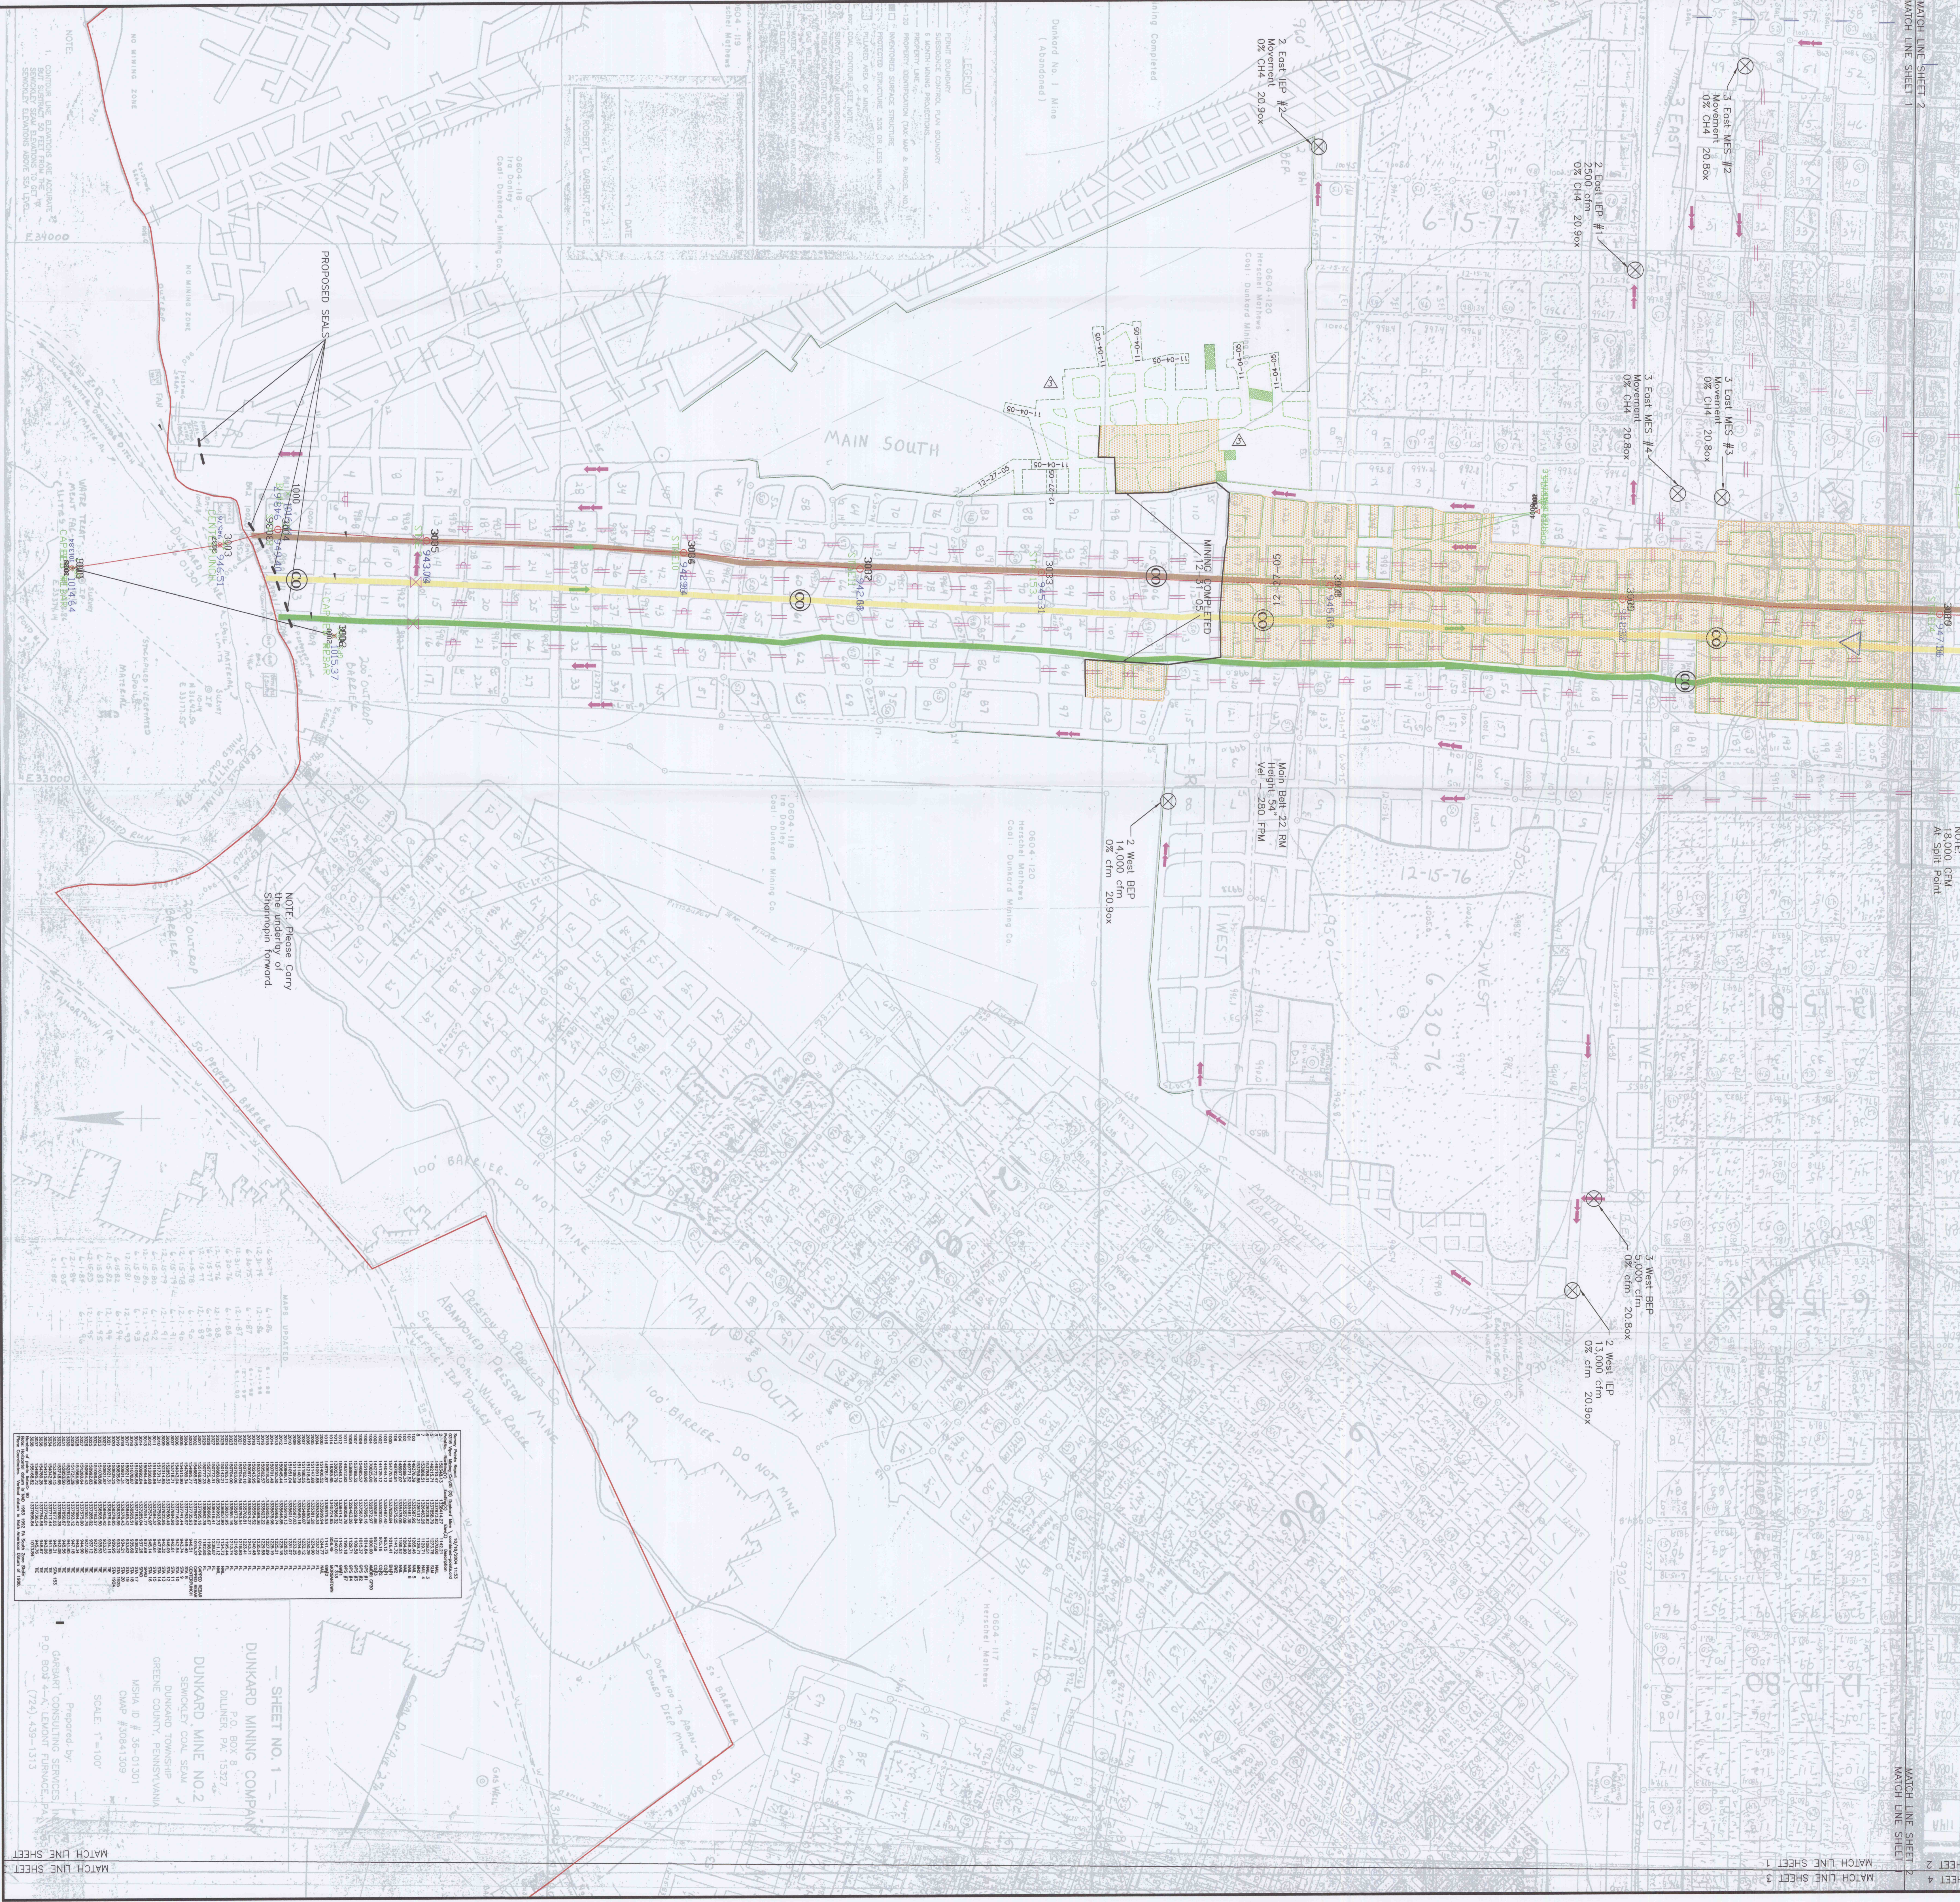


- LEGEND**
- UNDERGROUND PERMIT BOUNDARY
 - SUBSIDENCE CONTROL BOUNDARY
 - OCCUPIED DWELLING
 - UNOCCUPIED STRUCTURE
 - DRILLHOLE
 - SURFACE PARCEL IDENTIFICATION NUMBER
 - SURFACE PROPERTY LINE
 - LIMIT OF PROPOSED MINING
 - GASWELL
 - PROJECTED COAL MINING
 - COAL MINED
 - STOPPING
 - STOPPING W/ DOOR
 - STOPPING WITH HOLE
 - CHECK CURTAIN
 - REGULATOR
 - DOUBLE DOORS
 - RUN-THROUGH CHECK
 - OVERCAST
 - INTAKE AIR
 - RETURN AIR
 - CO MONITOR
 - MONITORING POINT
 - TAIL PIECE
 - BELT
 - PRIMARY ESCAPEWAY
 - SECONDARY ESCAPEWAY
 - MINED OUT AREA

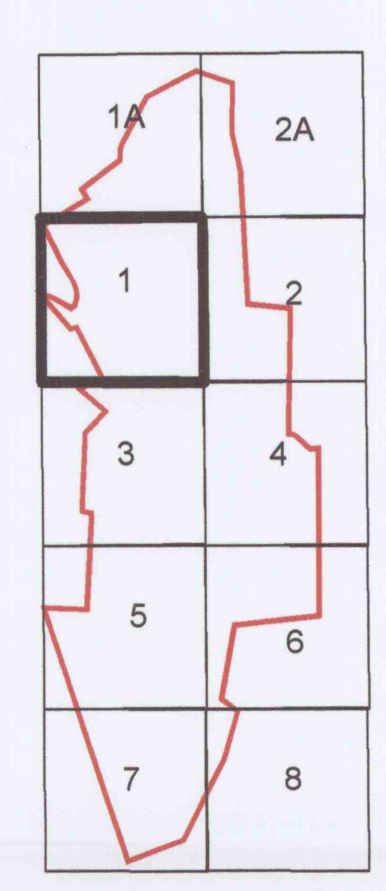

NOTE: This map was assembled using electronically scanned images of the Dunder No. 2 Mine maps, a map identified as the final map of the mine, and an electronic map of the Dunder No. 2 Mine. The maps were provided by PADEP, MDCO, and Dunder Mining, LLC. CME Engineering LP, carried out both a GPS Survey and an underground check survey to physically locate identifiable features common to all three maps and to locate the underground workings of the Dunder No. 2 Mine. No survey data was available for either the Mathews Mine or the Dunder No. 2 Mine other than the survey carried out by CME Engineering LP. The survey information has been added to the maps and was used to geo-reference the mine maps. No adjustments or alterations were made to the images of any of the mine maps utilized.

NOTE: Closed Loop Survey Accuracy: 1"=5000'

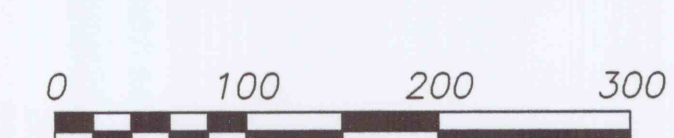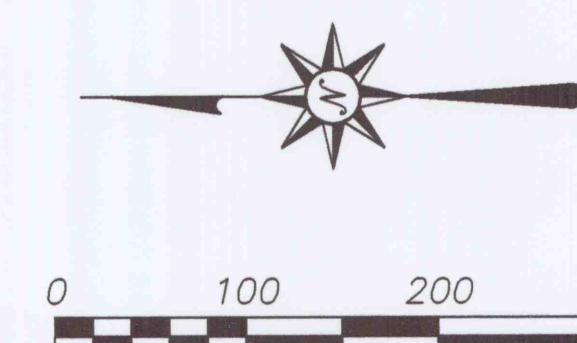

JAMES G. PRICE, MINE SUPERINTENDENT
DATE: 4/6/06



JACK E. FERENCI, PE
DATE: 4/6/06

CME ENGINEERING
CME ENGINEERING LP
165 East Union Street, Suite 100, Somerset, PA 15501
814-443-3344 FAX: 814-444-0365

COBRA MINING, LLC
176 CHERRY MINE ROAD
P.O. BOX 40
DILLINGER, PA 15227

FINAL MAP OF DUNKARD MINE NO. 2
SEWICKLEY COAL SEAM
MINING COMPLETED 12/31/05
MSHA ID #56-01301
CMAP #30841302

REVISIONS				Drawn By: MAK
No.	By	Date	Description	Checked By: JEF
1	MAK	6/28/05	Mining Updated	Date: 6/28/05
2	RJB	12/31/05	Mining Updated	Scale: 1" = 100'
3	RJB	4/6/06	Revisions made for comments from Deep Mine Safety	Project No.: 316-051
				File Name: FINAL MAP.DWG
				Drawing: 3 of 10

DUNKARD MINE NO. 1
DUNKARD MINING COMPANY
DILLINGER, PA 15227

DUNKARD MINE NO. 2
SEWICKLEY COAL SEAM
DUNKARD TOWNSHIP
GREENE COUNTY, PENNSYLVANIA
MSHA ID # 35-01301
CMAP #30841309

SCALE: 1"=100'

Prepared By: GABRIEL CONSULTING SERVICES
P.O. BOX 144, LEBANON, PENNSYLVANIA 17042-0144
(717) 657-1313