



- LEGEND**
- UNDERGROUND PERMIT BOUNDARY
 - SUBSIDENCE CONTROL BOUNDARY
 - OCCUPIED DWELLING
 - UNOCCUPIED STRUCTURE
 - DRILLHOLE
 - SURFACE PARCEL IDENTIFICATION NUMBER
 - SURFACE PROPERTY LINE
 - LIMIT OF PROPOSED MINING
 - GASWELL
 - PROJECTED COAL MINING
 - COAL MINED
 - STOPPING
 - STOPPING W/ DOOR
 - STOPPING WITH HOLE
 - CHECK CURTAIN
 - REGULATOR
 - DOUBLE DOORS
 - RUN-THROUGH CHECK
 - OVERCAST
 - INTAKE AIR
 - RETURN AIR
 - CO MONITOR
 - MONITORING POINT
 - TAIL PIECE
 - BELT
 - PRIMARY ESCAPEWAY
 - SECONDARY ESCAPEWAY
 - MINED OUT AREA

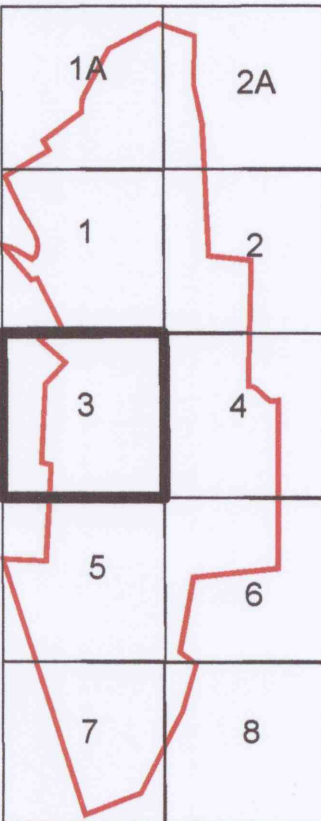

NOTE: This map was assembled using electronically scanned images of the Dunkard No. 2 Mine map, a map identified on the final map of the Mathews Mine, and on an electronic map of the Crowded Mine-A Portal. The maps were provided by PACE, MEPCO, and Color Mining, LLC. CME Engineering LP carried out both a GPS Survey and an underground check survey to physically locate identifiable features common to all three mines and to locate the underground workings of the Dunkard No. 2 Mine. No survey data was available for either the Mathews Mine or the Dunkard No. 2 Mine other than the surveys carried out by CME Engineering LP. The survey information has been added to the maps and was used to geo-reference the mine maps. No adjustments or alterations were made to the images of any of the mine maps utilized.

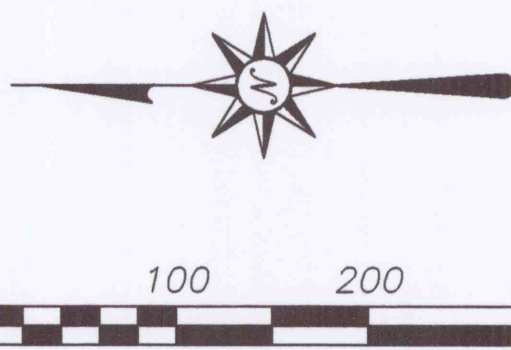

James G. Price
JAMES G. PRICE, MINE SUPERINTENDENT

3/2/06
DATE

Jack E. Ferenc
JACK E. FERENCI, PE

3/2/06
DATE



CME
ENGINEERING

CME ENGINEERING LP
165 East Union Street, Suite 100, Somerset, PA 15501
814-443-3344 FAX: 814-444-0365

DUNKARD 100' SHT 3
COBRA MINING, LLC
178 CHESS MINE ROAD
P.O. BOX 40
DILLINER, PA 15327

FINAL MAP OF
DUNKARD MINE NO.2
SEWICKLEY COAL SEAM
MINING COMPLETED 12/31/05

MSHA-ID #38-01301
CMAP #30841309

REVISONS				Drawn By:	MAK
No.	By	Date	Description	Checked By:	JEF
1	MAK	6/28/05	Mining Updated	Date:	6/28/05
2	RJB	12/31/05	Mining Updated	Scale:	1" = 100'
				Project No.:	316-051
				File Name:	FINAL MAP.DWG
				Drawing:	5 of 10