


LEGEND

- UNDERGROUND PERMIT BOUNDARY  
SUBSIDENCE CONTROL BOUNDARY  
OCCUPIED DWELLING  
UNOCCUPIED STRUCTURE  
DRILLHOLE  
SURFACE PARCEL IDENTIFICATION NUMBER  
SURFACE PROPERTY LINE  
LIMIT OF PROPOSED MINING  
GASWELL  
PROJECTED COAL MINING  
COAL MINED  
STOPPING  
STOPPING W/ DOOR  
STOPPING WITH HOLE  
CHECK CURTAIN  
REGULATOR  
DOUBLE DOORS  
RUN-THROUGH CHECK  
OVERCAST  
INTAKE AIR  
RETURN AIR  
CO MONITOR  
MONITORING POINT  
TAIL PIECE  
BELT  
PRIMARY ESCAPEWAY  
SECONDARY ESCAPEWAY  
MINED OUT AREA



NOTE: This map was assembled using electronically scanned images of the Dunkard No. 2 Mine map, a map identified on the final map of the Matheus Mine, and an electronic map of the Crowded Mine-A Portal. The maps were provided by PACE, MSCO, and CME Mining, LLC. CME Engineering LP carried out both a GPS Survey and an underground check survey to physically locate identifiable features common to all three mines and to locate the underground workings of the Dunkard No. 2 Mine. No survey data was available for either the Matheus Mine or the Dunkard No. 2 Mine other than the surveys carried out by CME Engineering LP. The survey information has been added to the maps and was used to geo-reference the mine maps. No adjustments or alterations were made to the images of any of the mine maps utilized.

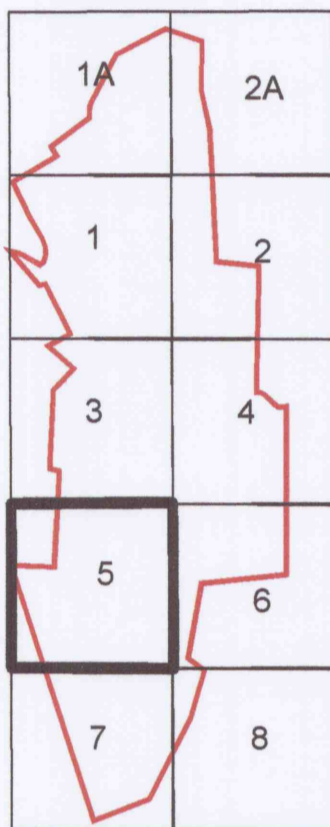

0 100 200 300

JAMES G. PRICE, MINE SUPERINTENDENT

5/2/06  
DATE

JACK E. FERENCI, PE

3/2/06  
DATE

RECEIVED  
APR 10 2005

Dept. of Environmental Protection  
P.O. BOX 40  
DILLINER, PA 15227

**CME**  
ENGINEERING  
CME ENGINEERING LP

165 East Union Street, Suite 100, Somerset, PA 15501  
814-443-3344 FAX: 814-444-0365

DUNKARD 100' SHT 5

COBRA MINING, LLC  
178 CHESS MINE ROAD  
P.O. BOX 40  
DILLINER, PA 15227

FINAL MAP OF  
DUNKARD MINE NO.2  
SEMIWOLLEY COAL SEAM  
MINING COMPLETED 12/31/05

MSHA ID #38-01301  
CMAF #30841309

REVISIONS

No.	By	Date	Description
1	MAK	6/28/05	Mining Updated
2	RJB	12/31/05	Mining Updated

Drawn By: MAK

Checked By: JEF

Date: 6/28/05

Scale: 1" = 100'

Project No.: 316-051

File Name: FINAL MAP.DWG

Drawing: 7 of 10

— SHEET NO. 6 —

DUNKARD MINING COMPANY

DILLINER, PA 15227

DUNKARD MINE NO.2

SEMIWOLLEY COAL SEAM

DUNKARD TOWNSHIP

GREENE COUNTY, PENNSYLVANIA

MSHA ID # 38-01301

CMAF #30841309

SCALE: 1" = 100'

Prepared by:

CARBART CONSULTING SERVICES, INC.

P.O. BOX 4-A, LEANOR FURNACE, PA 15066

(724) 759-1313