

KEY TO PREVIOUSLY MINED AREAS

Map Key	Type	Status	Operator	Permit no.	Coal Seam
A	Underground	Abandoned	Mateer Coal Co., Inc.	-----	Upper Freeport
B	Underground	Abandoned	B&B Coal Co.	364M026	Upper Freeport
C	Underground	Abandoned	Bollinger Coal Co.	368M025	Upper Freeport
D	Surface	Abandoned	Altmire Bros. Coal Co.	2866BSM85	Upper Freeport
E	Surface	Abandoned	Altmire Bros. Coal Co.	105025	Upper Freeport
F	Underground	Abandoned	Loyal Creek (No.4)	03831303	Upper Freeport
G	Underground	Inactive	Canterbury Coal Co.	03841306	Lower Kittanning
H	Underground	Active	Kaskan Coal Co.	-----	Upper Freeport
I	Underground	Active	K&Z Coal Co.	-----	Upper Freeport

LEGEND
 UNDERGROUND PERMIT AREA (1792 AC.)
 SUBSIDENCE CONTROL BOUNDARY (333.6 AC.)
 SOLID COAL BARRIER-NO MINING
 DWELLING
 UNOCCUPIED STRUCTURE
 WATER WELL
 KEY NO. TO INDIVIDUAL PROPERTY OWNERS
 NO MINING UNTIL LEASE AGREEMENT
 PROPERTY LINE
 PREVIOUSLY SURFACE MINED AREA
 ABANDONED DEEP MINE EXTENT
 GAS WELL
 PERENNIAL STREAM
 INTERMITTENT STREAM

MAP KEY TO PREVIOUSLY MINED AREAS
 UPPER FREEPORT CROP LINE
 UP 50' COVER
 UP 100' COVER
 UP 200' COVER
 UP 400' COVER
 UPPER FREEPORT STRUCTURE CONTOUR (BOTTOM)
 SURVEY STATION (SPAD)
 UPPER FREEPORT BOTTOM OF COAL ELEVATION
 TAKEUP DATE
 COAL SECTIONS
 DRILL HOLES
 AREA OF THE MINE NOT VERIFIED BY DEEP MINE SAFETY
 CHECK SURVEY STATION
 PERMANENT STOPPING
 CHECK CURTAIN
 AIR LOCK DOORS
 MAN DOOR
 REGULATOR
 PERMANENT SEALS
 AREAS NOT POSTED DO TO WATER OR BAD ROOF

NOTES:

- 1) PERMIT LIMITS & PROPERTY LINES WERE TAKEN FROM PREVIOUS MAPPING PREPARED BY W.D. MOHNEY & ASSOC., KITTANNING PA. THIS DOES NOT REPRESENT AN ACTUAL SURVEY OF PROPERTIES SHOWN.
- 2) CONTOURS AND NATURAL FEATURES WERE TAKEN FROM ENLARGED 7.5 MIN. WHITESBURG & LEECHBURG U.S.G.S. QUADRANGLES.
- 3) COORDINATES ARE ON A RANDOM DATA BASE RELATIVE TO THIS SITE ONLY. THE TWO CONTROL POINTS NEAR THE MINE ENTRY HAVE RANDOM AND NAD 83 COORDINATES.
- 4) SURVEY ACCURACY PRIOR TO 3-19-05 EXCEEDS 1 IN 5,000. SURVEY ACCURACY AFTER 3-19-05 EXCEEDS 1 IN 10,000.
- 5) THE LAST SURVEY STATION USED IN THE MINE IS NUMBER 3236 SURVEY ON 4-11-06. THE FINAL POSTING DATE WAS 4-28-06.
- 6) THIS MINE WAS ORIGINALLY STARTED BY TRIPLE K MINING COMPANY AND THEN TRANSFERRED TO DLR MINING, INC. AND THEN TRANSFERRED TO MEARS ENTERPRISES, INC.

THIS MAP REPRESENTS A COMPLETE AND ACCURATE REPRESENTATION OF ALL EXCAVATIONS AND IS THE "FINAL" MAP.


NAME *Matthew* DATE *5-25-06*
 COMPANY OR CORPORATE OFFICERS

NAME *Don Krumholz* DATE *7/6/06*
 MINE INSPECTOR



ENGINEER DATE *5/24/06*

MAP SHEET LAYOUT

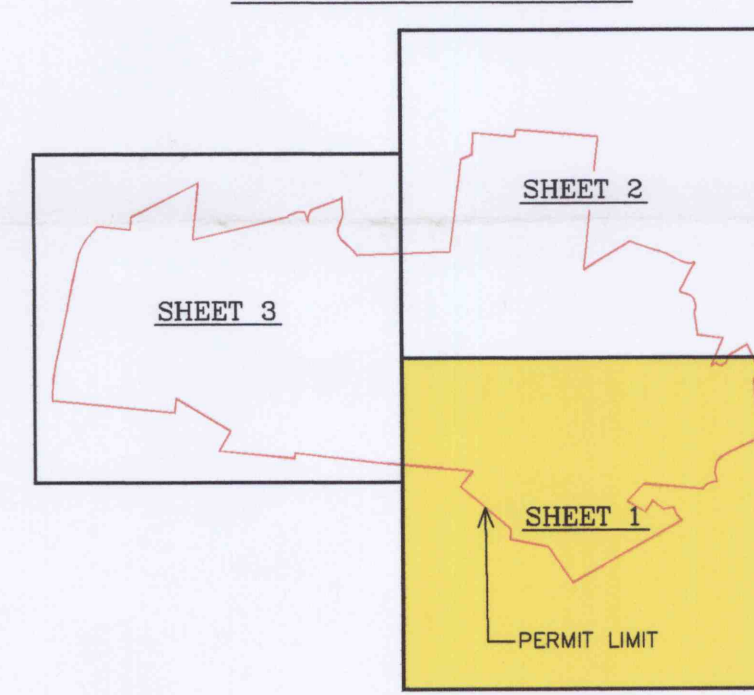

SCALE: 1"=200'

MEARS ENTERPRISES, INC.
 TRIPLE K NO.1 MINE
 1480 REARICK ROAD, FORD CITY, PA 16226
 FINAL MINE MAP
 MSHA ID #36-07962 CMAP #03871302
 UPPER FREEPORT COAL SEAM
 BURRELL, PARKS AND KISKIMINETAS TOWNSHIPS
 ARMSTRONG COUNTY, PA

MAP PREPARED BY:
APPLIGATE SERVICES, INC.
 P.O. Box 368, Elderton, PA 15736
 • ENGINEERING • FORESTRY • SURVEYING
 PHONE (724) 354-4772 FAX (724) 354-4773

DRAWN BY:
 CLS
 CHECKED BY:
 GGG
 DRAWING NO.
 1 OF 3

