


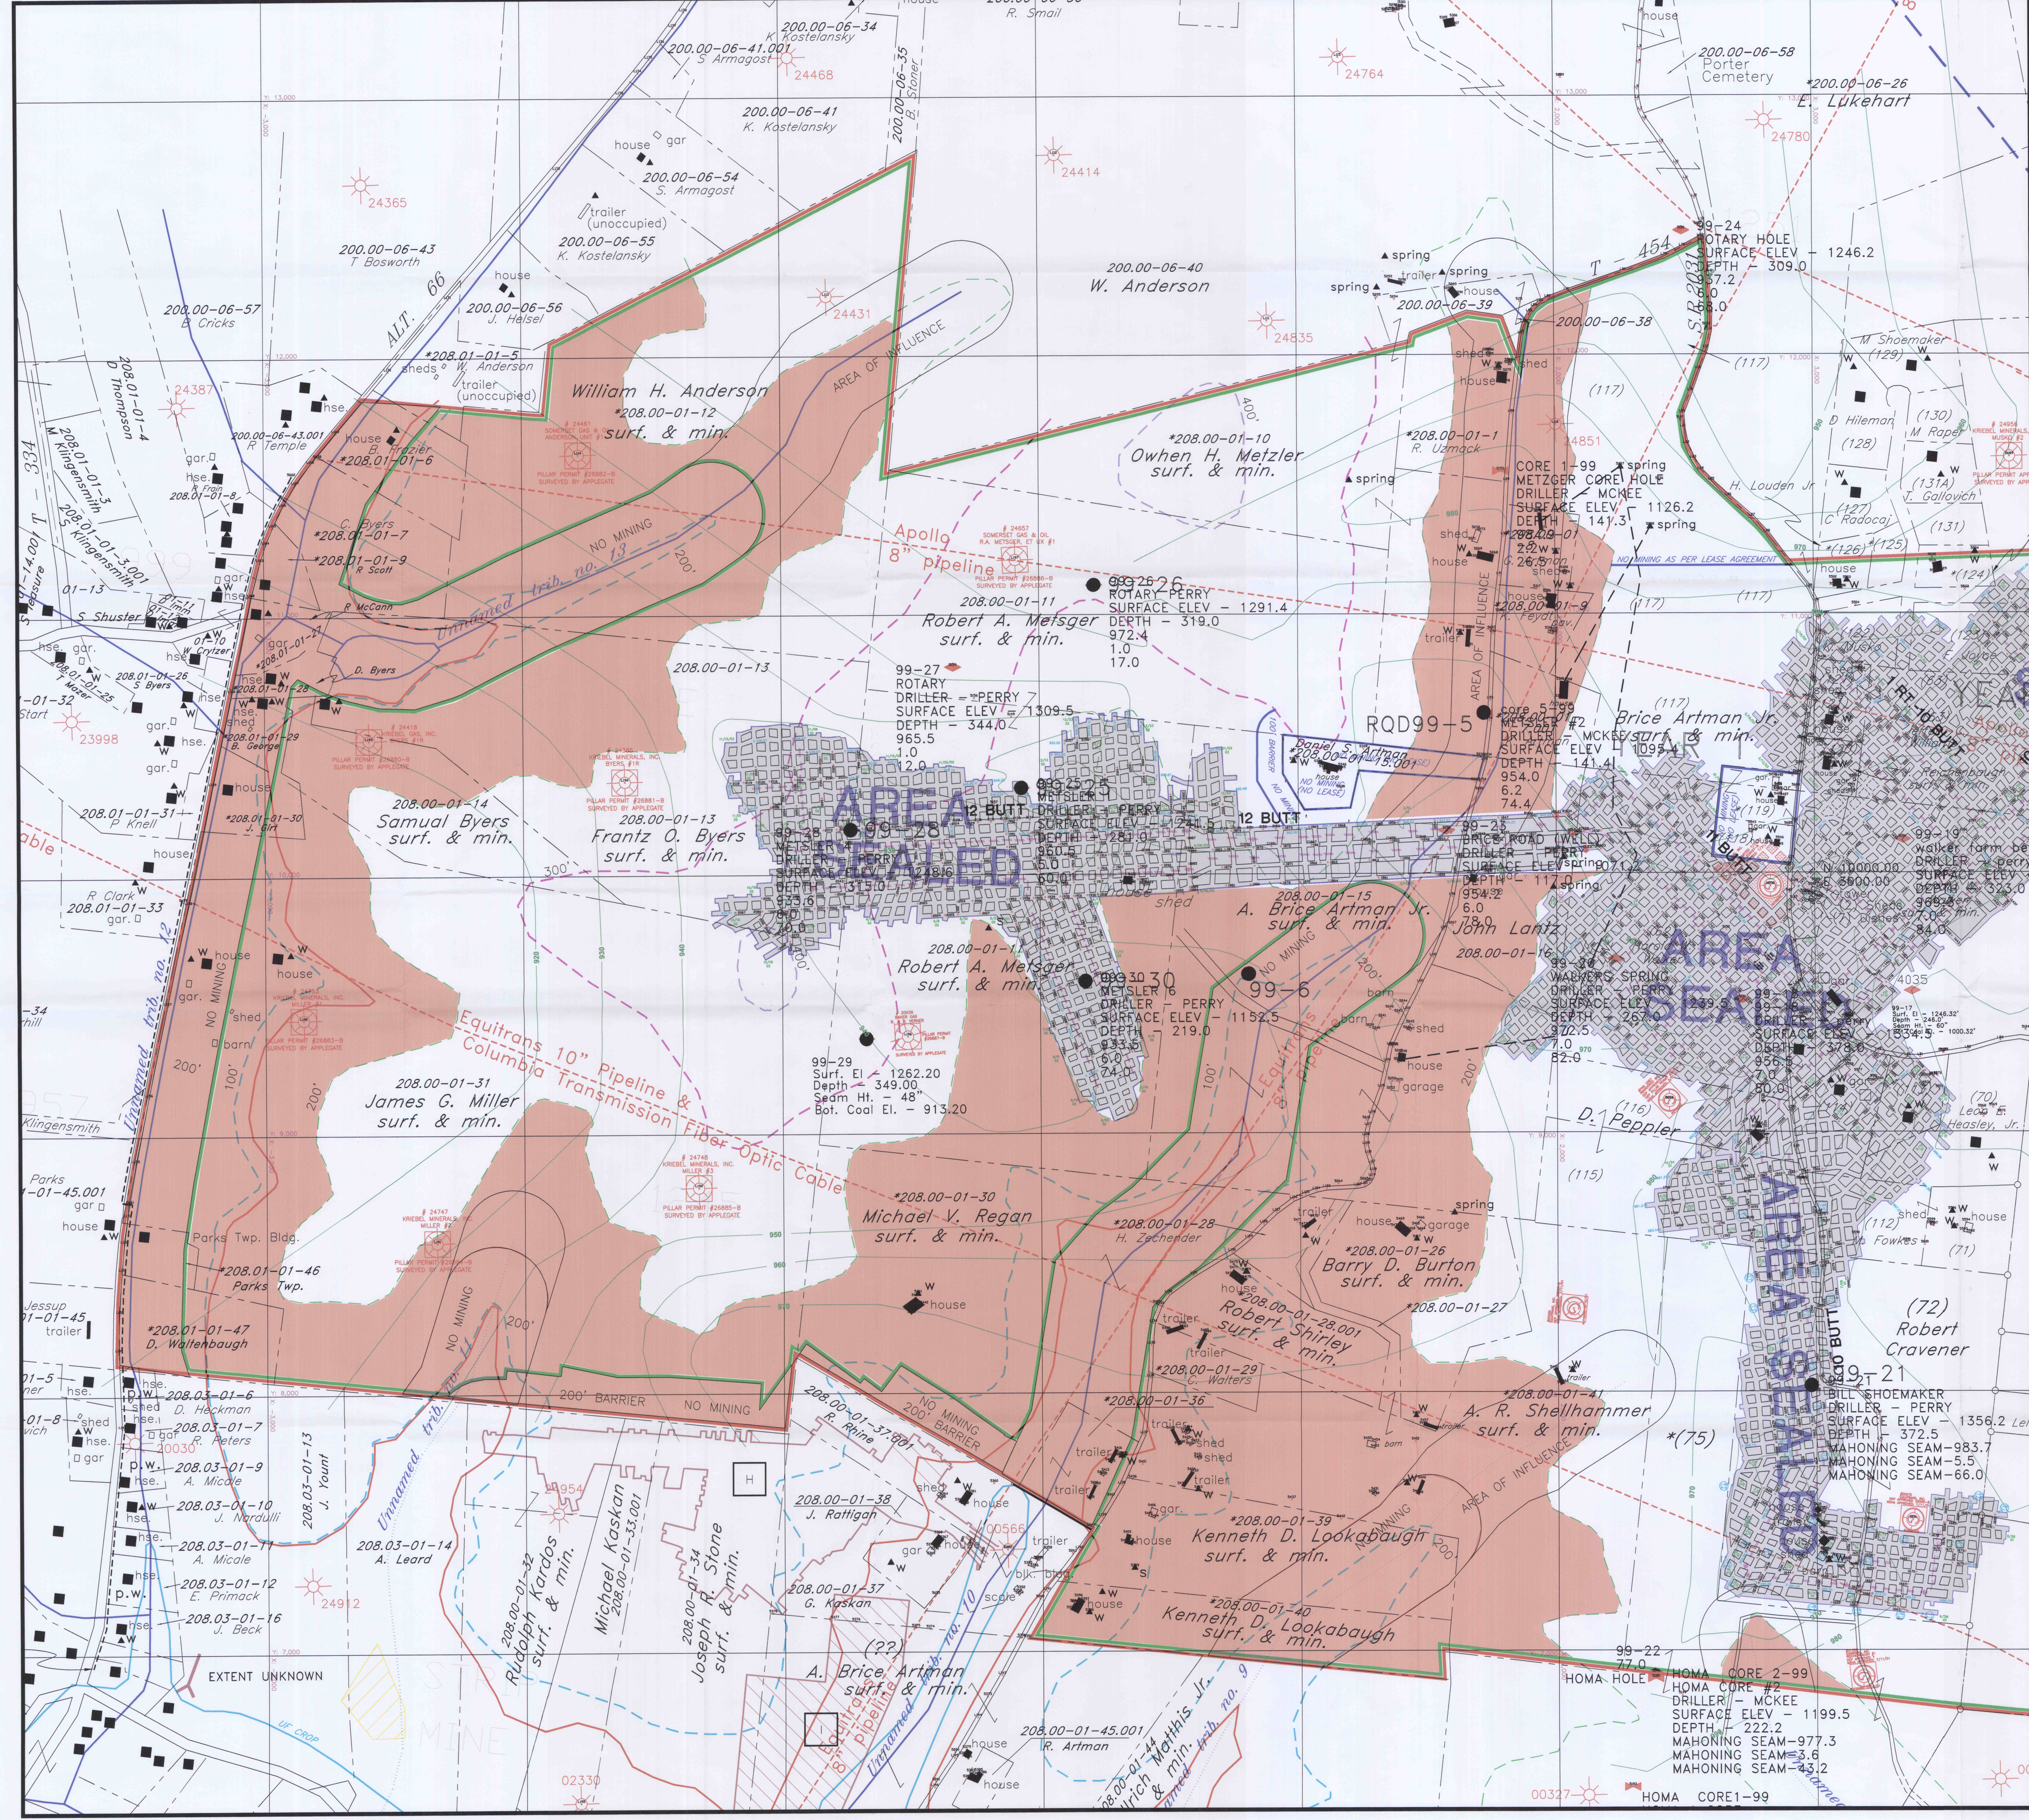

LEGEND

- UNDERGROUND PERMIT AREA (1792 AC.)
- SUBSIDENCE CONTROL BOUNDARY (333.6 AC.)
- SOLID COAL BARRIER-NO MINING
- DWELLING
- UNOCCUPIED STRUCTURE
- WATER WELL
- KEY NO. TO INDIVIDUAL PROPERTY OWNERS
- NO MINING UNTIL LEASE AGREEMENT
- PROPERTY LINE
- PREVIOUSLY SURFACE MINED AREA
- ABANDONED DEEP MINE EXTENT
- GAS WELL
- PERENNIAL STREAM
- INTERMITTENT STREAM
- MAP KEY TO PREVIOUSLY MINED AREAS
- UPPER FREEPORT CROP LINE
- UF 50' COVER
- UF 100' COVER
- UF 200' COVER
- UF 400' COVER
- UPPER FREEPORT STRUCTURE CONTOUR (BOTTOM)
- SURVEY STATION (SPAD)
- UPPER FREEPORT BOTTOM OF COAL ELEVATION
- TAKEUP DATE
- COAL SECTIONS
- DRILL HOLES
- AREA OF THE MINE NOT VERIFIED BY DEEP MINE SAFETY
- CHECK SURVEY STATION
- PERMANENT STOPPING
- CHECK CURTAIN
- AIR LOCK DOORS
- MAN DOOR
- REGULATOR
- PERMANENT SEALS
- AREAS NOT POSTED DO TO WATER OR BAD ROOF

NOTES:

- 1) PERMIT LIMITS & PROPERTY LINES WERE TAKEN FROM PREVIOUS MAPPING PREPARED BY W.D. MOHNEY & ASSOC., KITTANNING PA. THIS DOES NOT REPRESENT AN ACTUAL SURVEY OF PROPERTIES SHOWN.
- 2) CONTOURS AND NATURAL FEATURES WERE TAKEN FROM ENLARGED 7.5 MIN. WHITESBURG & LEECHBURG U.S.G.S. QUADRANGLES.
- 3) COORDINATES ARE ON A RANDOM DATA BASE RELATIVE TO THIS SITE ONLY. THE TWO CONTROL POINTS NEAR THE MINE ENTRY HAVE RANDOM AND NAD 83 COORDINATES.
- 4) SURVEY ACCURACY PRIOR TO 3-18-06 EXCEEDS 1 IN 5,000. SURVEY ACCURACY AFTER 3-18-06 EXCEEDS 1 IN 10,000.
- 5) THE LAST SURVEY STATION USED IN THE MINE IS NUMBER 3236 SURVEY ON 4-11-06. THE FINAL POSTING DATE WAS 4-28-06.
- 6) THIS MINE WAS ORIGINALLY STARTED BY TRIPLE K MINING COMPANY AND THEN TRANSFERRED TO DLK MINING, INC. AND THEN TRANSFERRED TO MEARS ENTERPRISES, INC.

THIS MAP REPRESENTS A COMPLETE AND ACCURATE REPRESENTATION OF ALL EXCAVATIONS AND IS THE "FINAL" MAP.

NAME Michael V. Regan DATE 5-21-06
COMPANY OR CORPORATE OFFICERS

NAME David W. Gering DATE 7/6/06
MINE INSPECTOR

ENGINEER DATE 5/24/06

MAP SHEET LAYOUT

200' 0 200' 400'
SCALE: 1"=200'

MEARS ENTERPRISES, INC.
TRIPLE K NO.1 MINE
1480 REARICK ROAD, FORD CITY, PA 16226
FINAL MINE MAP

MSHA ID #36-07962 CMAP #03871302
UPPER FREEPORT COAL SEAM
BURRELL, PARKS AND KISKIMINETAS TOWNSHIPS
ARMSTRONG COUNTY, PA

MAP PREPARED BY:
APLEGATE SERVICES, INC.
P.O. Box 365, Elderton, PA 15736
ENGINEERING • FORESTRY • SURVEYING
PHONE (724) 354-4772 FAX (724) 354-4773

DATE 5/24/06
DRAWN BY: CLS
CHECKED BY: GGG
DRAWING NO. 3 OF 3