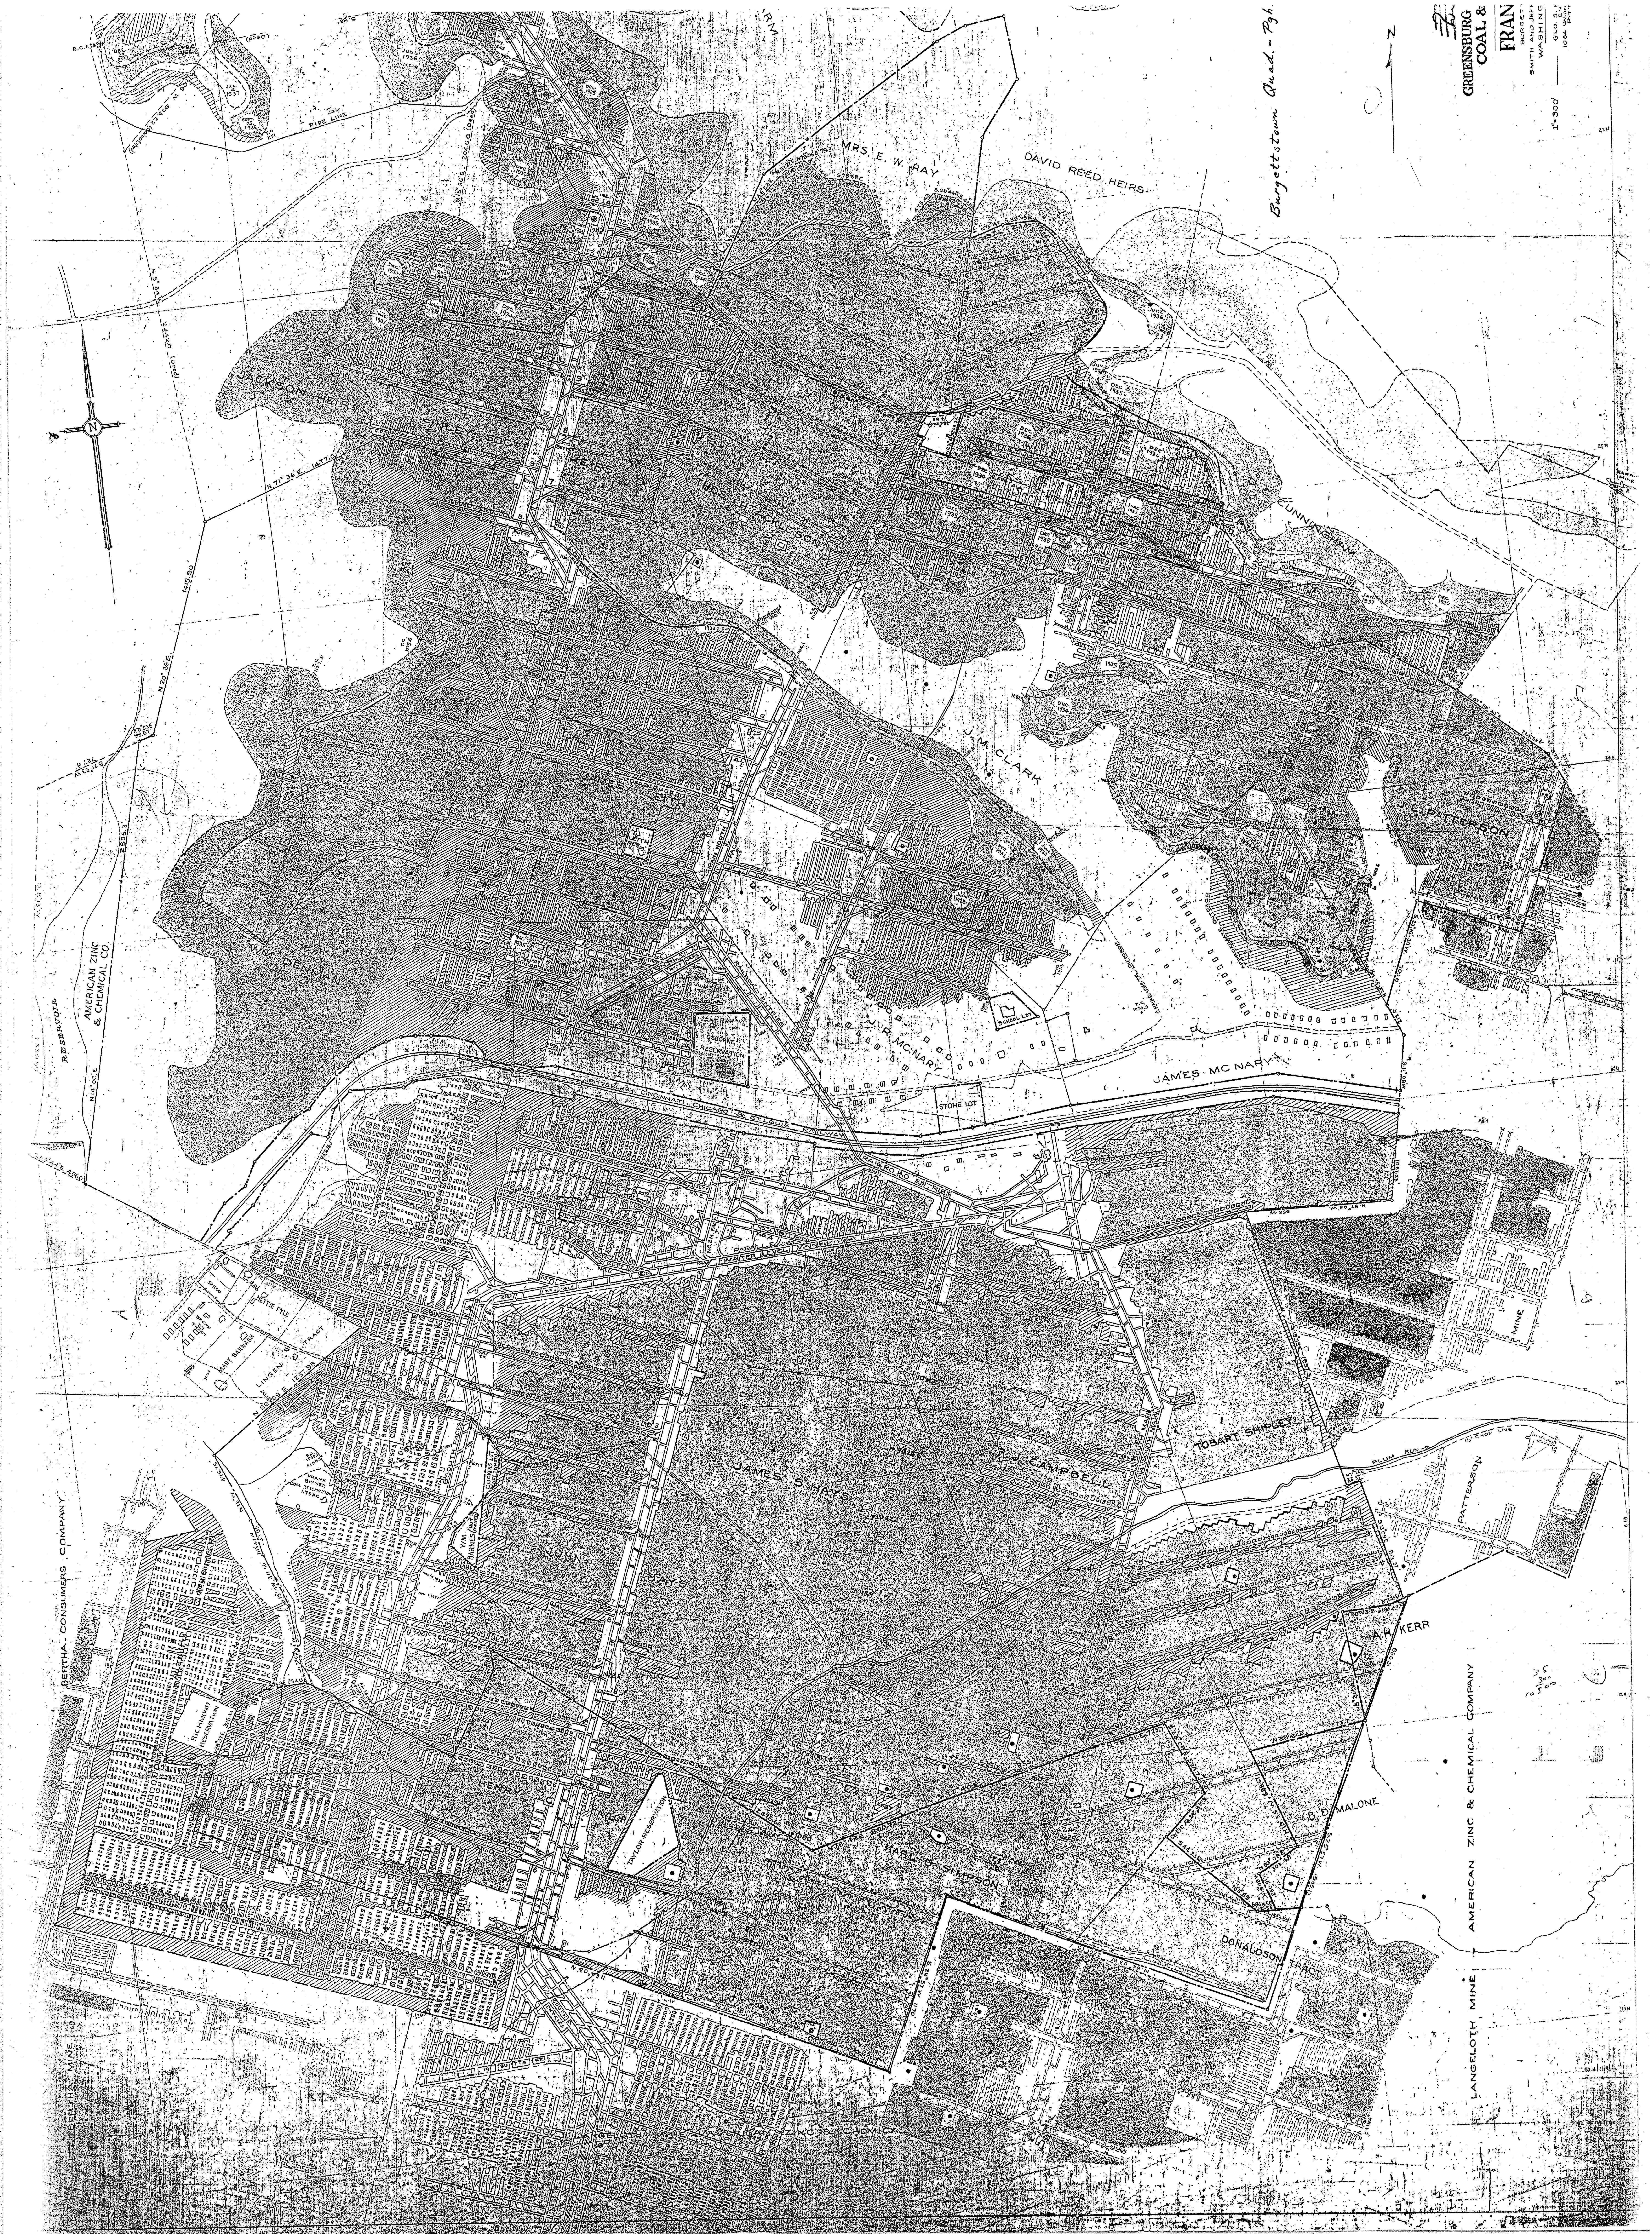
GREENSBURG COAL &
FRAN
BURGETT
SMITH AND JEFF
WASHING
GEO. S.
1064 UNION
PITT
1"=300'
Burgettstown Quad. - Pgh.
N
MRS. E. W. RAY
DAVID REED HEIRS
JACKSON HEIRS
FINLEY SCOTT HEIRS
THOS. H. ACKLESON
CUNNINGHAM
J. M. CLARK
J. L. PATTERSON
JAMES LEITH
LEITH RES.
WM. DENMAN
AMERICAN ZINC & CHEMICAL CO.
RESERVOIR
OSBORNE RESERVATION
J. R. MCNARY
SCHOOL LOT
STORE LOT
JAMES MCNARY
PITTSBURGH CINCINNATI CHICAGO & ST LOUIS RAILWAY
RAILROAD ENTRIES
WATER LEVEL MAIN
PARALLEL
COLUMBIA
SASCO
NETTIE PYLE
BROWN TRACT
MARY BARNASH
LINGEN TRACT
FRANK BITNER COAL RESERVATION 1.75 AC.
SOUTH FACES
COCKINS LOT (NOT OWNED)
WM. BARNES (NOT OWNED)
JAMES S. HAYS
JOHN B. HAYS
R. J. CAMPBELL
TOBART SHIPLEY
MINE
PLUM RUN
15' CROP LINE
PATTERSON
A. H. KERR
B. D. MALONE
KARL S. SIMPSON
DONALDSON TRACT
HENRY C. TAYLOR
TAYLOR RESERVATION
RICHMOND RESERVATION
BERTHA-CONSUMERS COMPANY
BERTHA MINE
SOUTH ENTRIES
AMERICAN ZINC & CHEMICAL CORP.
LANGELOTH MINE
AMERICAN ZINC & CHEMICAL COMPANY
PIPE LINE
N 71° 36' E 1477.0
1415.90
N 20° 39' E
S 5° 34' E 2442.0 (Deed)
N 15° 56' E 2046.0 (Deed)
N 14° 00' E
2855.3
S 5° 44' E 4060
N 56° 09' E 1257.98
N 87° 08' W
DEC. 1934
DEC. 1935
JUNE 1933
JUNE 1936
JAN. 1937
SEPT. 25 1936
22N
20N
18N
16N
14N
12N
10N