


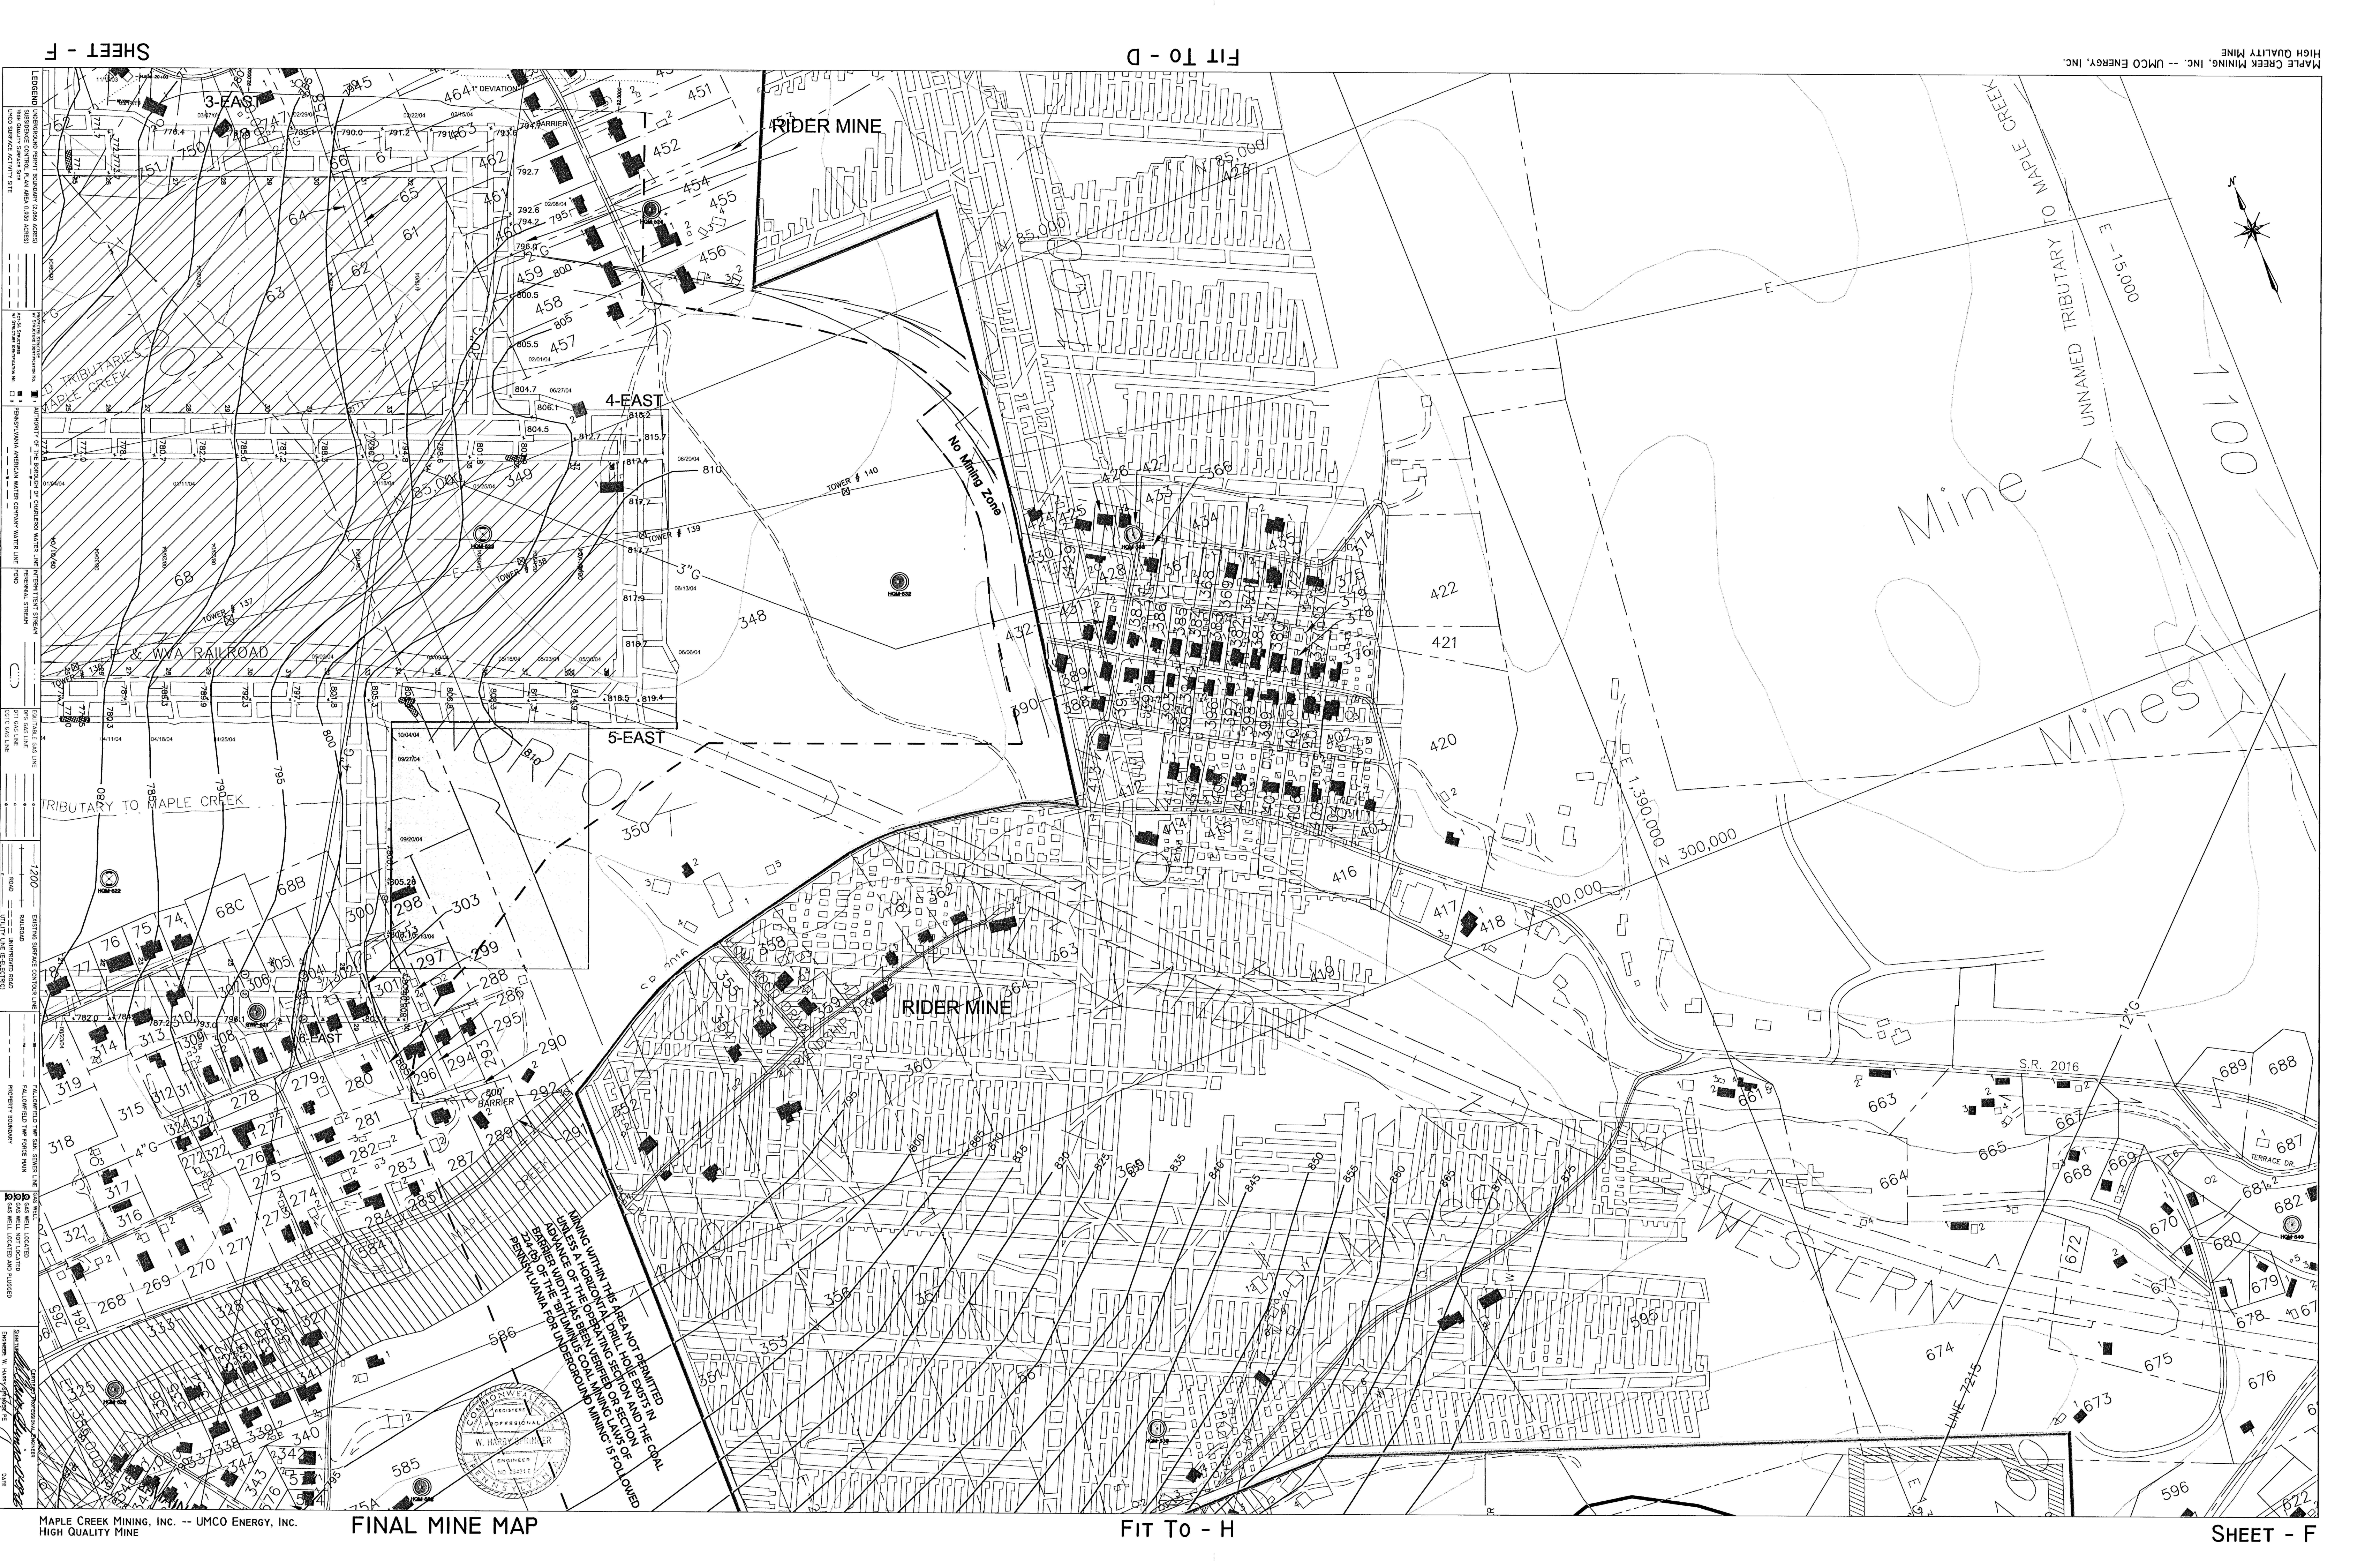

SHEET - F

FIT TO - D

MAPLE CREEK MINING, INC. -- UMCO ENERGY, INC.
HIGH QUALITY MINE

MAPLE CREEK MINING, INC. -- UMCO ENERGY, INC.
HIGH QUALITY MINE

FINAL MINE MAP

FIT TO - H

SHEET - F