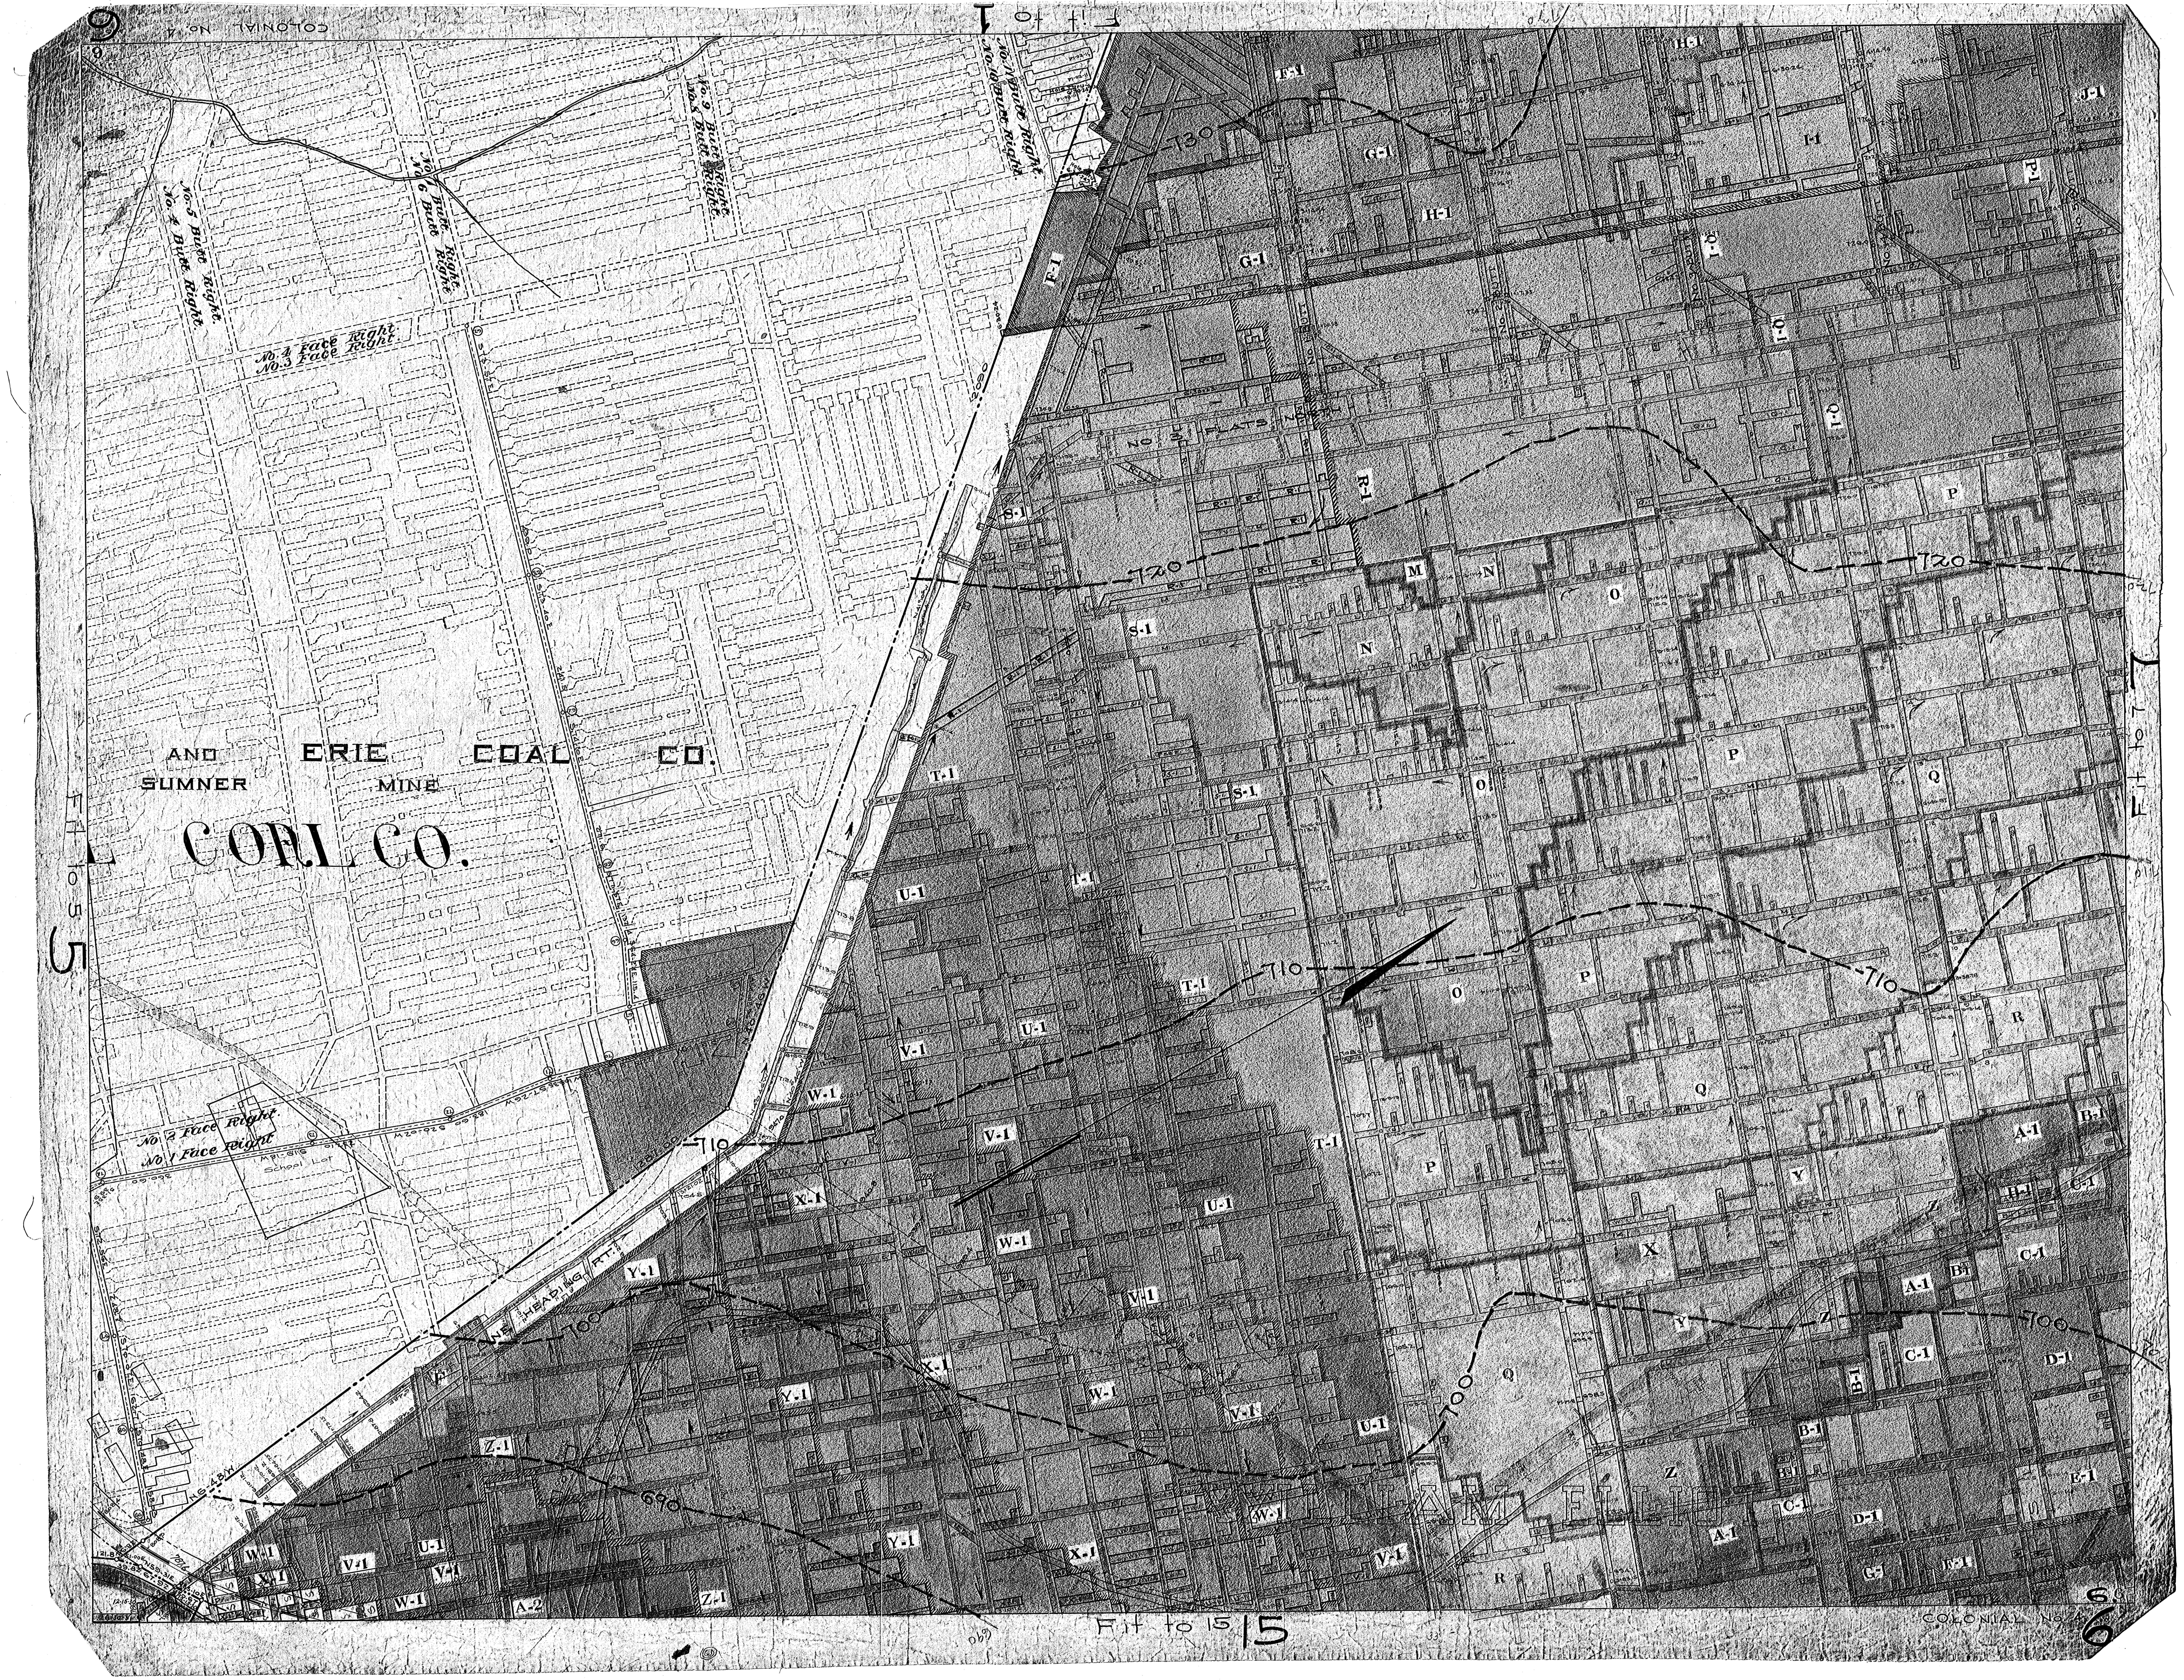
COLONIAL No. 4
6
Fit to 1
No. 11 Butt Right
No. 10 Butt Right
No. 9 Butt Right
No. 8 Butt Right
No. 7 Butt Right
No. 6 Butt Right
No. 5 Butt Right
No. 4 Butt Right
No. 4 Face Right
No. 3 Face Right
No. 2 Face Right
No. 1 Face Right
School Lot
AND ERIE COAL CO.
SUMNER MINE
COAL CO.
Fit to 5
5
NO. 3 FLATS NORTH
HEADING RT.
F-1
G-1
H-1
I-1
J-1
P-1
Q-1
R-1
S-1
T-1
U-1
V-1
W-1
X-1
Y-1
Z-1
A-2
M
N
O
P
Q
R
X
Y
Z
A-1
B-1
C-1
D-1
E-1
G-1
730
720
710
700
690
Fit to 7
7
Fit to 15
15
COLONIAL No. 4
6