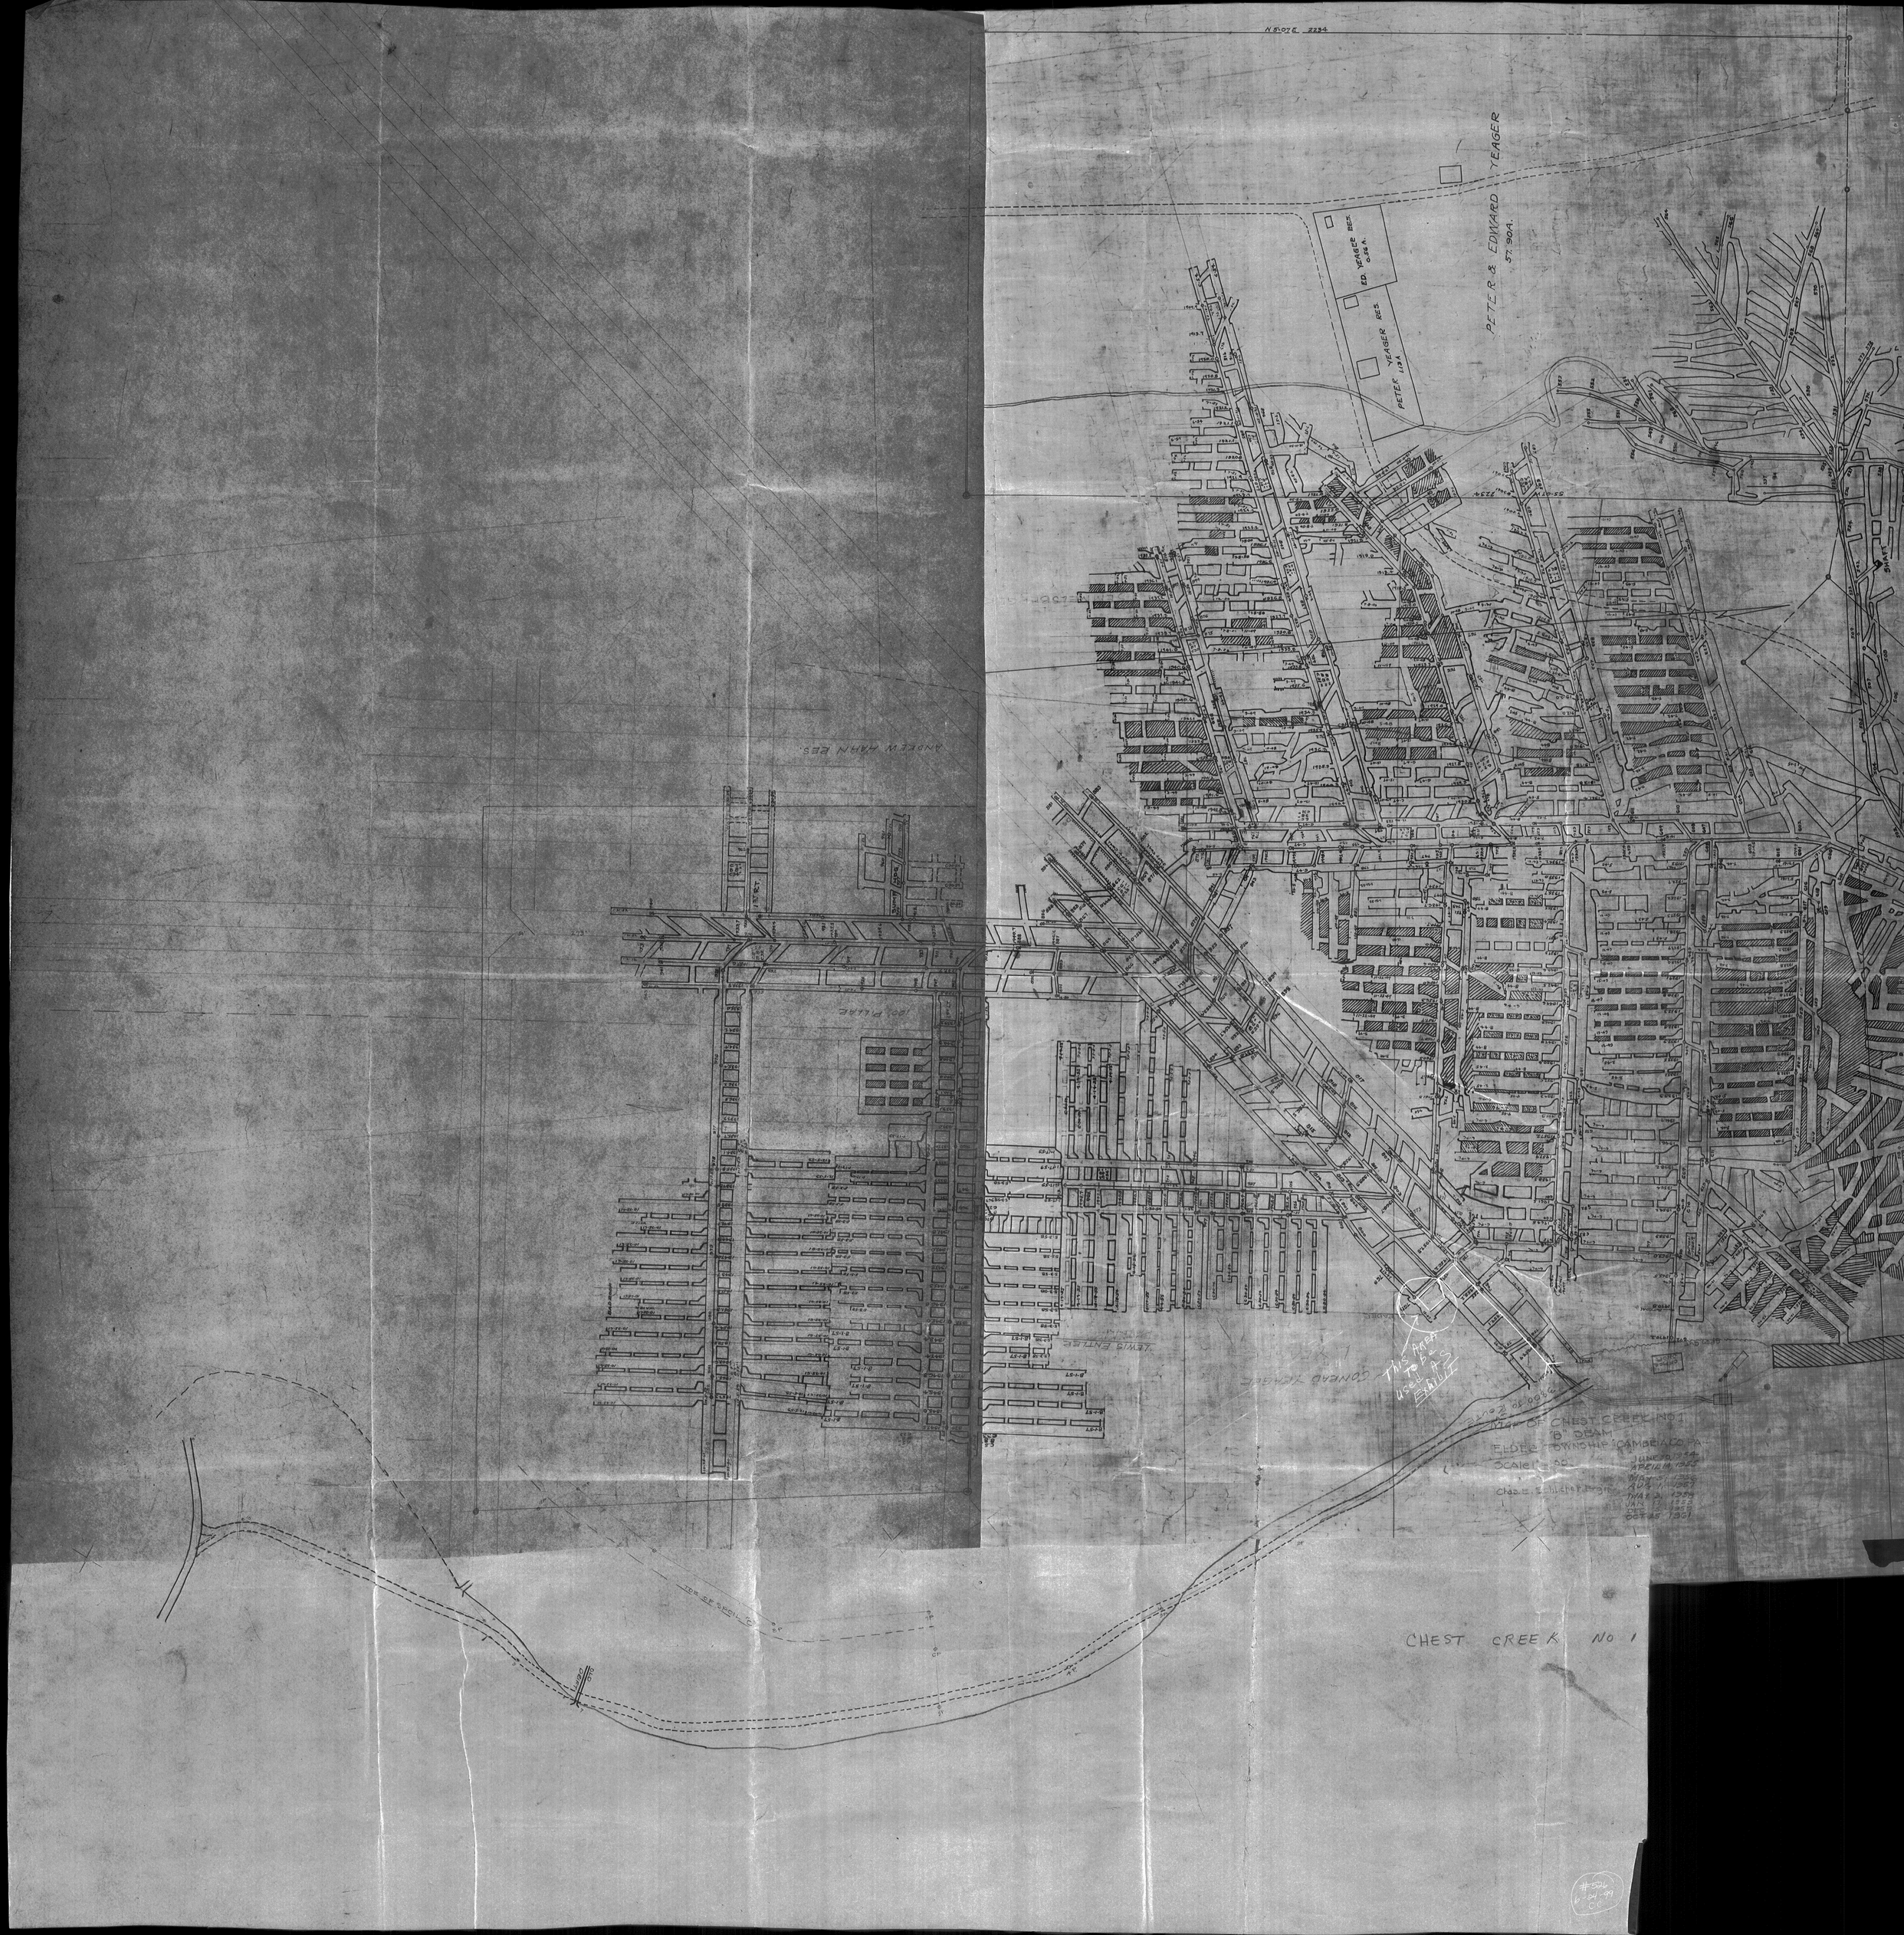
PETER & EDWARD YEAGER
57.90A.
ED. YEAGER RES.
PETER YEAGER RES.
ANDREW HAHN RES.
CONRAD YEAGER
LEWIS ENTLER
This Area To be Used As Exhibit
MAP OF CHEST CREEK NO 1
"B" DEAM
ELDER TOWNSHIP CAMBRIA CO PA
Scale 1" = 100'
JUNE 30, 1954
APRIL 14, 1955
MAY 5, 1956
AUG 1, 1957
MAY 3, 1958
JAN 17, 1959
DEC 5, 1959
OCT 25 1961
Chas. E. Schlicher Engr.
CHEST CREEK NO 1