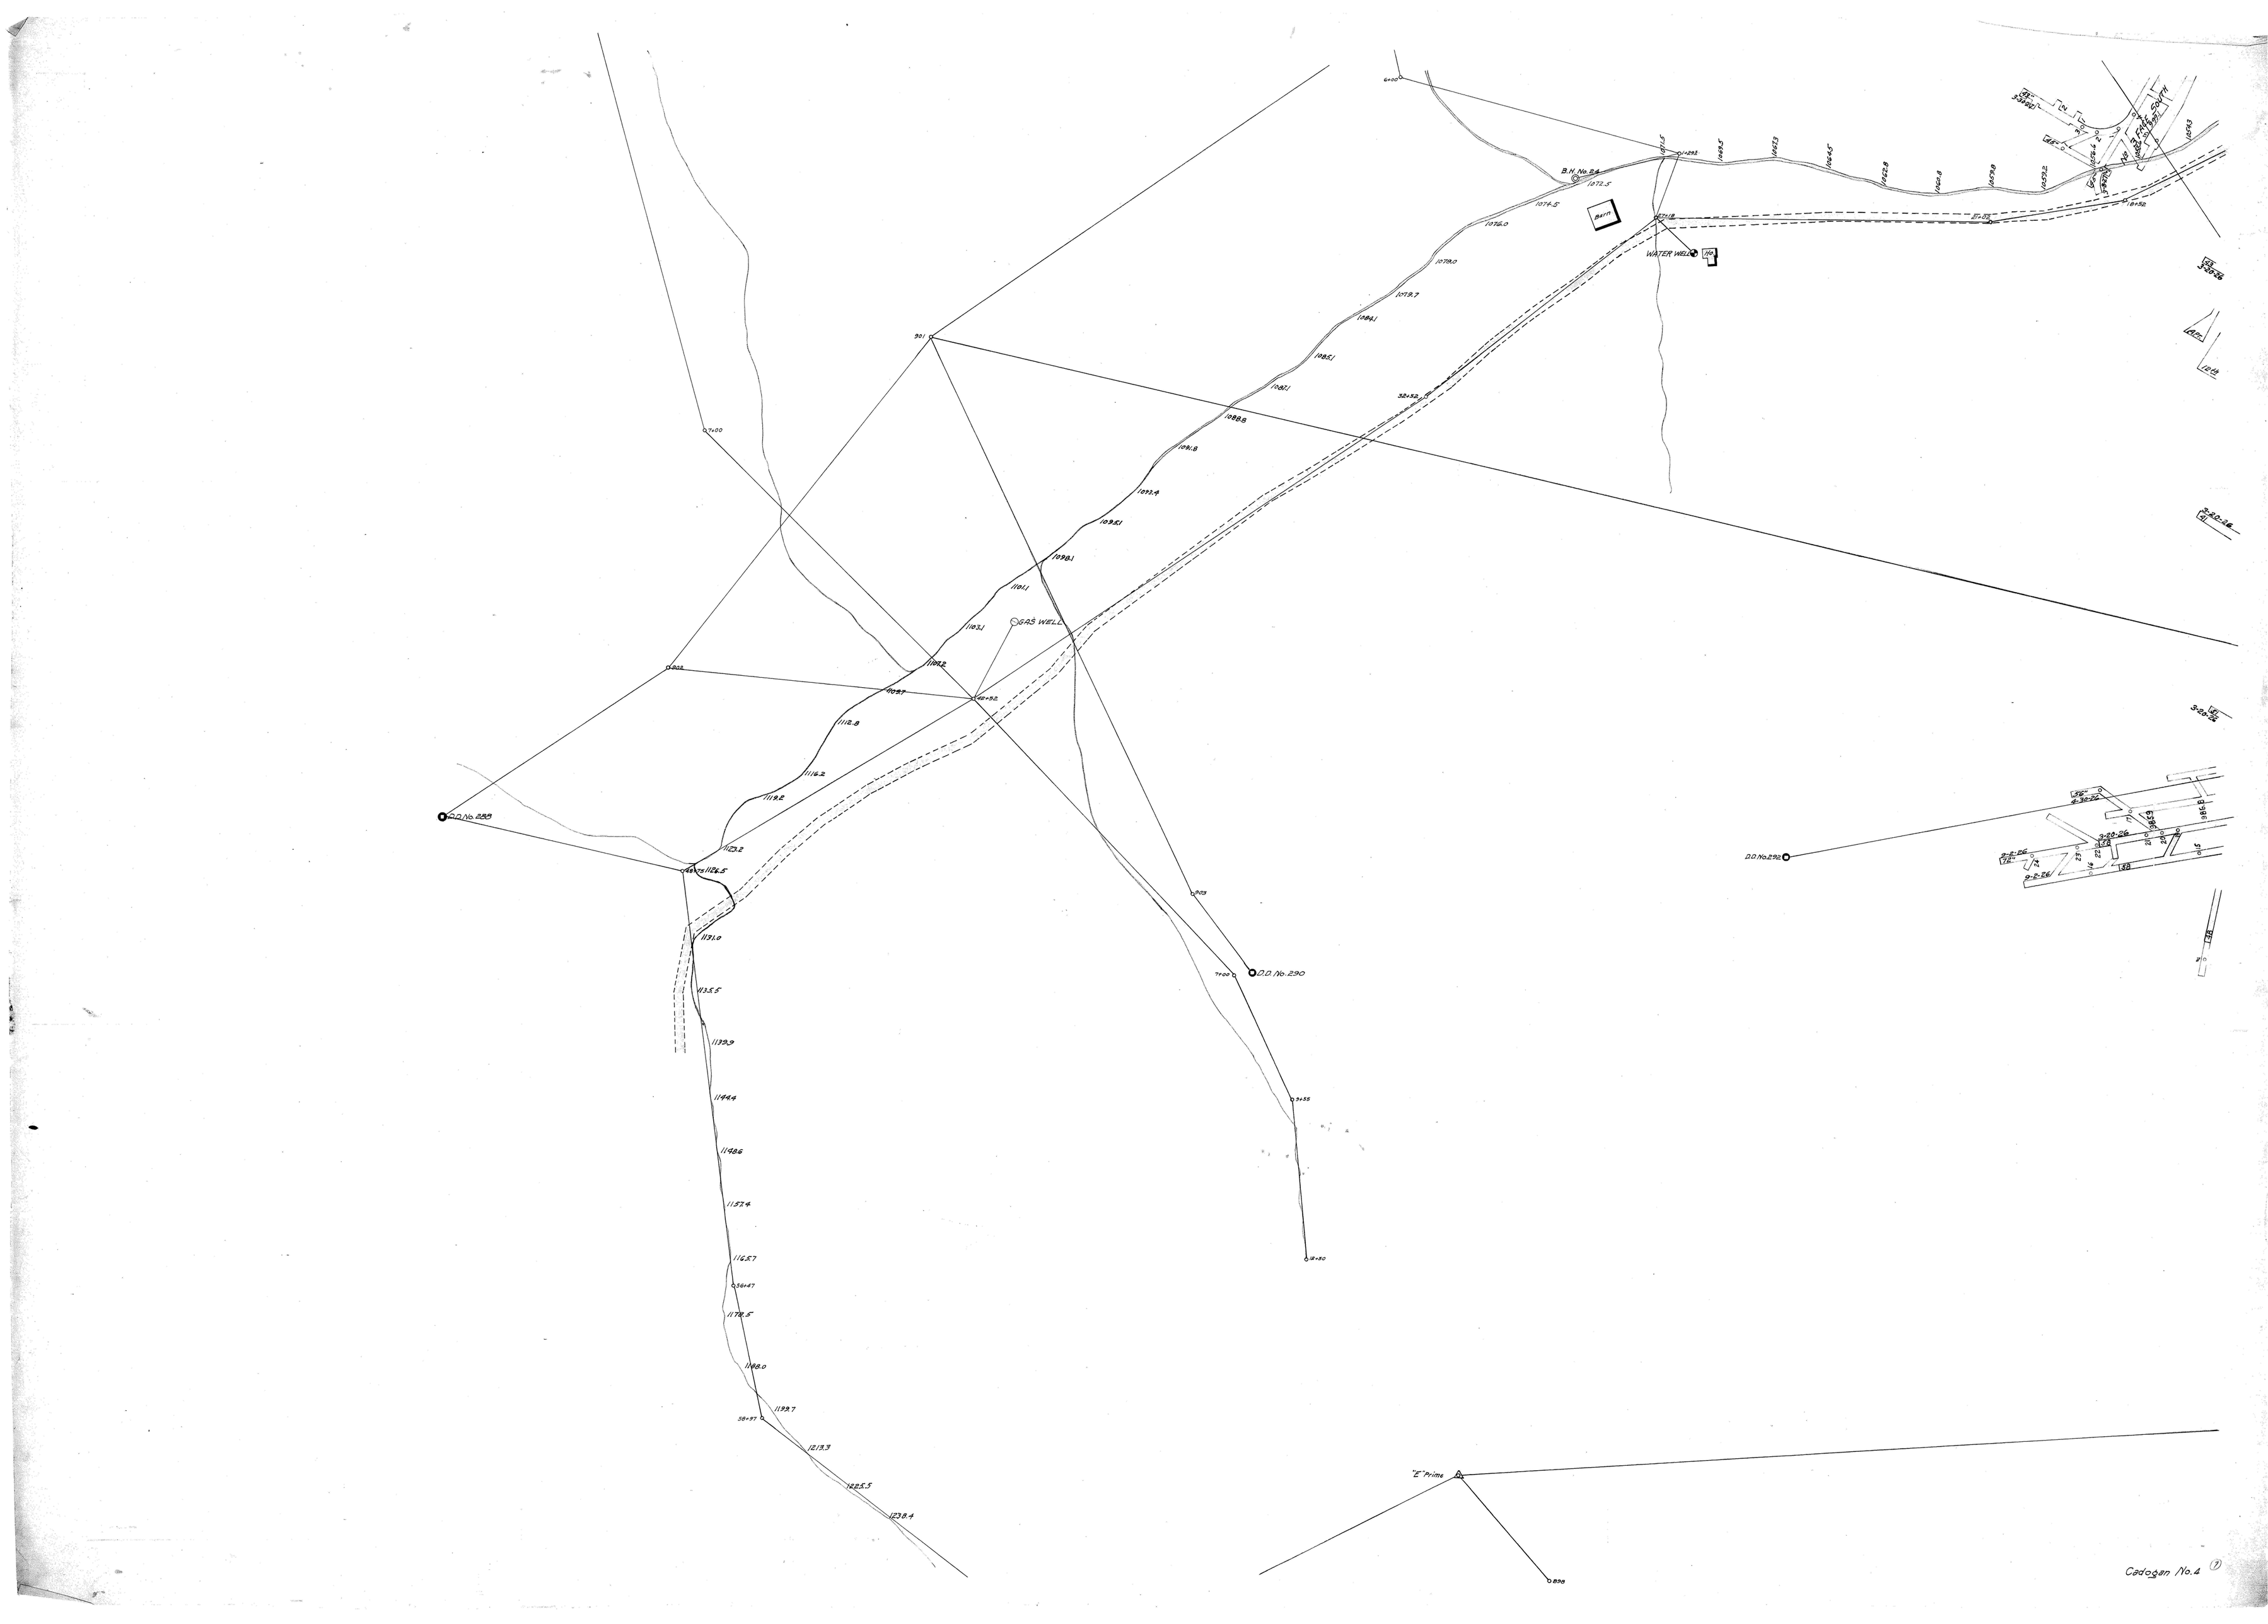
B.H. No. 8A
1072.5
1074.5
1076.0
1078.0
1079.7
1081.1
1083.1
1085.1
1087.1
1088.8
1091.8
1093.4
1095.1
1098.1
1101.1
1103.1
GAS WELL
1106.2
1109.7
1112.8
1116.2
1119.2
1123.2
1126.5
1131.0
1133.5
1139.9
1144.4
1148.6
1157.4
1162.7
1168.5
1168.0
1173.7
1213.3
1225.5
1238.4
Barn
WATER WELL
D.D. No. 288
D.D. No. 290
D.D. No. 292
"E" Prime
Cadogan No. 4