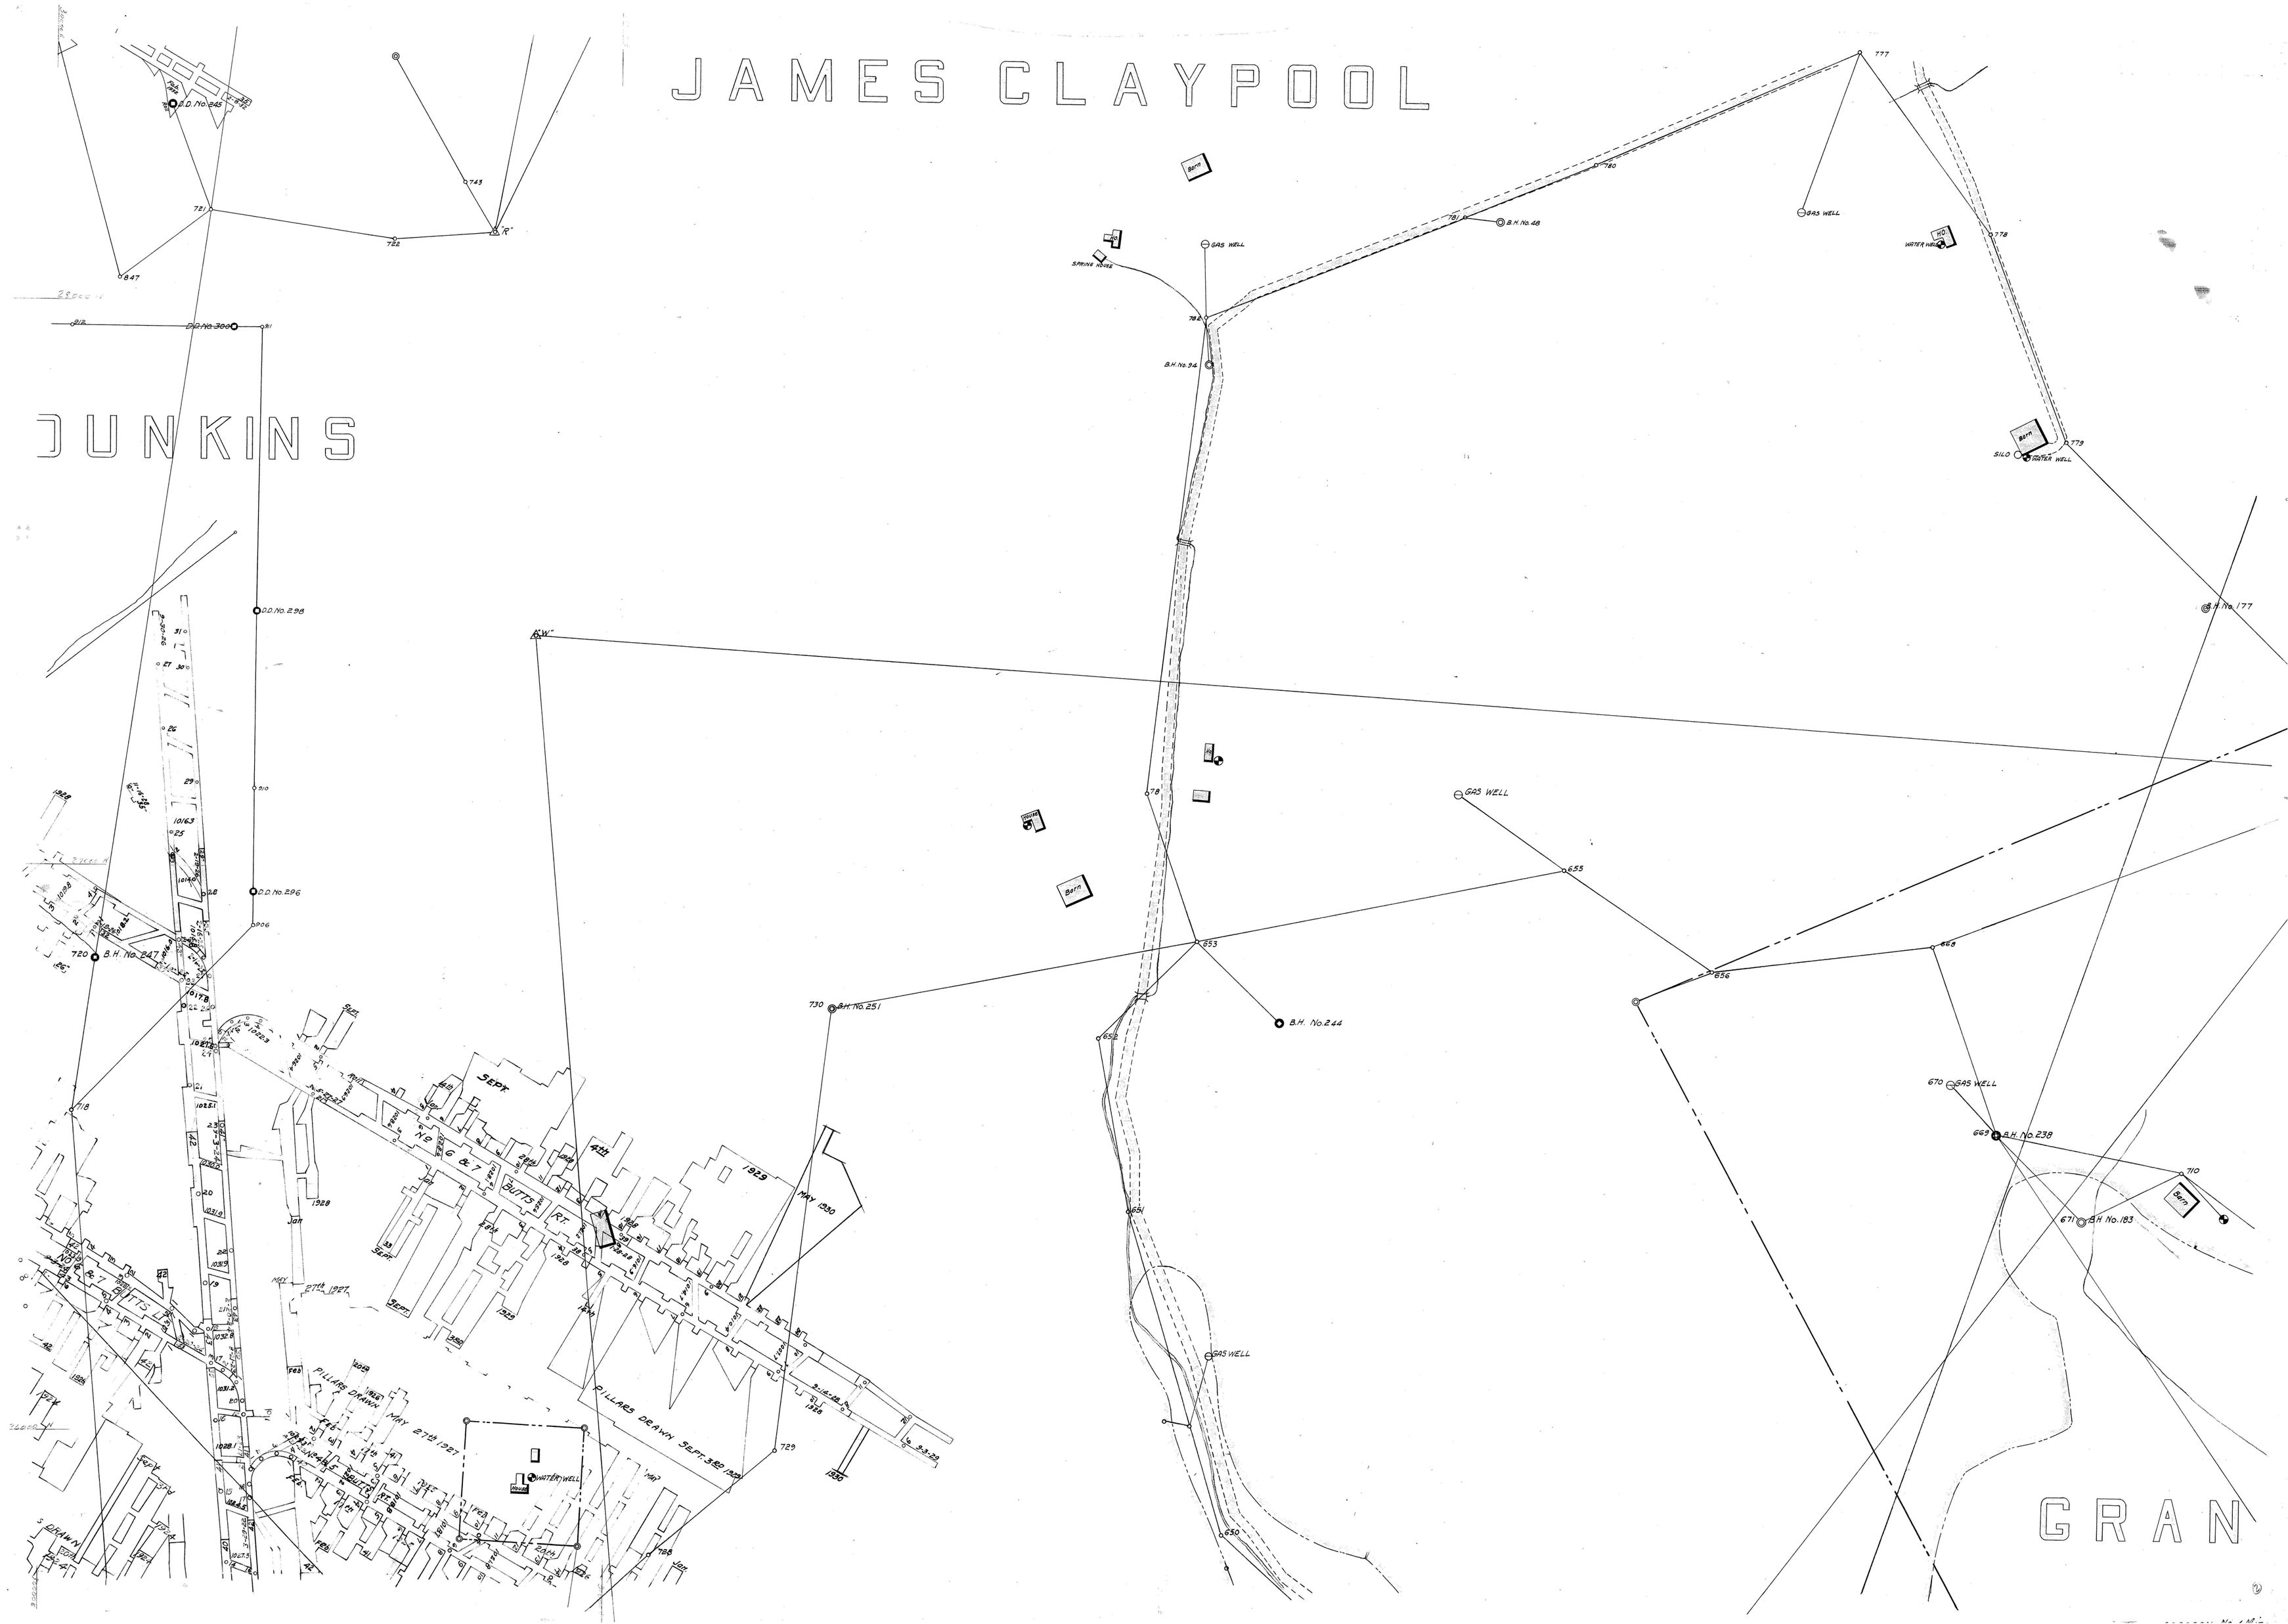
JAMES CLAYPOOL
DUNKINS
GRAN
D.D. No. 845
743
721
722
R"
947
D.D. No. 300
D.D. No. 298
D.D. No. 296
B.H. No. 847
720
718
B.H. No. 251
730
729
728
B.H. No. 244
652
651
650
653
656
655
668
670
669
B.H. No. 238
710
671
B.H. No. 183
B.H. No. 48
B.H. No. 34
B.H. No. 177
780
781
782
777
778
779
GAS WELL
SPRING HOUSE
Barn
WATER WELL
SILO
HO
SEPT
No 6 & 7
BUTTS RT.
4th
1929
MAY 1930
PILLARS DRAWN SEPT. 3RD 1929
PILLARS DRAWN MAY 27th 1927
MAY 27th 1927
No 6 & 7 BUTTS LT.
1928
1926
1925
