


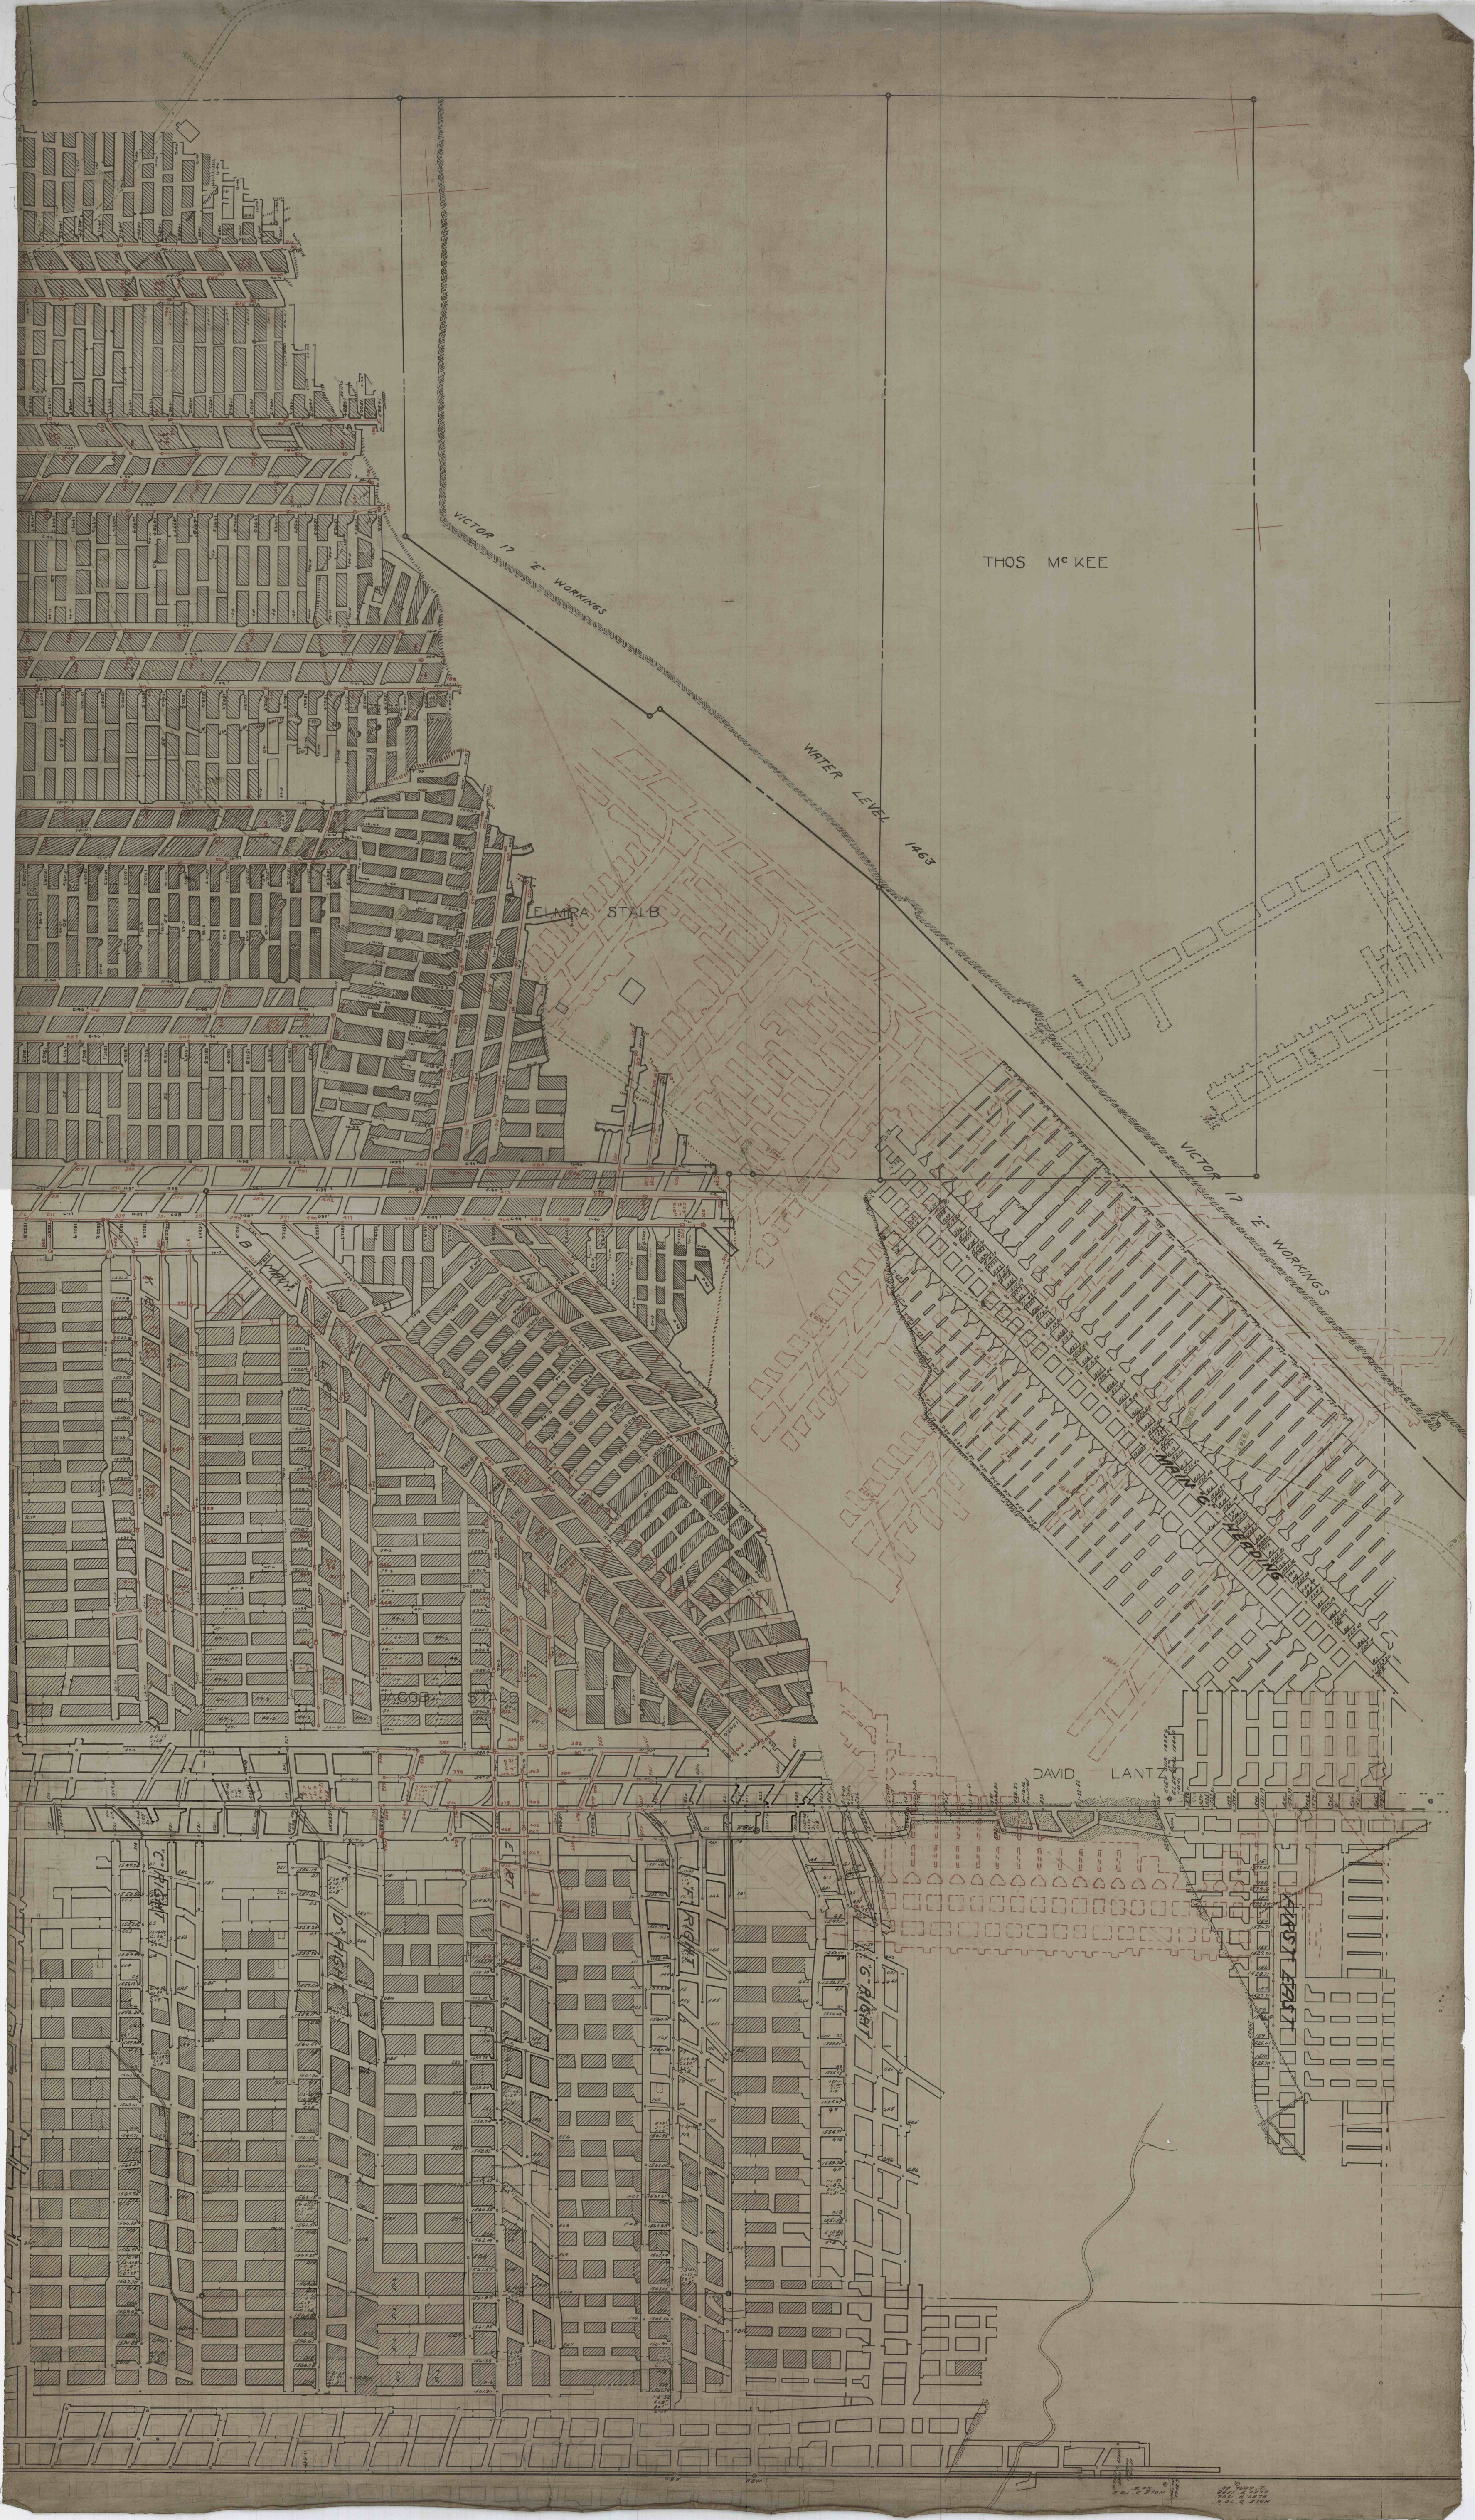

THOS M^cKEE


WATER LEVEL 1463

ELMIRA STALB


JACOB

DAVID LANTZ








