


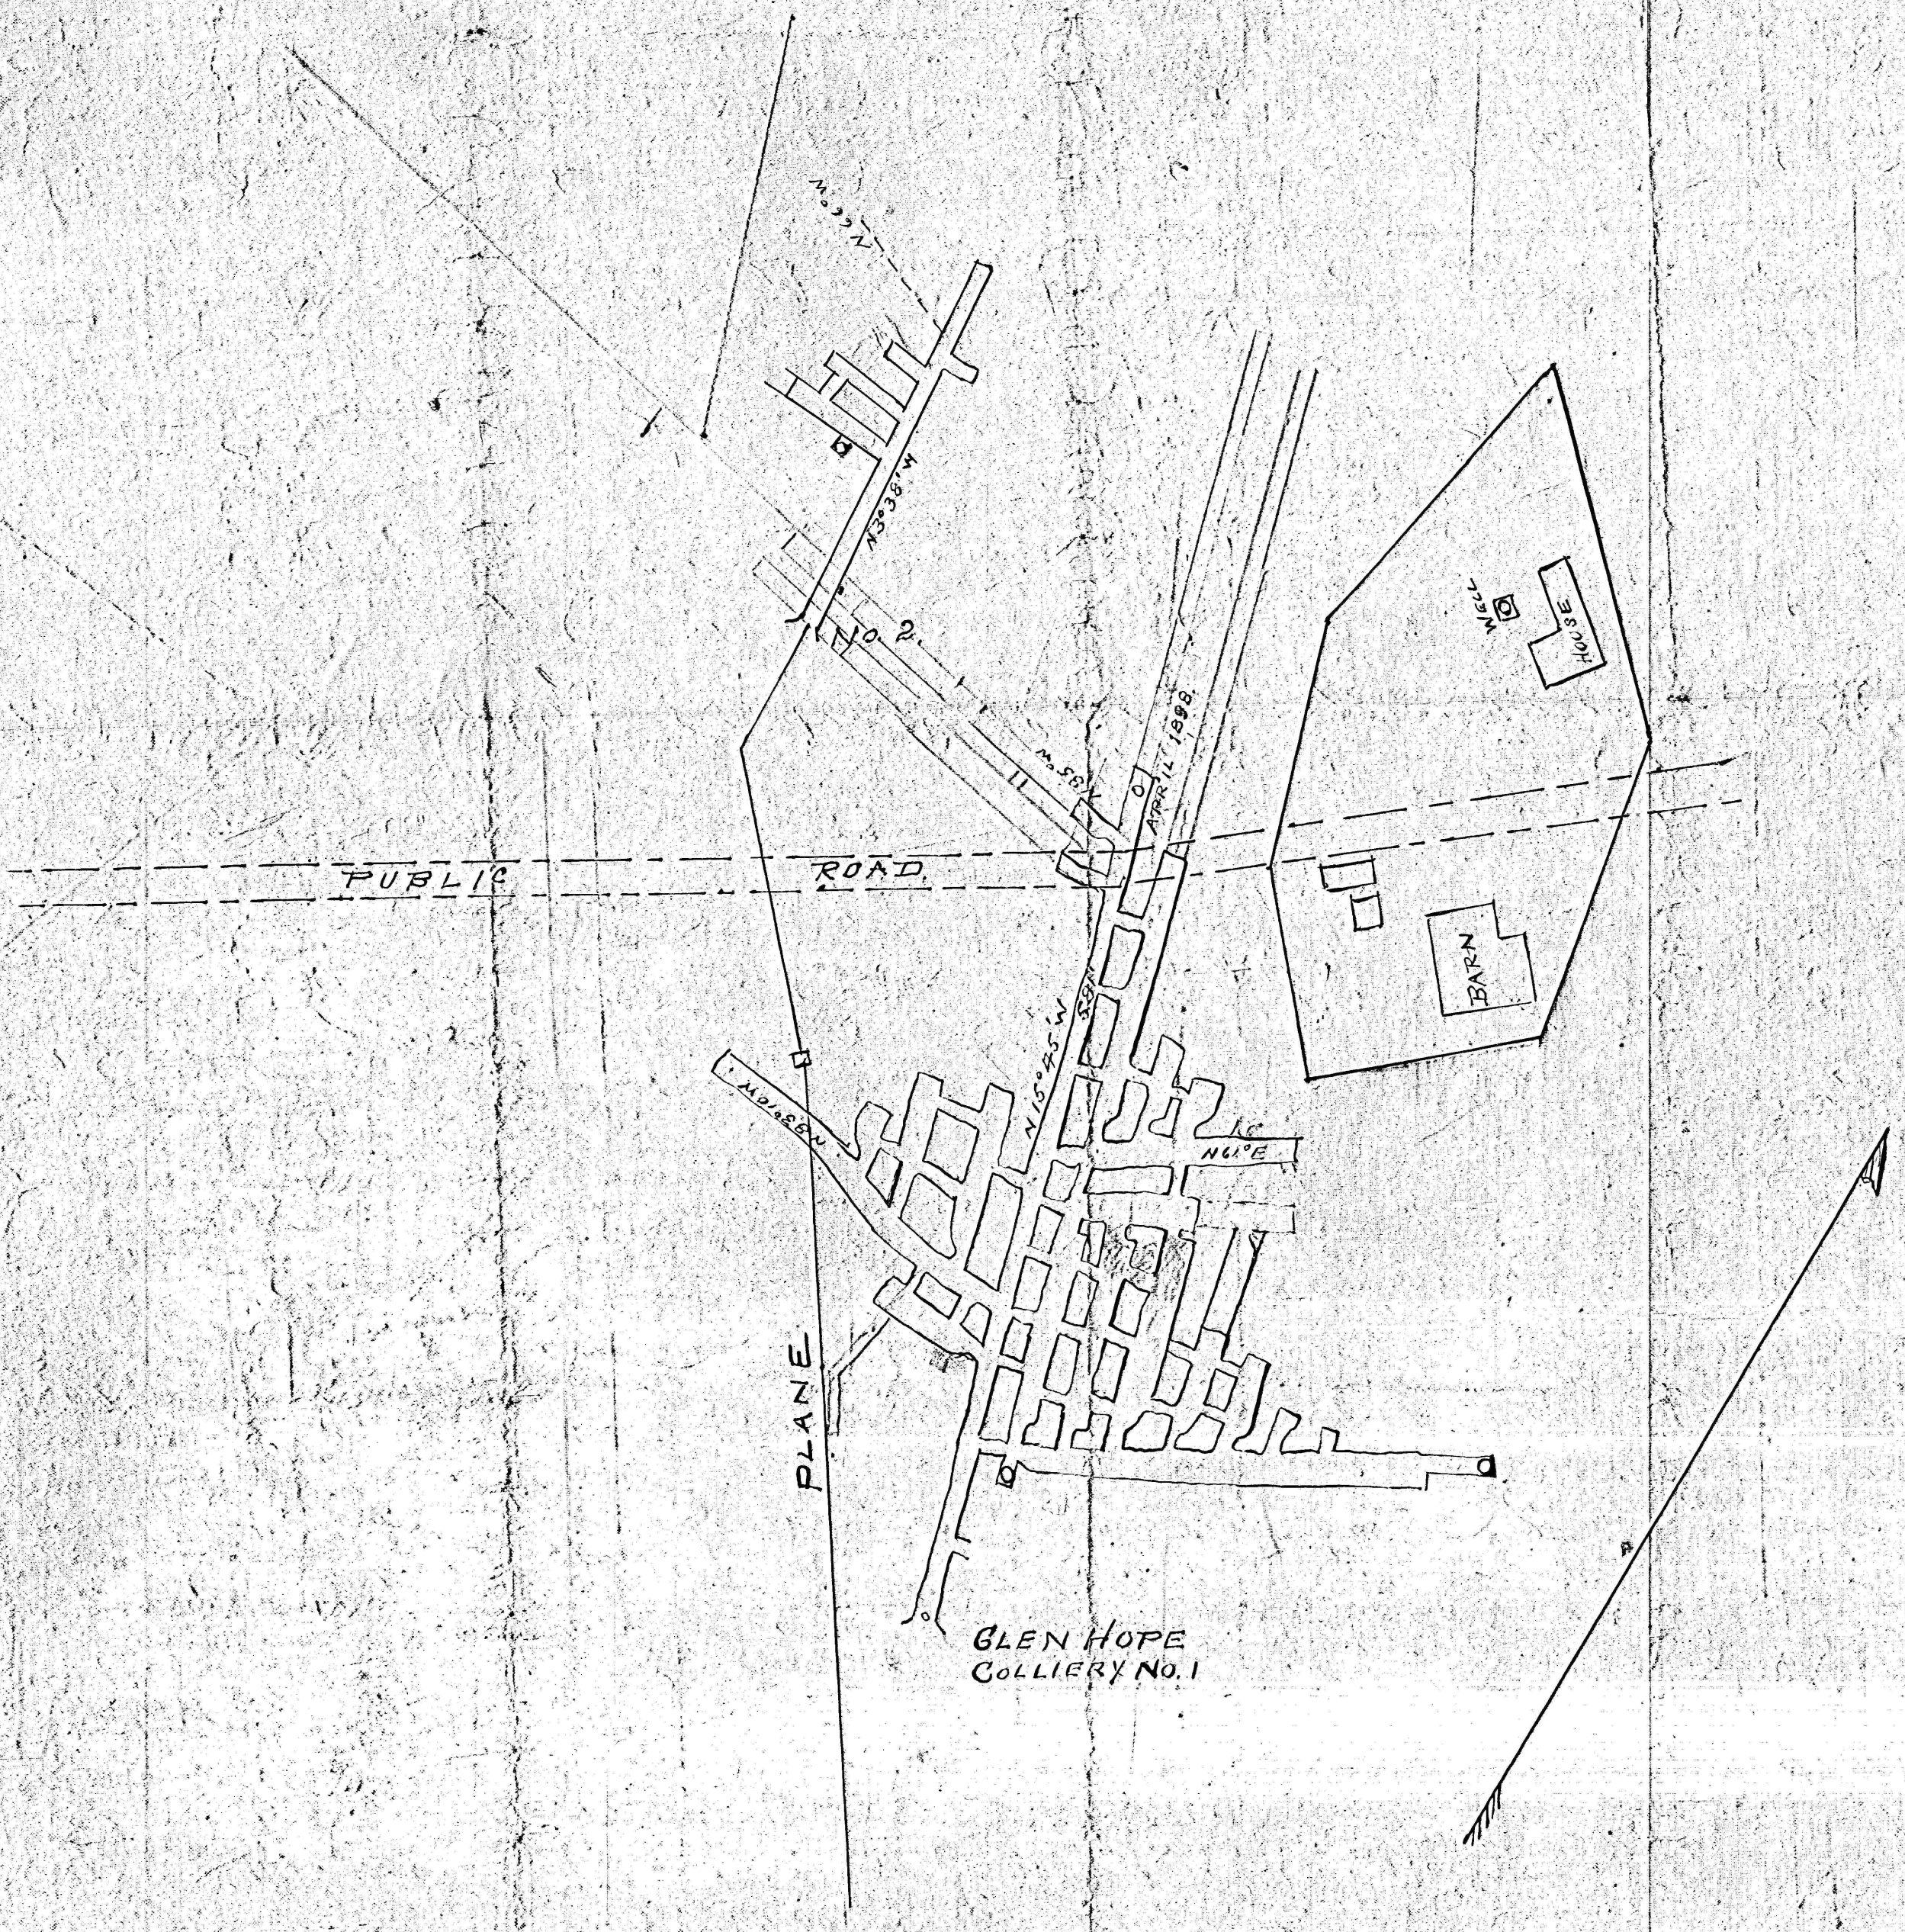

GLEN HOPE
COLLIERY NO. 1