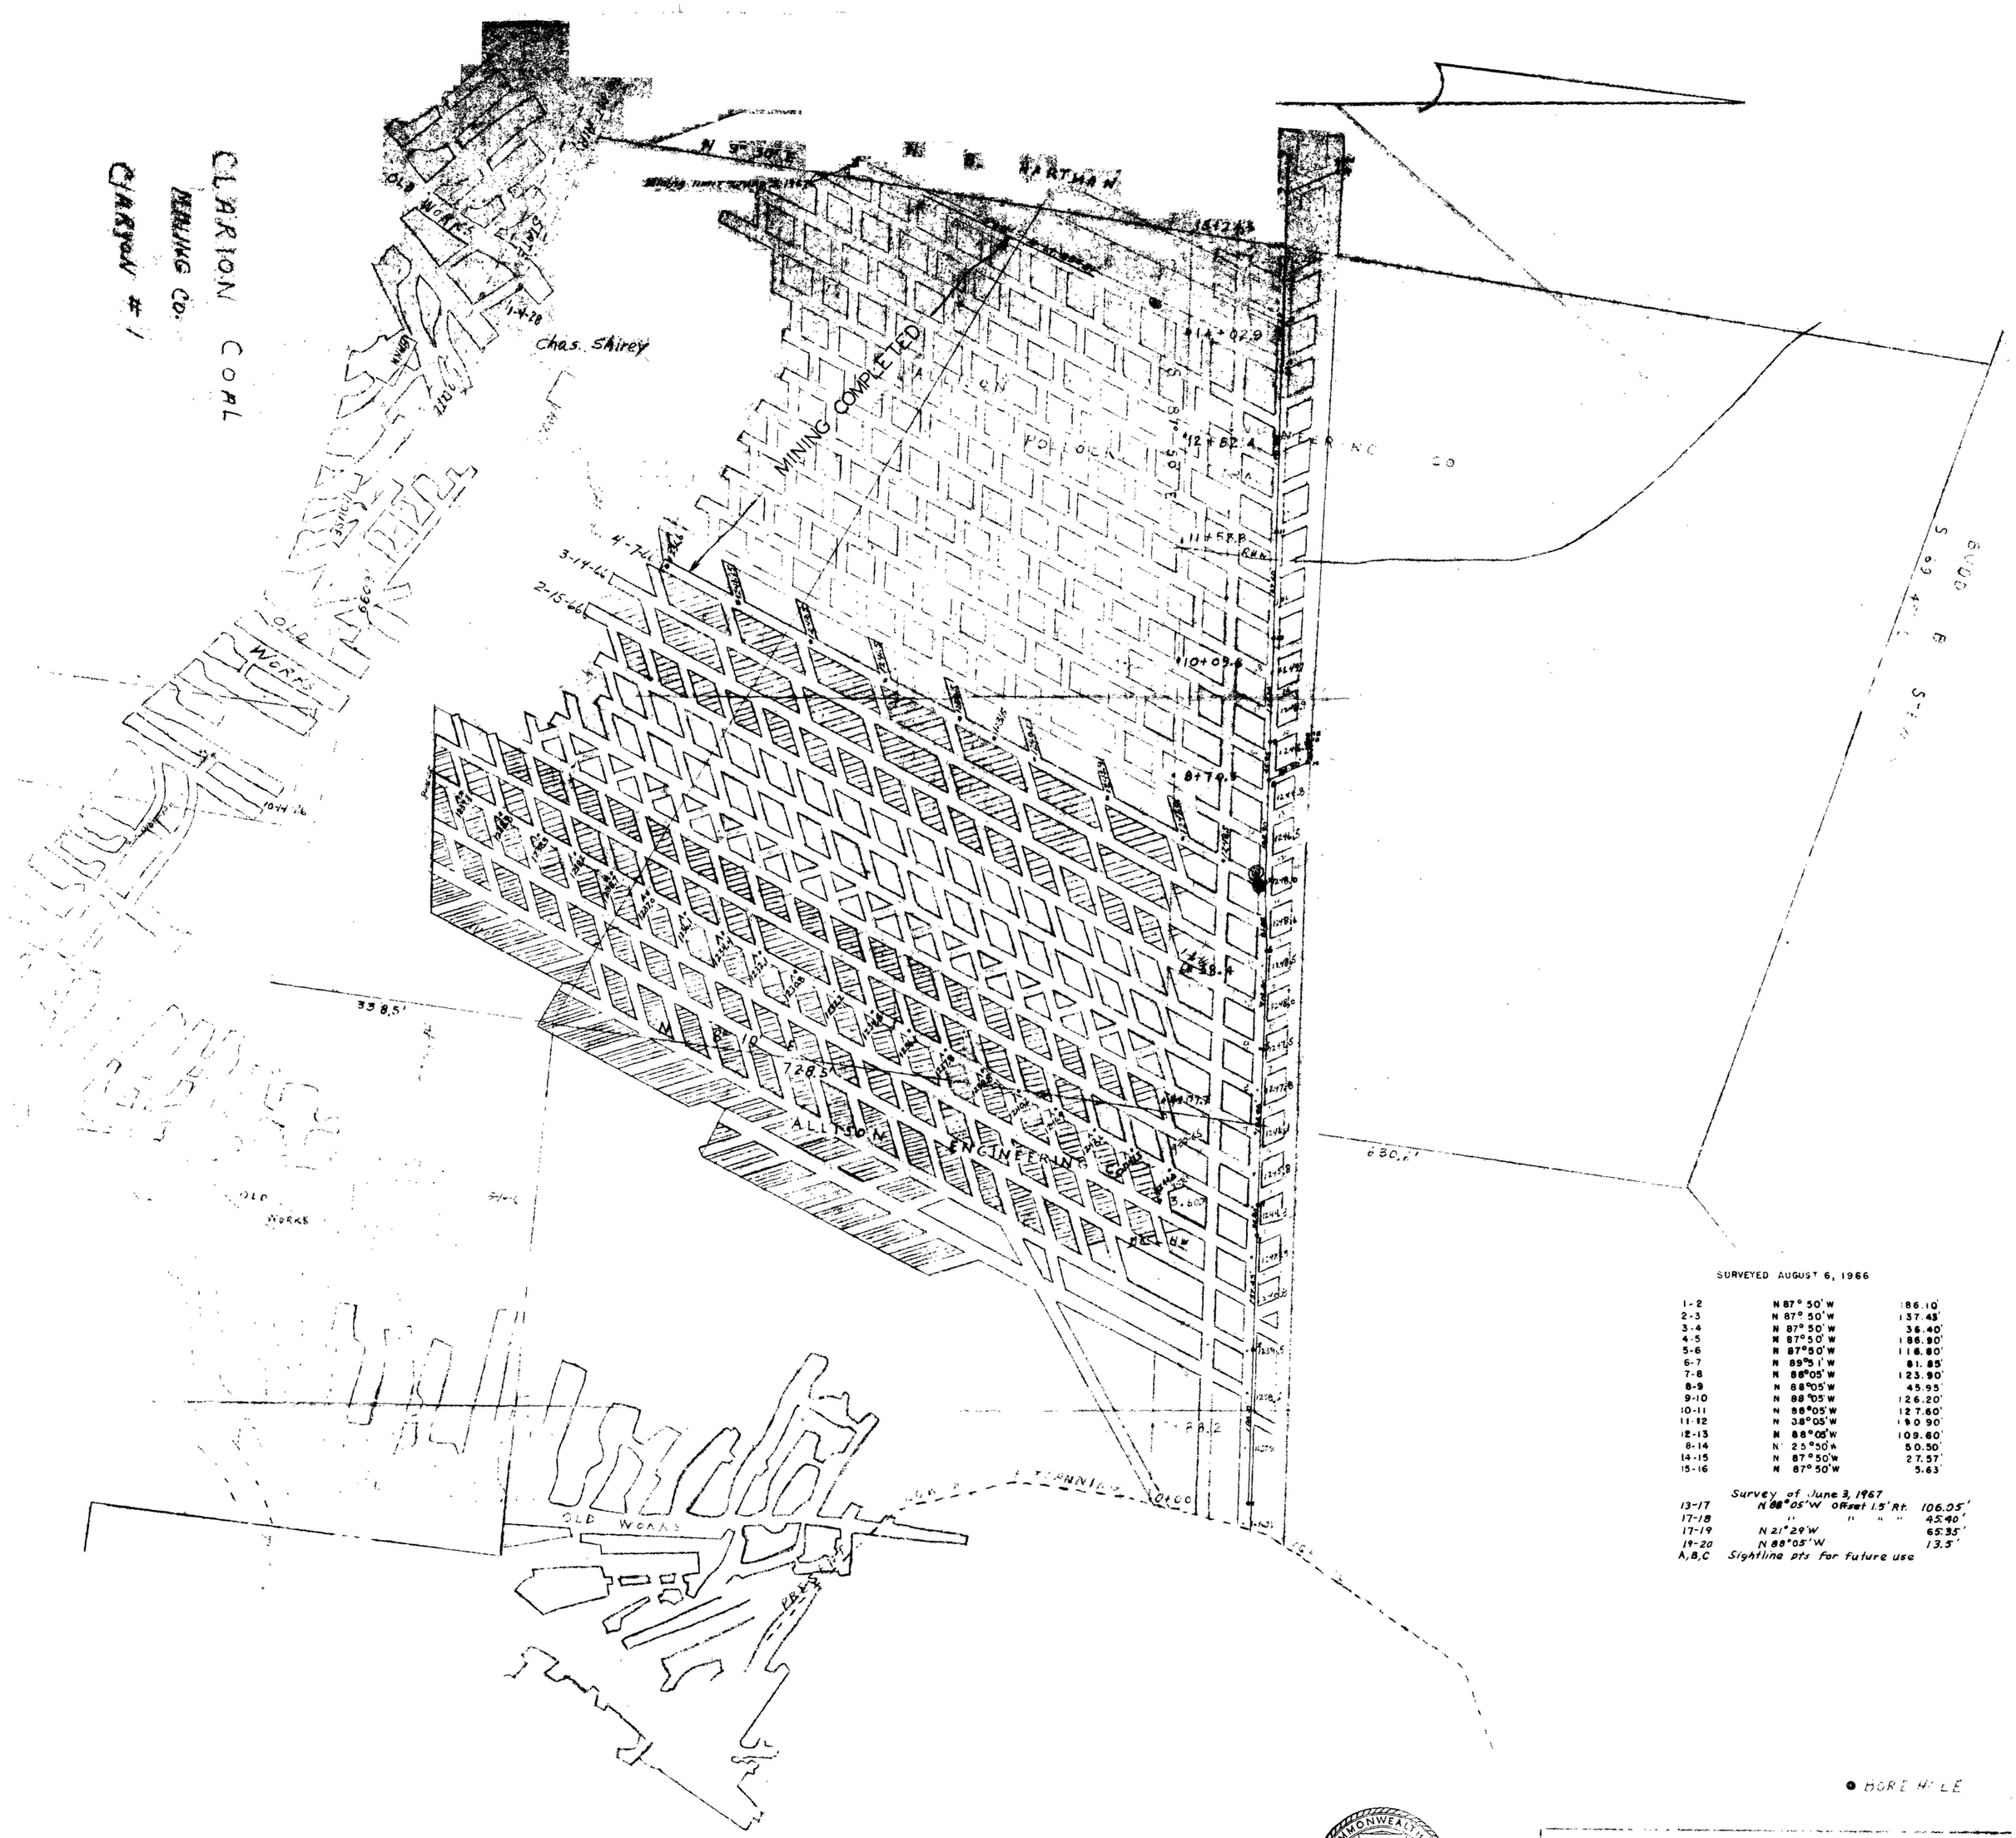

SURVEYED AUGUST 6, 1966

1-2	N 87° 50' W	186.10'
2-3	N 87° 50' W	137.48'
3-4	N 87° 50' W	36.40'
4-5	N 87° 50' W	186.80'
5-6	N 87° 50' W	116.80'
6-7	N 89° 51' W	81.85'
7-8	N 88° 05' W	123.90'
8-9	N 88° 05' W	45.95'
9-10	N 88° 05' W	126.20'
10-11	N 88° 05' W	127.60'
11-12	N 88° 05' W	190.90'
12-13	N 88° 05' W	109.60'
8-14	N 25° 50' W	50.50'
14-15	N 87° 50' W	27.57'
15-16	N 87° 50' W	5.63'

Survey of June 3, 1967

13-17	N 88° 05' W Offset 1.5' Rt.	106.05'
17-18	" " " "	45.40'
17-19	N 21° 29' W	65.35'
19-20	N 88° 05' W	13.5'
A,B,C	Sightline pts for future use	

COMMONWEALTH OF PENNSYLVANIA
REGISTERED PROFESSIONAL
HAROLD FRANK SCOTT
ENGINEER
No. 11559-E

Field Survey June 3, 1967
Harold Frank Scott

ALLISON ENGINEERING COMPANY
DEEP MINE # 17
TOBY TWP. CLARION CO. PENNA

NOV. - 1964
SCALE 1" = 100'