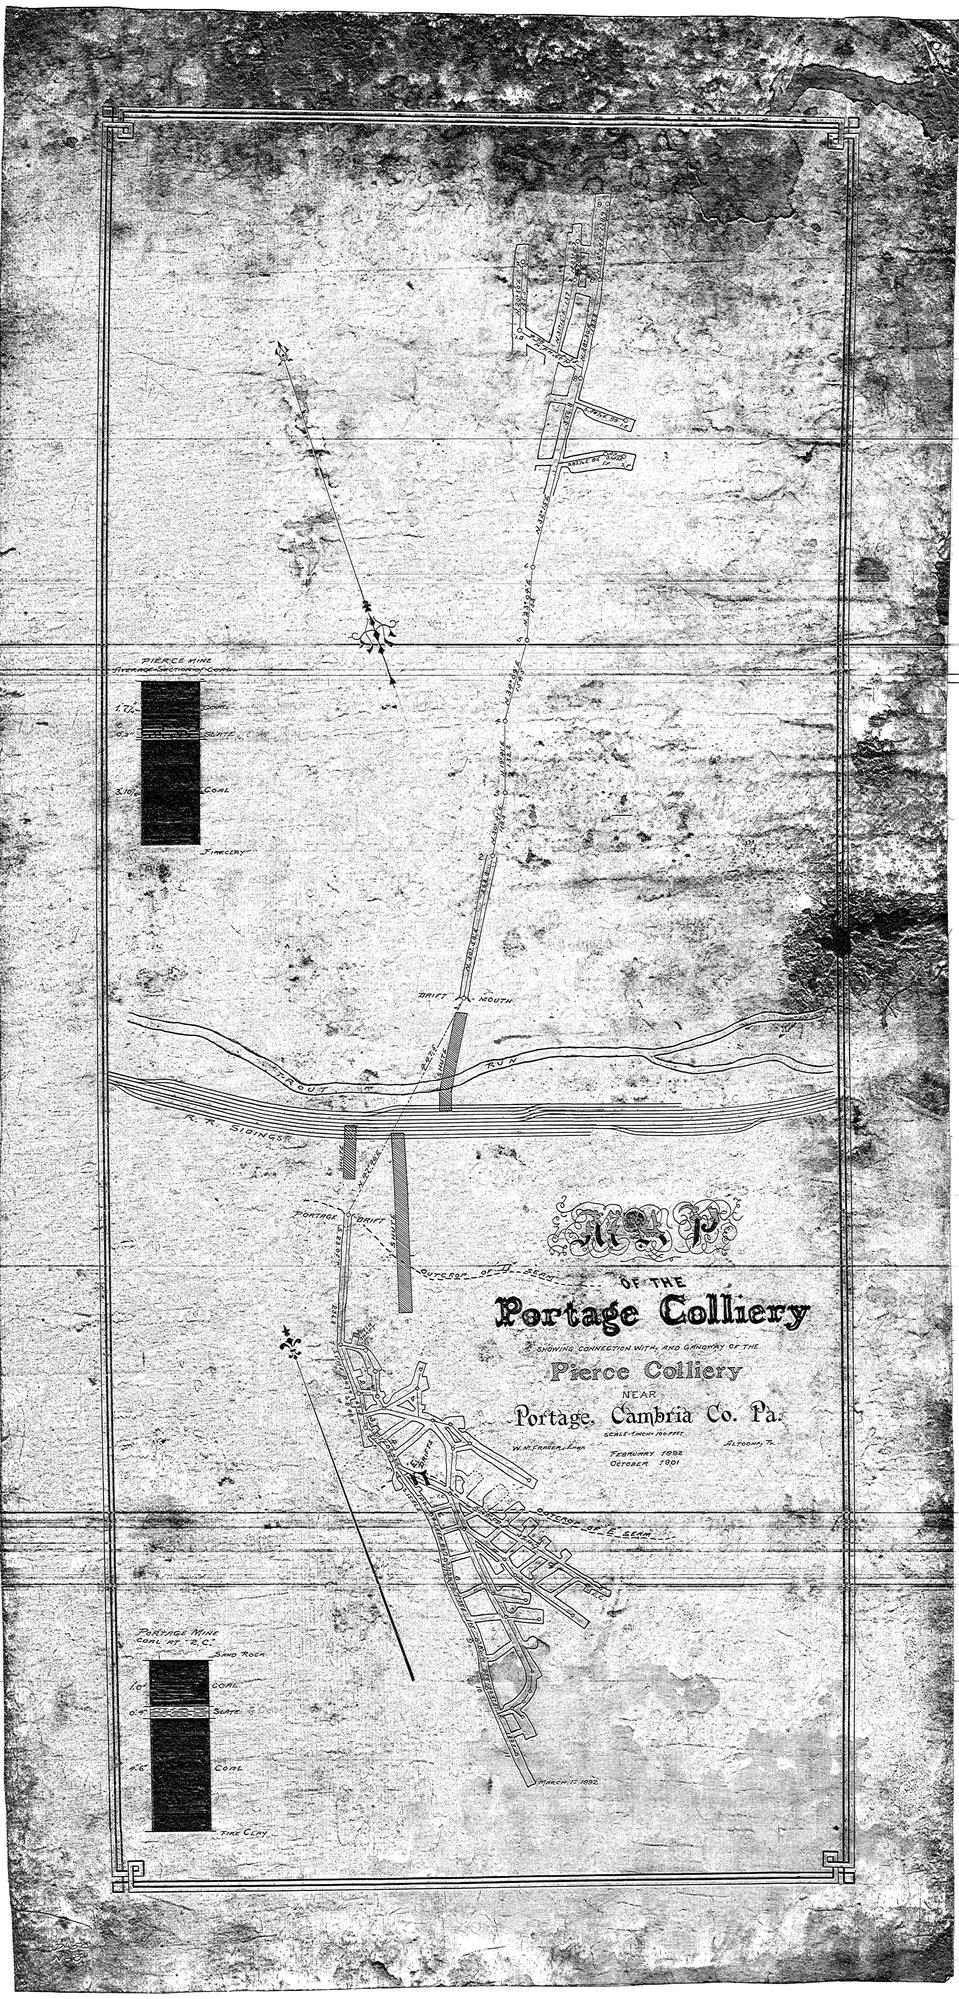

PIERCE MINE
Average Section of Coals
Coal
Slate
Coal
Fireclay
DRIFT MOUTH
OUTCROP OF COAL SEAM
PORTAGE DRIFT
OF THE
Portage Colliery
SHOWING CONNECTION WITH, AND GANGWAY OF THE
Pierce Colliery
NEAR
Portage, Cambria Co. Pa.
SCALE-1 INCH=100 FEET.
ALTOONA, PA.
FEBRUARY 1892
OCTOBER 1901
PORTAGE MINE
Coal at P. C.
Sand Rock
Coal
Slate
Coal
Fire Clay