EPHRAIM REIGHARD
CAMBRIA IRON COMPANY
MINE WORKINGS BY SAMUEL STYER LESSEE
CAMBRIA IRON COMPANY
PILLARS DRAWN "A"
LITTLE CONEMAUGH RIVER
Reserved
Reserved
Reserved for Spring
PILLARS DRAWN
PILLARS DRAWN
CAMBRIA IRON COMPANY
CAMBRIA IRON COMPANY
OLD PORTAGE RAILROAD
CONEMAUGH
LITTLE
PLANE
TIPPLE
Engine Room
Hemlock Stump
Stones
Sugar
Outcrop
A
B
C
D
E
F
G
H
J
K
L
M
N
O
P
R
S
T

MINERAL POINT COAL CO.

map of

VALLEY MINE NO. 3

near

MINERAL POINT

Cambria County Penna

Scale 1" = 100' — C.P. Collins C.E. — Johnstown, Pa., Mar. 31, 1908.

Situate in
Conemaugh Township

Note – Coal taken out by J.B. Kennerly, shown thus

Lands in Fee shown thus

" All Coal "

Note:– The mine workings extending to the index letter "A" together with all land lines have been traced from information furnished by the company.

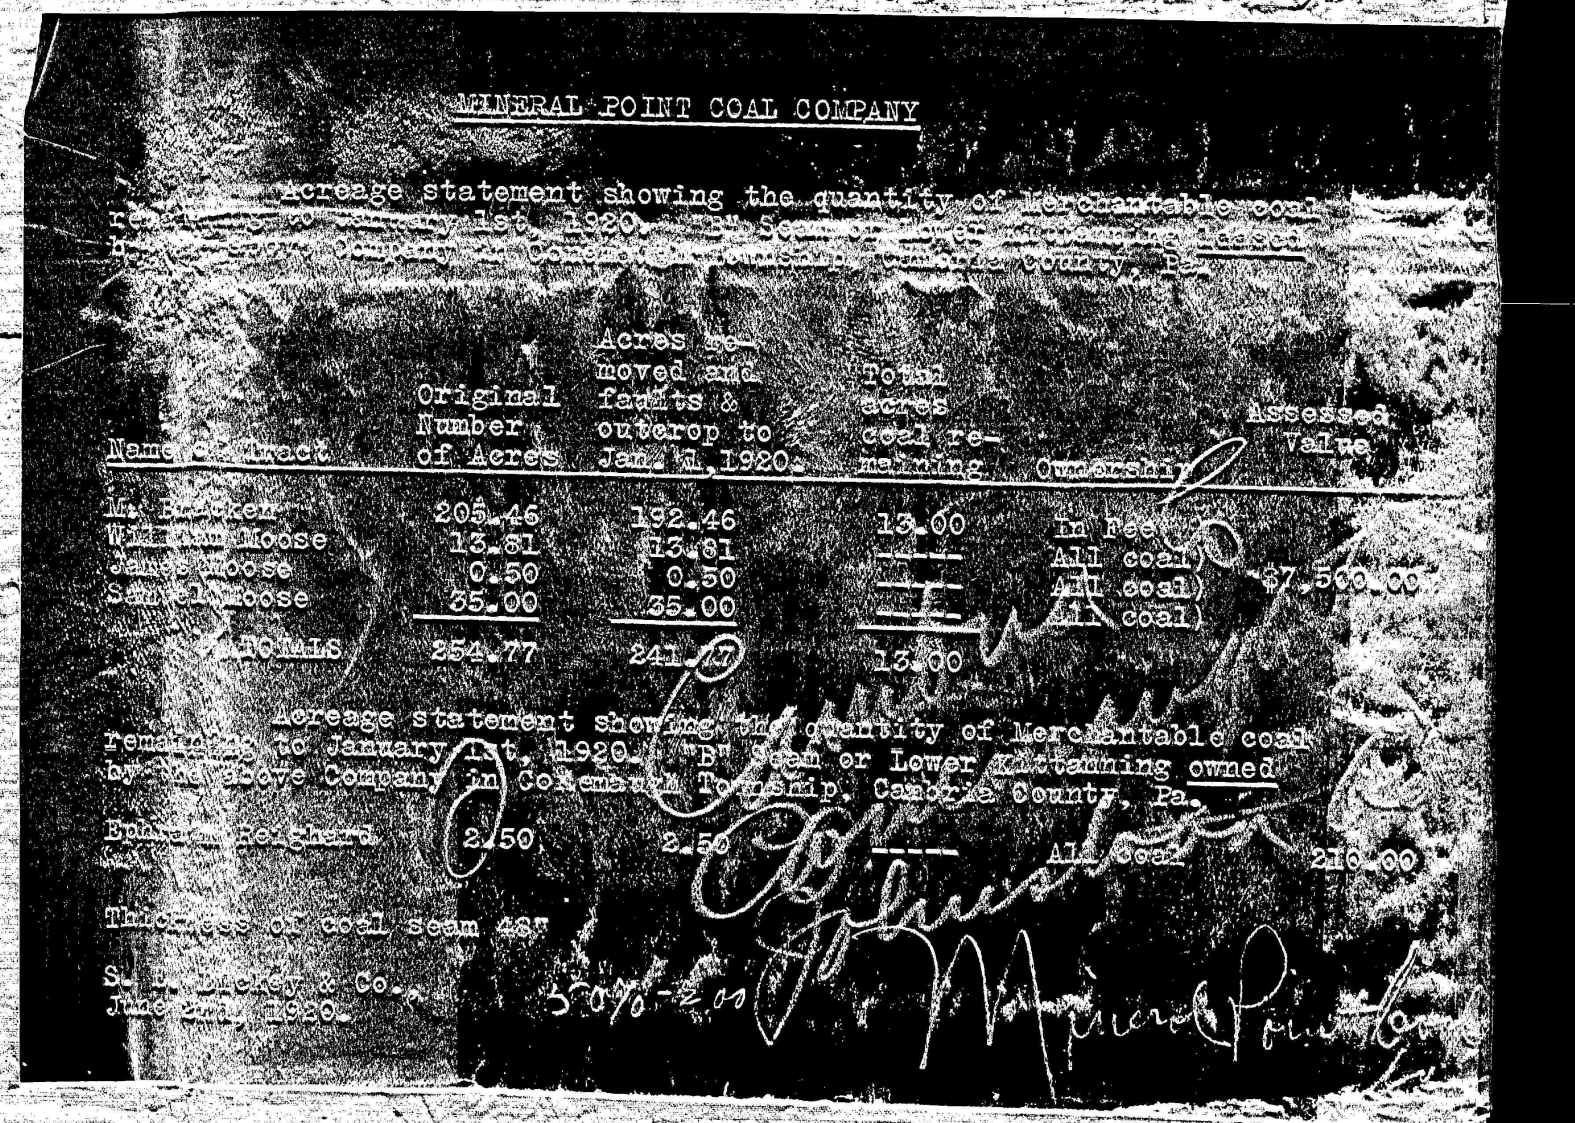

MINERAL POINT COAL COMPANY

Acreage statement showing the quantity of Merchantable coal remaining to January 1st, 1920. "B" Seam or Lower Kittanning leased by the above Company in Conemaugh Township, Cambria County, Pa.

Name of Tract	Original Number of Acres	Acres removed and faults & outcrop to Jan. 1, 1920.	Total acres coal remaining	Ownership	Assessed Value
M. [illegible]	205.46	192.46	13.00	In Fee	
William Moose	13.81	13.81	----	All coal	$7,500.00
James Moose	0.50	0.50	----	All coal	
Samuel Moose	35.00	35.00	----	All coal	
TOTALS	254.77	241.77	13.00		

Acreage statement showing the quantity of Merchantable coal remaining to January 1st, 1920. "B" Seam or Lower Kittanning owned by the above Company in Conemaugh Township, Cambria County, Pa.

Ephraim Reighard	2.50	2.50	----	All coal	210.00

Thickness of coal seam 48"

S. E. Dickey & Co.
June 2[illegible], 1920.

50% - 200

Mineral Point [illegible]

INDEX TO SURVEYS

LETTER	DATE OF SURVEY	SURVEYED BY	PLOTTED BY	REMARKS
A		J.L. Elder		
B	Mar. 27. 1908	S.E. Dickey	S.E. Dickey	
C	Dec. 6. 1908	" "	C.P.C.	Stoppings =
D	May 18 1909	" "	S.E.D.	Doors D
E	Dec. 2 1909			Air →
F	Aug. 22 1910	" "		
G	April 28 1911	" "	" "	
H	Oct. 3 1911	" "	" "	
J	Jan. 23 1913	" "	" "	
K	Sept. 24 1913	H. G. D.	H. G. D.	
L	April 14 1914	" " "	" "	
M	Nov. 9 1914	" " "	" "	
N	July 19 1915	" " "	" "	
O	Jan. 10 1916	E.M. Bass	E.M. Bass	
P	Dec. 6 1916	T.E. West	T.E. West	
R	June 23 1917	Geo. Merk	T.E. West	
S	Feb. 9 1918	S.S. Seese	T.E. West	
T	Jan. 13 1919	L.L. Bartlett	L.L. Bartlett	

3 B 3 ? 7 1