


CairnBrook #9

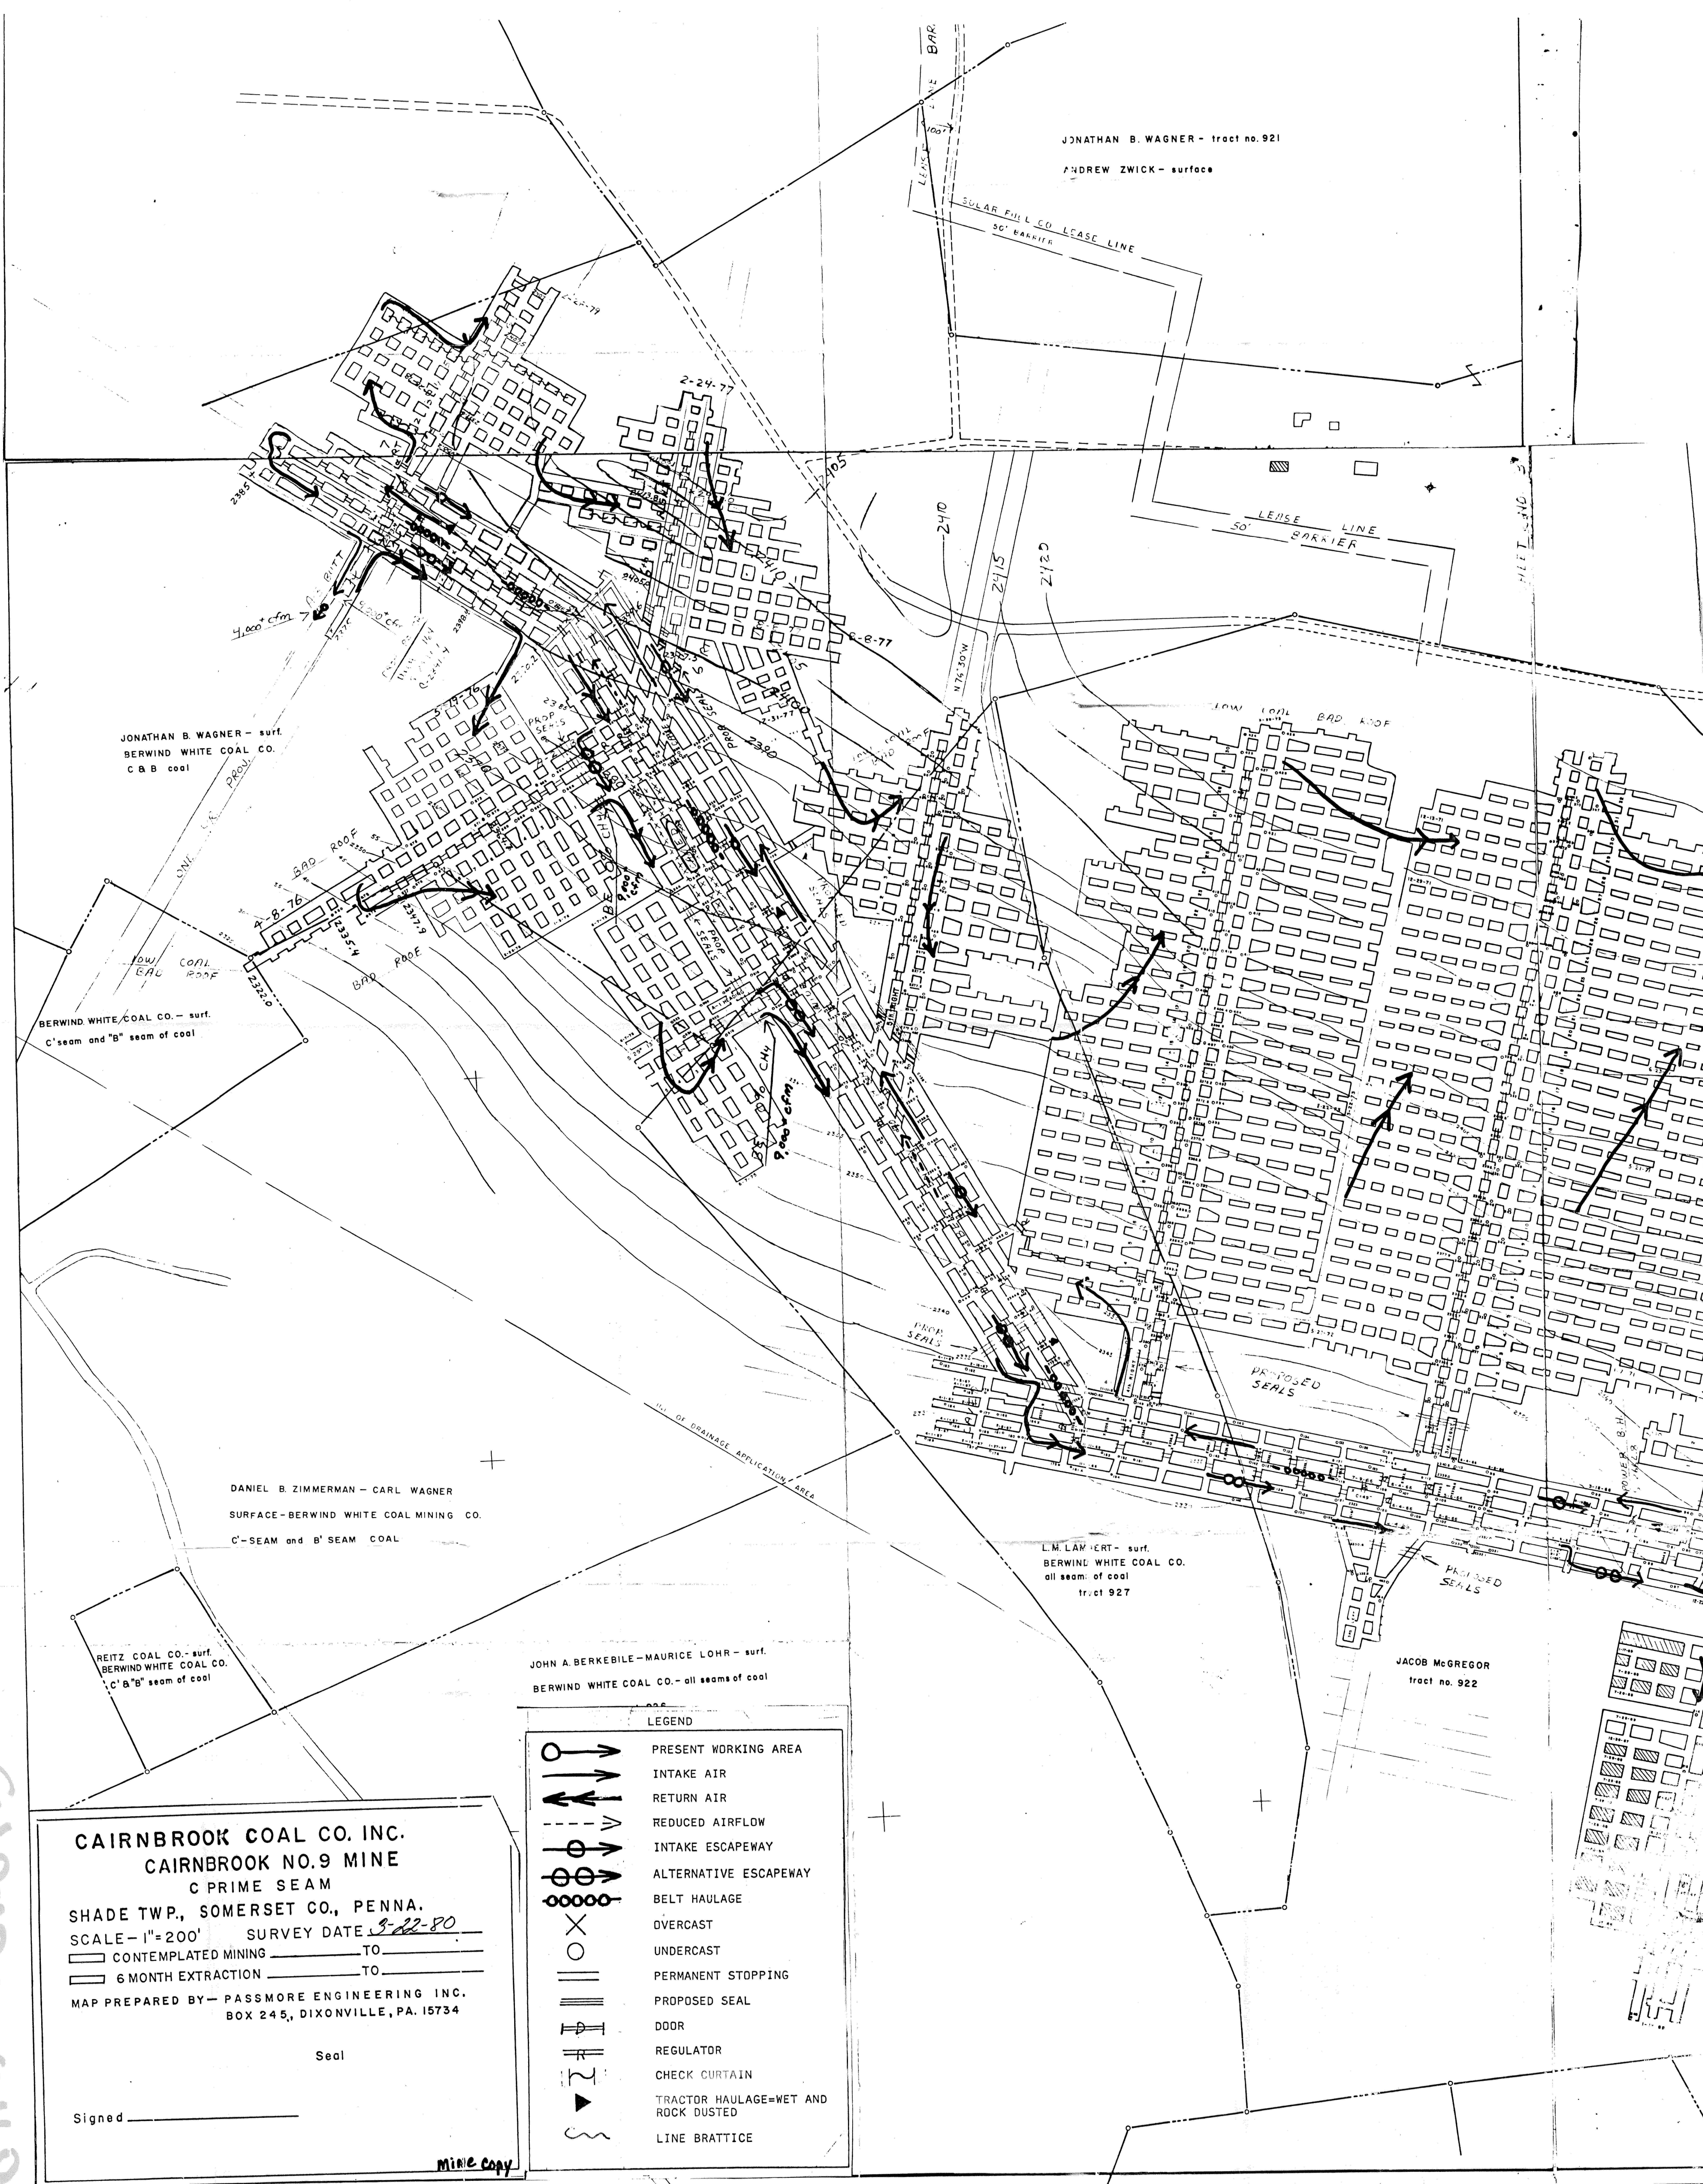

CAIRNBROOK COAL CO. INC.
CAIRNBROOK NO. 9 MINE
C PRIME SEAM
SHADE TWP., SOMERSET CO., PENNA.
SCALE - 1" = 200' SURVEY DATE 3-22-80
CONTEMPLATED MINING TO
6 MONTH EXTRACTION TO
MAP PREPARED BY - PASSMORE ENGINEERING INC.
BOX 245, DIXONVILLE, PA. 15734

LEGEND	
	PRESENT WORKING AREA
	INTAKE AIR
	RETURN AIR
	REDUCED AIRFLOW
	INTAKE ESCAPEWAY
	ALTERNATIVE ESCAPEWAY
	BELT HAULAGE
	OVERCAST
	UNDERCAST
	PERMANENT STOPPING
	PROPOSED SEAL
	DOOR
	REGULATOR
	CHECK CURTAIN
	TRACTOR HAULAGE=WET AND ROCK DUSTED
	LINE BRATTICE

Signed _____

Miner Copy

MATCH TO SHEET 2