


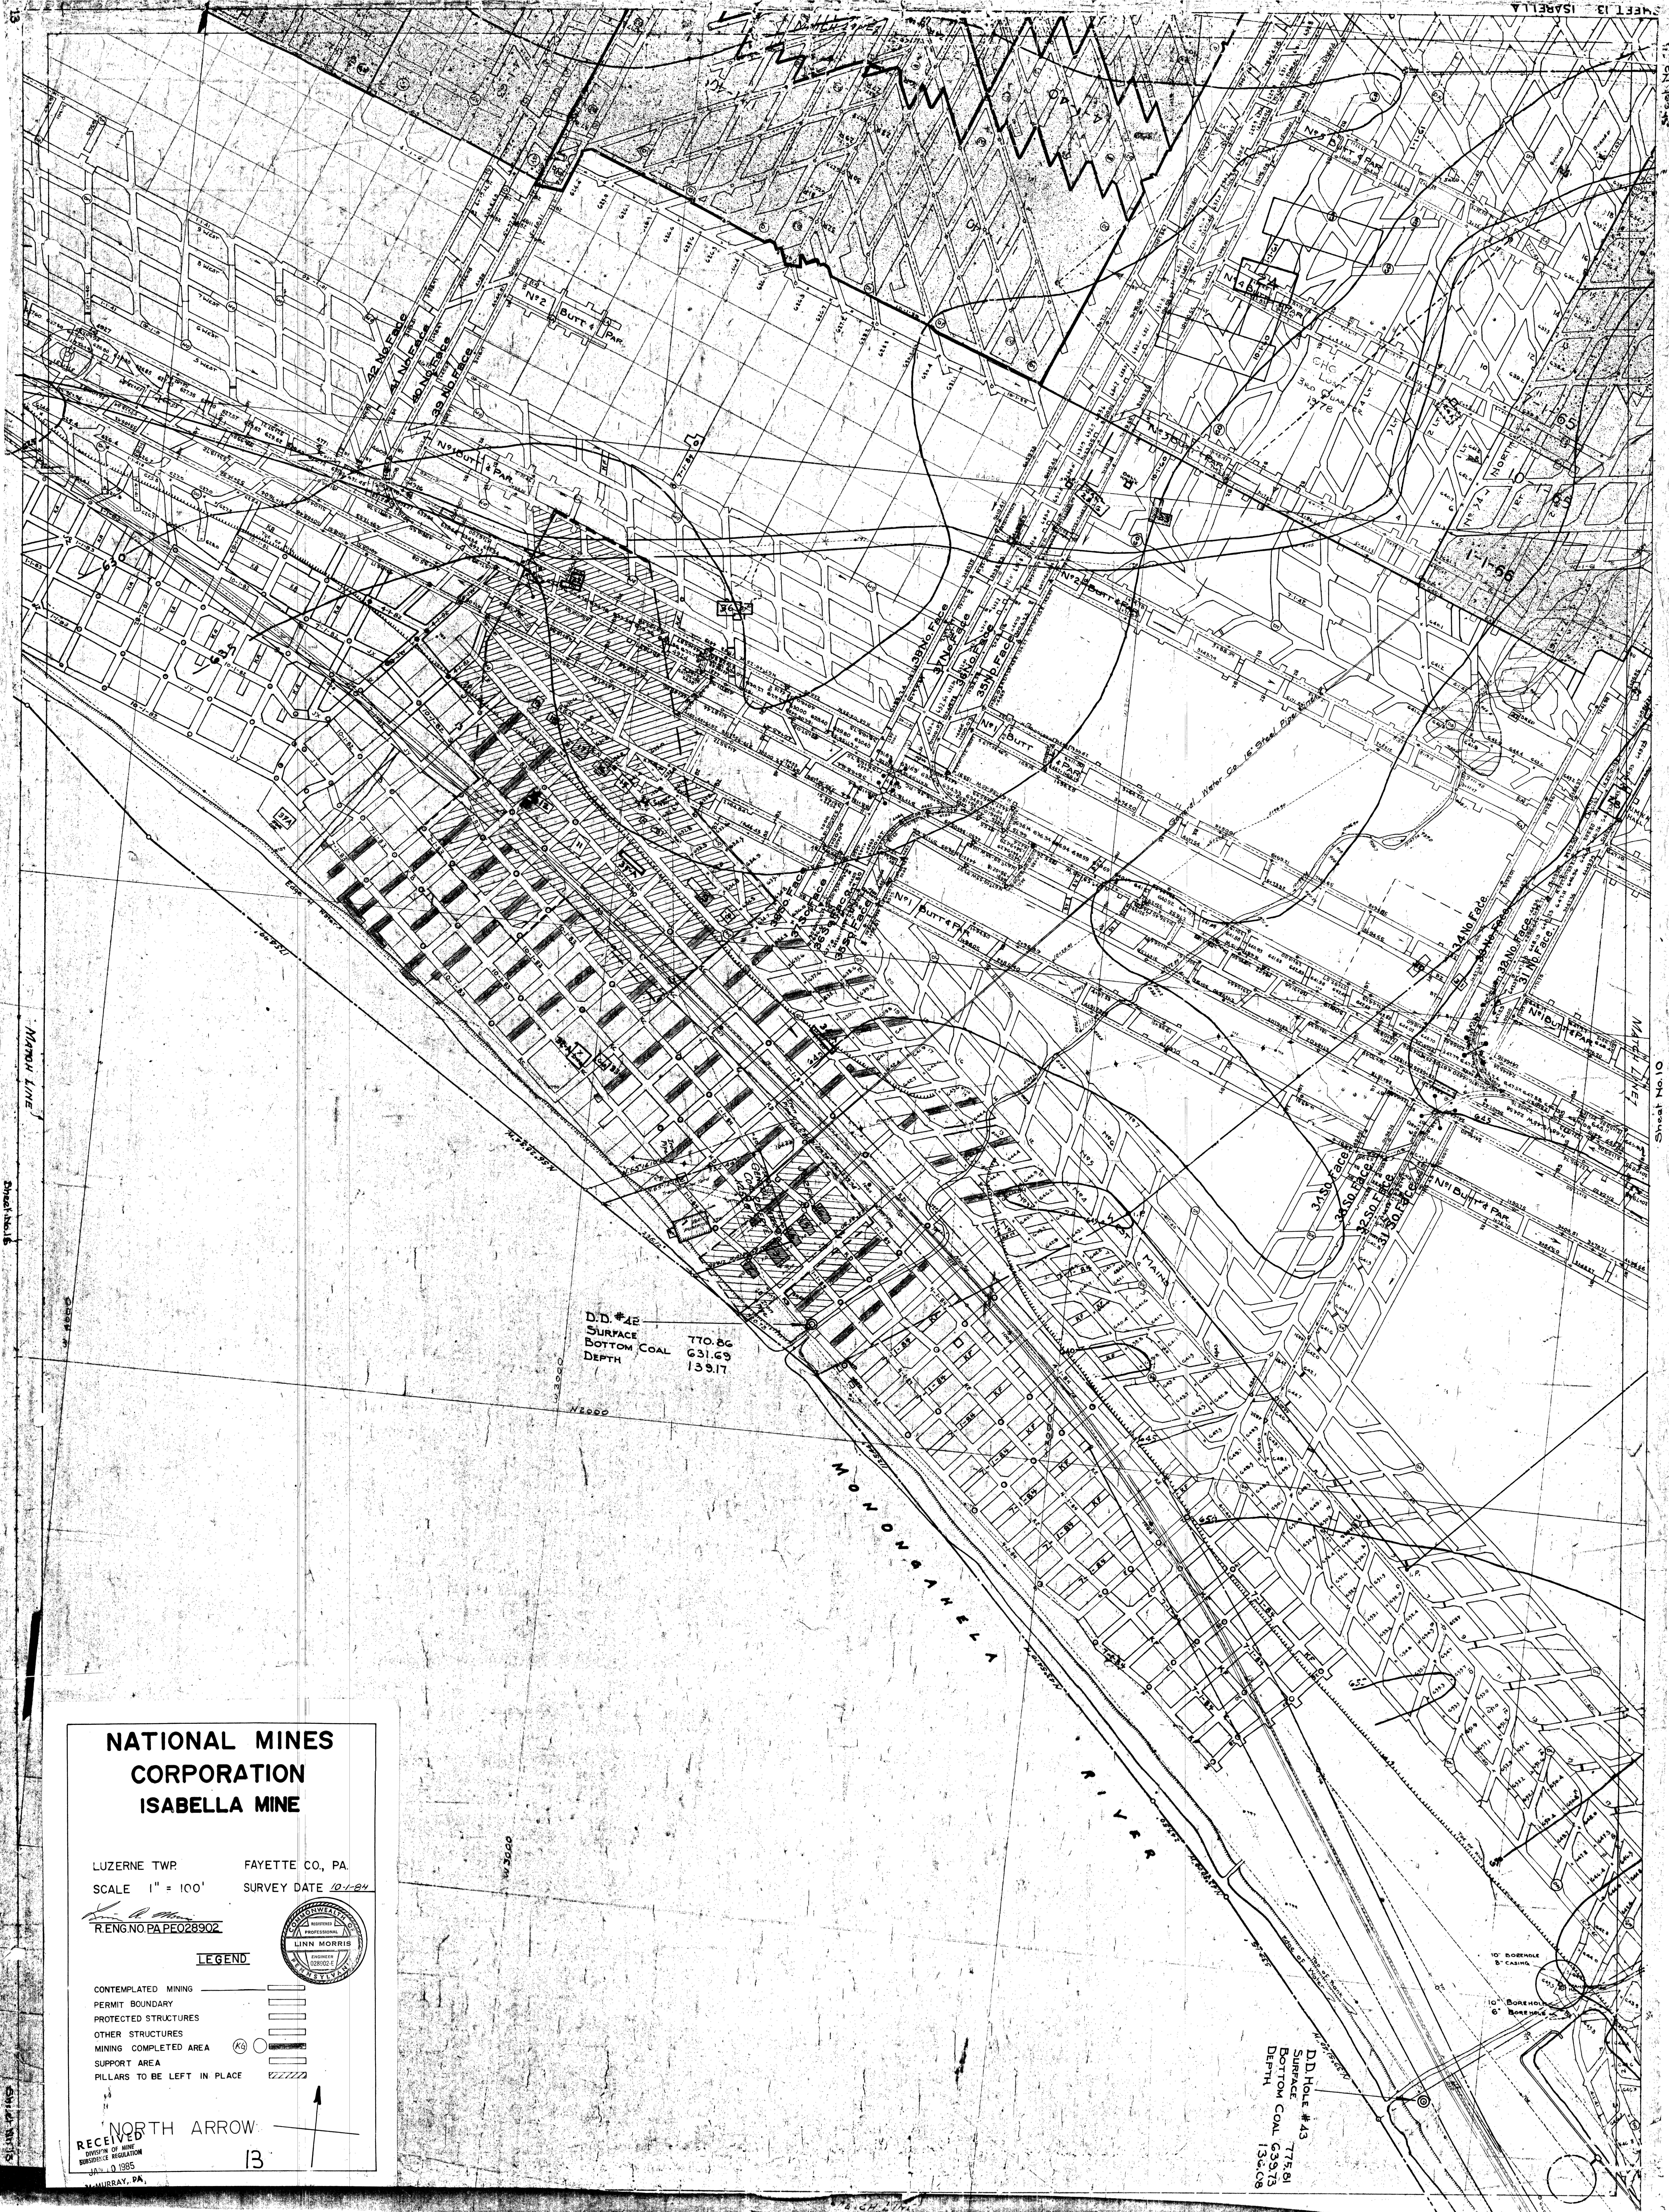

D.D. #42
SURFACE 770.86
BOTTOM COAL 631.65
DEPTH 139.17

D.D. #43
SURFACE 775.81

NATIONAL MINES CORPORATION
ISABELLA MINE

LUZERNE TWP. FAYETTE CO., PA.


RECEIVED
DIVISION OF MINE
SUBSIDIARY REGULATION
MURRAY, PA.

LEGEND

CONTEMPLATED MINING

PERMIT BOUNDARY

PROTECTED STRUCTURES

OTHER STRUCTURES

MINING COMPLETED AREA

SUPPORT AREA

PILLARS TO BE LEFT IN PLACE

13