


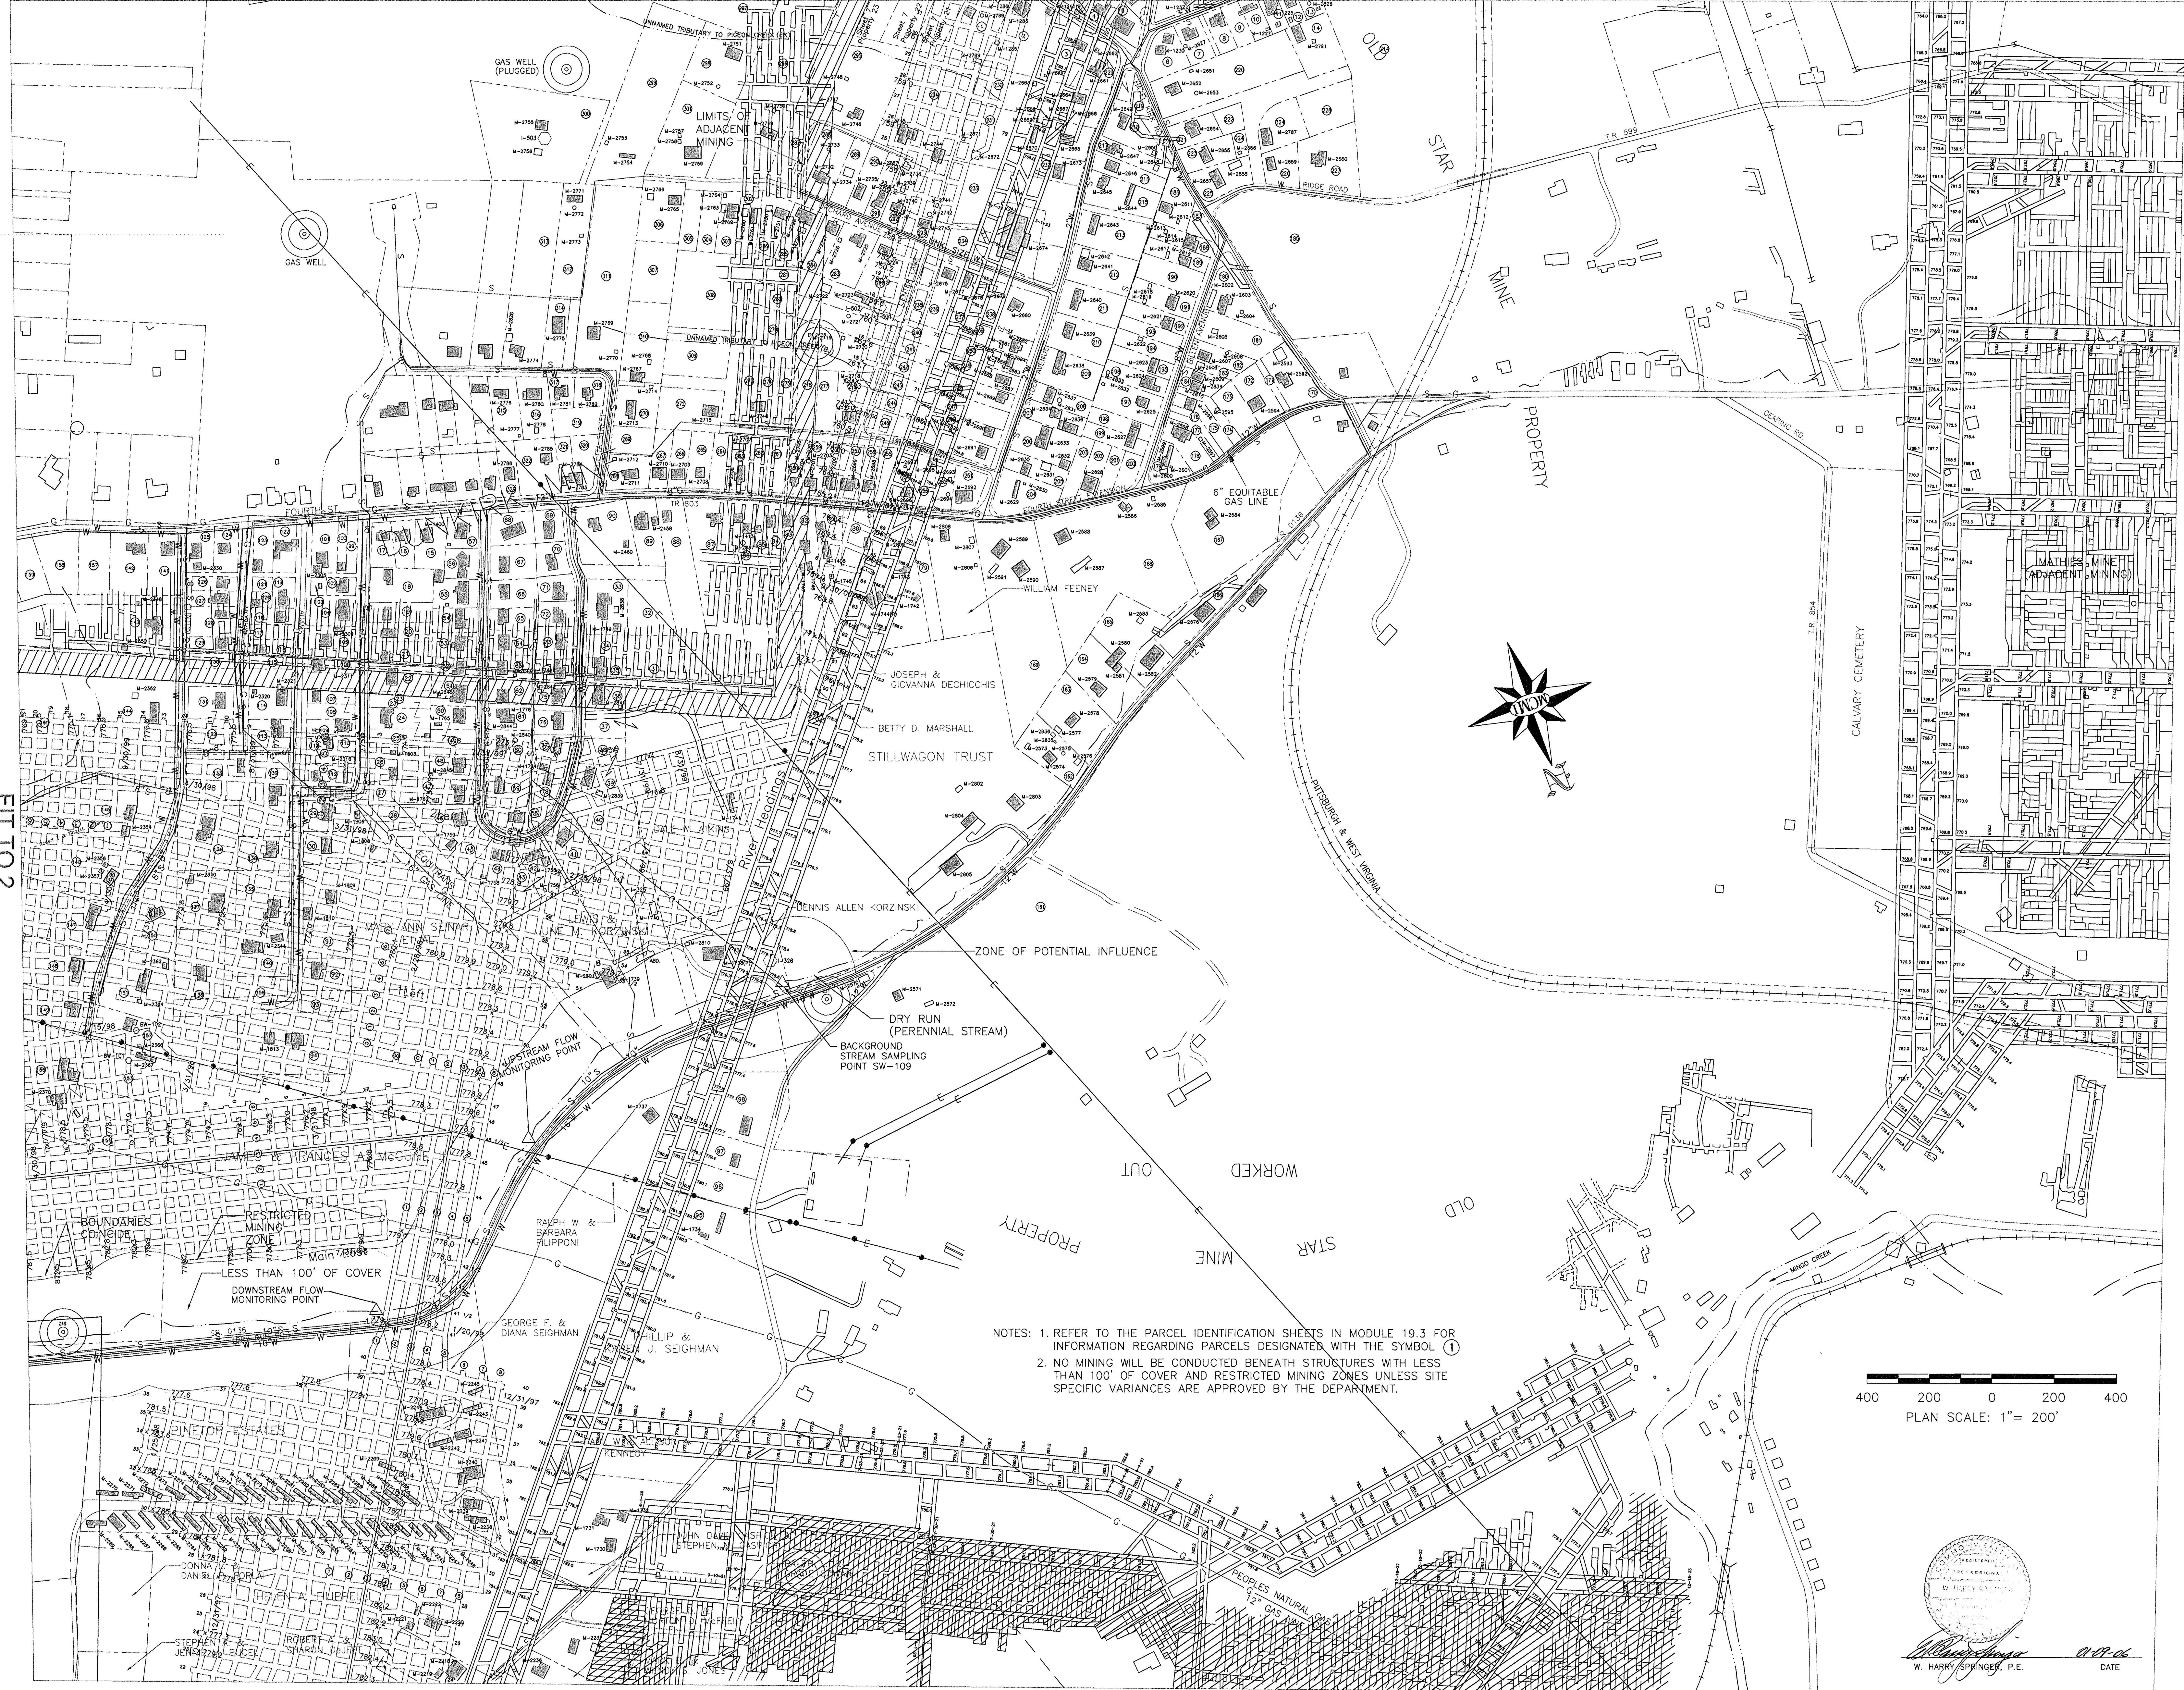

NOTES: 1. REFER TO THE PARCEL IDENTIFICATION SHEETS IN MODULE 19.3 FOR INFORMATION REGARDING PARCELS DESIGNATED WITH THE SYMBOL ①
2. NO MINING WILL BE CONDUCTED BENEATH STRUCTURES WITH LESS THAN 100' OF COVER AND RESTRICTED MINING ZONES UNLESS SITE SPECIFIC VARIANCES ARE APPROVED BY THE DEPARTMENT.

400 200 0 200 400
PLAN SCALE: 1" = 200'

