FINAL MAP MC-07

FIT TO 8

FIT TO 3

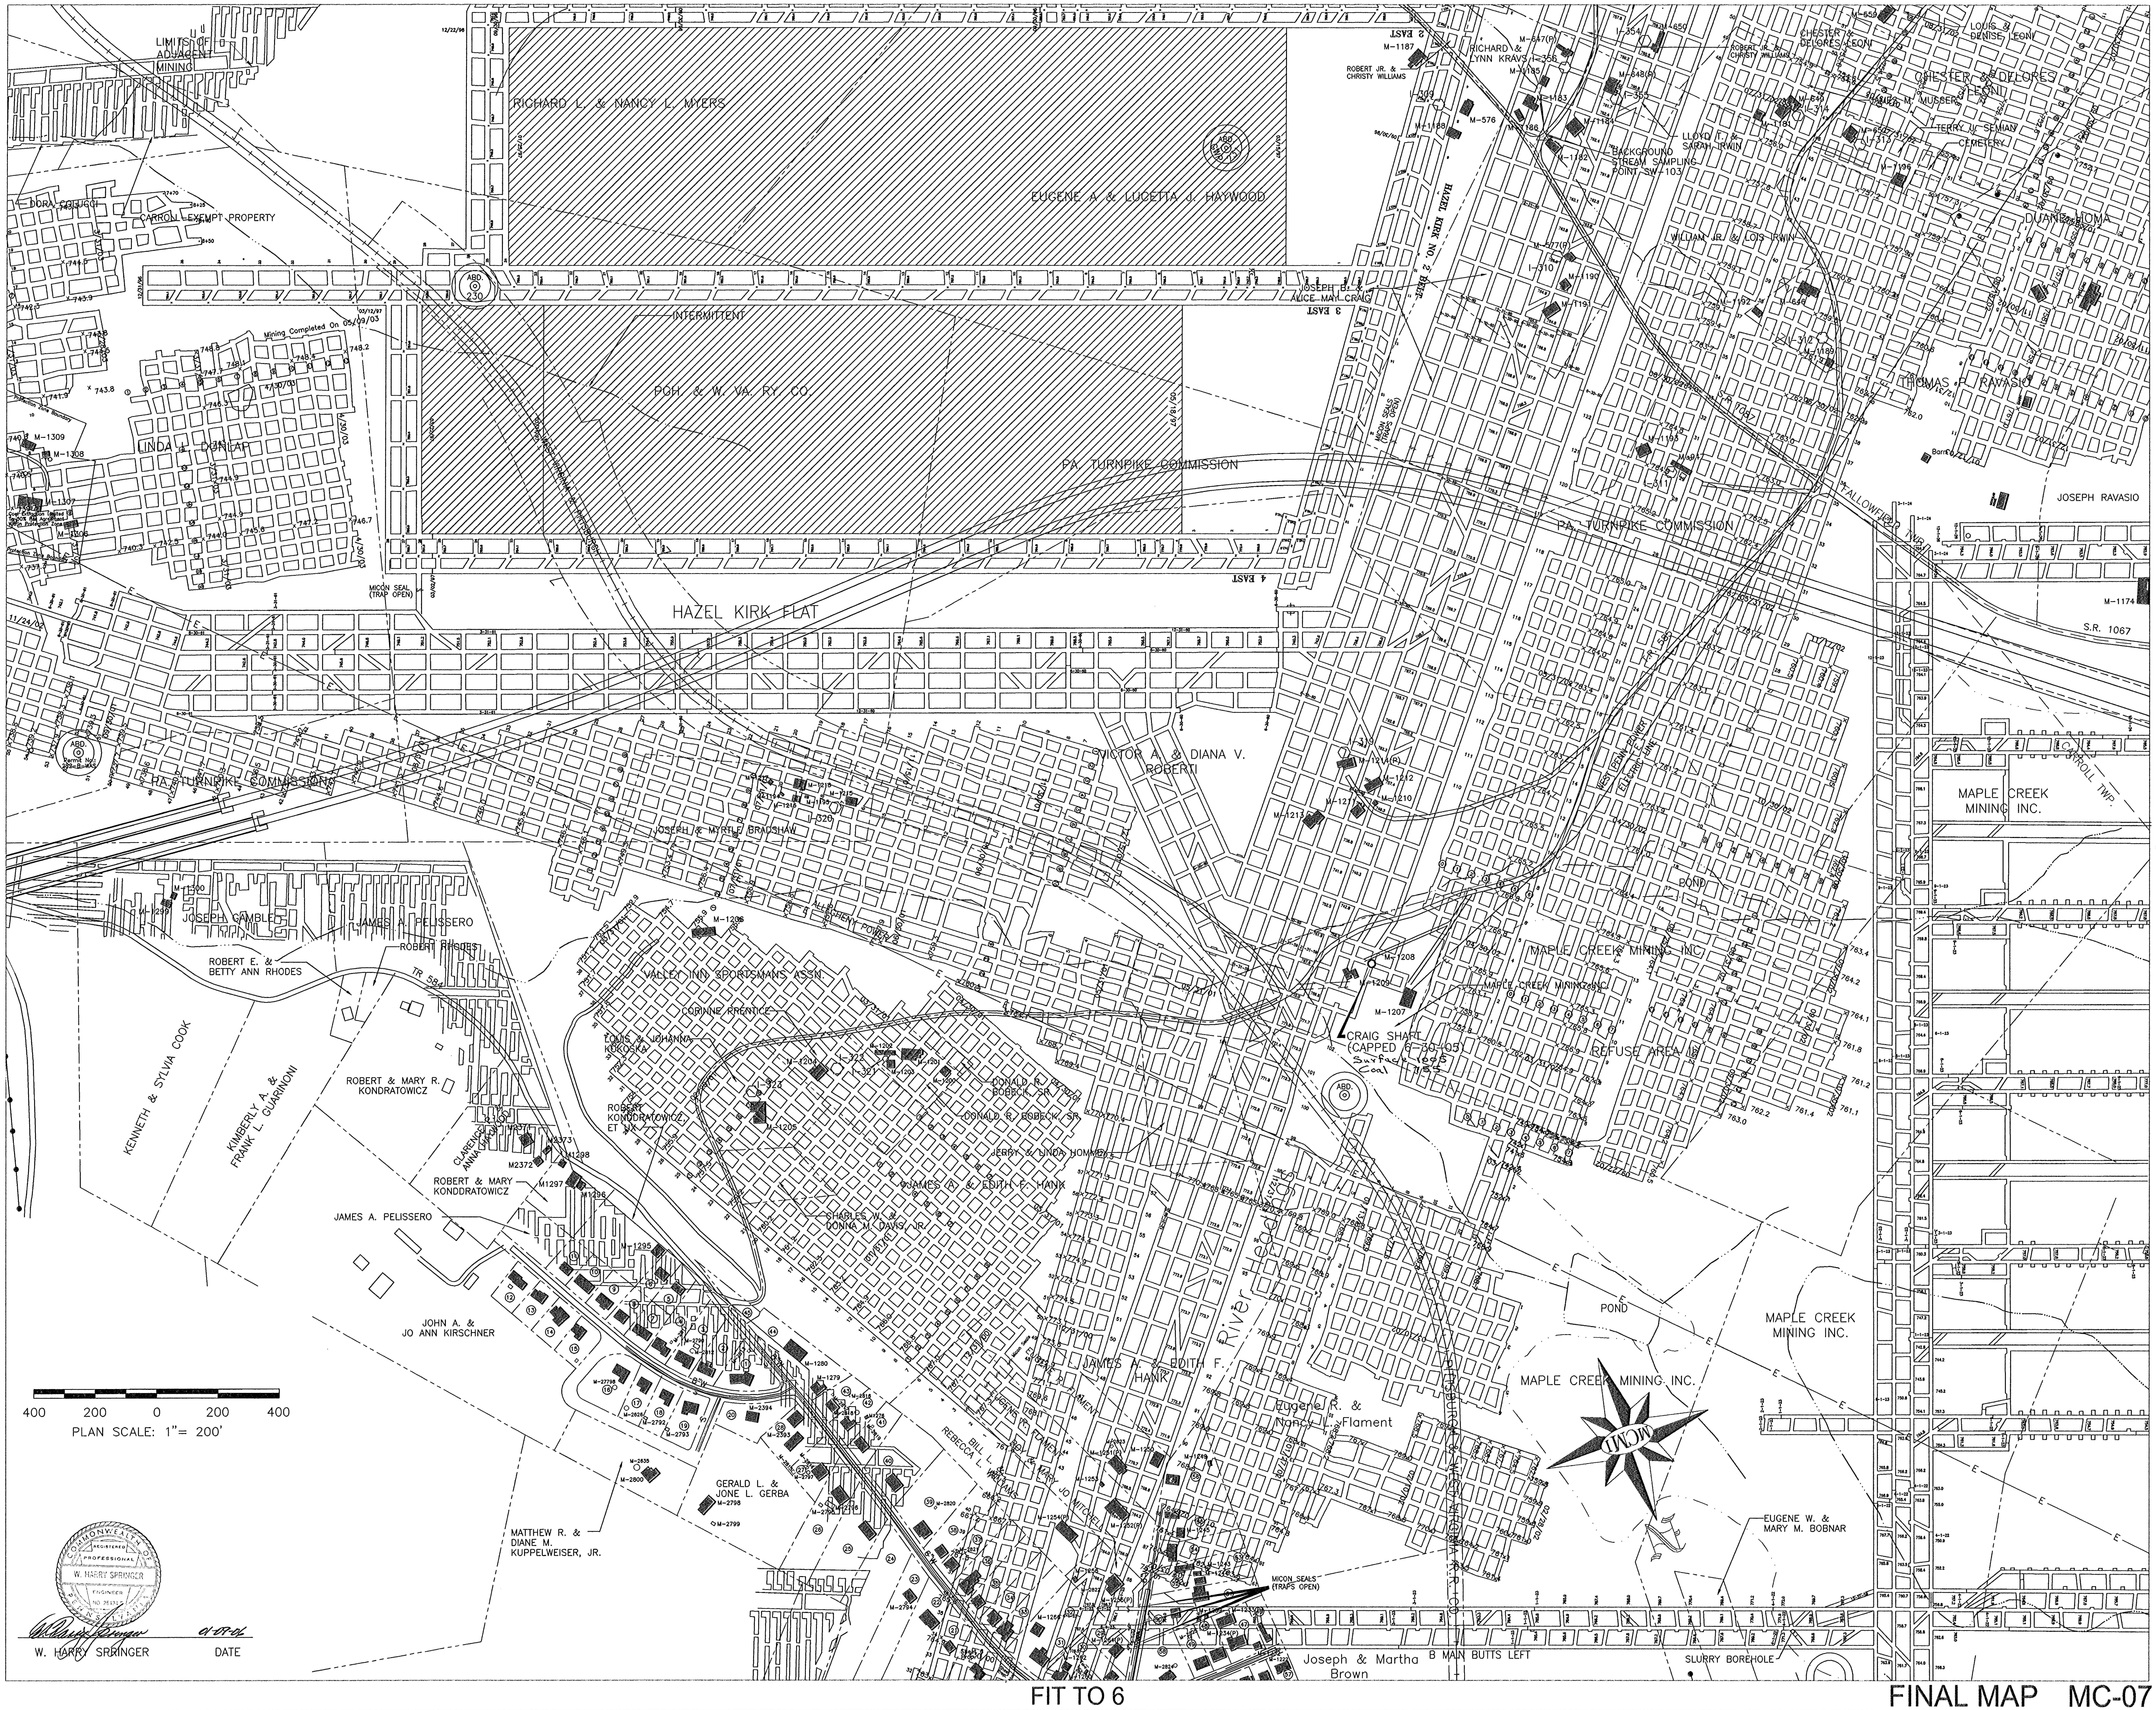
LIMITS OF ADJACENT MINING
DORA COLUCCI
CARRON - EXEMPT PROPERTY
Mining Completed On 05/09/03
LINDA L. DUNLAP
M-1309
M-1308
M-1307
M-1306
Coal Extraction Limited To 50% Per Agreement Within Protection Zone
Protection Zone Boundary
MICON SEAL (TRAP OPEN)
ABD. 230
ABD. Permit No. 282-B-WAS
RICHARD L. & NANCY L. MYERS
EUGENE A & LUCETTA J. HAYWOOD
INTERMITTENT
PGH & W. VA. RY. CO.
PA. TURNPIKE COMMISSION
HAZEL KIRK FLAT
2 EAST
3 EAST
4 EAST
JOSEPH B. & ALICE MAY CRAIG
ROBERT JR. & CHRISTY WILLIAMS
M-1187
HAZEL KIRK NO. 2 BELT
MICON SEALS (TRAPS OPEN)
RICHARD & LYNN KRAVS
M-647(P)
I-356
I-354
M-650
M-1185
M-1183
M-648(P)
I-355
M-1184
M-1186
M-1188
M-576
I-309
M-1182
LLOYD T. & SARAH IRWIN
BACKGROUND STREAM SAMPLING POINT SW-103
CHESTER & DELORES LEONI
LOUIS & DENISE LEONI
M-659
M-649
I-314
M-1181
JAMES M. MUSSER
M-650
I-313
TERRY J. SEMIAN
CEMETERY
M-1196
DUANE HOMA
WILLIAM JR. & LOIS IRWIN
M-577(P)
I-310
M-1190
M-1191
M-1192
M-646
I-312
M-1189
THOMAS P. RAVASIO
Barn
S.R. 1087
M-1193
M-1194
I-311
FALLOWFIELD TWP.
JOSEPH RAVASIO
M-1174
S.R. 1067
CARROLL TWP.
MAPLE CREEK MINING INC.
WEST PENN POWER ELECTRIC LINE
POND
REFUSE AREA
VICTOR A. & DIANA V. ROBERTI
I-319
M-1214(P)
M-1212
M-1210
M-1211
M-1213
JOSEPH & MYRTLE BRADSHAW
M-1217
M-1218
M-1215
M-1216
M-1195
I-320
ALLEGHENY POWER
M-1206
M-1208
M-1209
M-1207
CRAIG SHAFT (CAPPED 6-30-05)
Surface 1095
Coal 755
ABD.
VALLEY INN SPORTSMANS ASSN.
CORINNE PRENTICE
LOUIS & JOHANNA KOKOSKA
M-1204
I-322
I-321
M-1202
M-1203
M-1201
M-1200
I-323
M-1205
DONALD R. BOBECK, SR.
JERRY & LINDA HOMMEL
JAMES A. & EDITH F. HANK
CHARLES W. & DONNA M. DAVIS, JR.
ROBERT KONDDRATOWICZ, ET UX
JOSEPH GAMBLE
M-1300
M-1299
JAMES A. PELISSERO
ROBERT RHODES
ROBERT E. & BETTY ANN RHODES
TR 584
KENNETH & SYLVIA COOK
KIMBERLY A. & FRANK L. GUARINONI
ROBERT & MARY R. KONDRATOWICZ
CLARENCE & ANNA HAWOOD
M2371
M2373
M2372
M1298
M1297
M1296
ROBERT & MARY KONDDRATOWICZ
JAMES A. PELISSERO
M-1295
JOHN A. & JO ANN KIRSCHNER
M-1280
M-1279
M-2394
M-2393
M-2797
M-2796
M-2795
M-2794
M-2792
M-2793
M-2626
M-27798
M-2635
M-2800
GERALD L. & JONE L. GERBA
M-2798
M-2799
M-2820
M-2821
M-2822
MATTHEW R. & DIANE M. KUPPELWEISER, JR.
REBECCA L.
BILL L. WILLIAMS
ROY & MARY JO MITCHELL
EUGENE R. FLAMENT
Micon Seals
JAMES A. & EDITH F. HANK
River Leech Road
Eugene R. & Nancy L. Flament
PITTSBURGH & WEST VIRGINIA R.R. CO.
M-1251(P)
M-1250
M-1249
M-1253
M-1254(P)
M-1252(P)
M-1245
M-1243
M-1256
M-1255(P)
M-1266
M-1264(P)
M-1233
M-1234(P)
M-1222
M-2824
MICON SEALS (TRAPS OPEN)
Joseph & Martha Brown
B MAIN BUTTS LEFT
SLURRY BOREHOLE
EUGENE W. & MARY M. BOBNAR
MCMI

400 200 0 200 400

PLAN SCALE: 1"= 200'

COMMONWEALTH OF PENNSYLVANIA
REGISTERED PROFESSIONAL ENGINEER
W. HARRY SPRINGER
NO. 25434-E

W. Harry Springer 01-09-06

W. HARRY SPRINGER

DATE

FIT TO 10

FIT TO 6

FINAL MAP MC-07