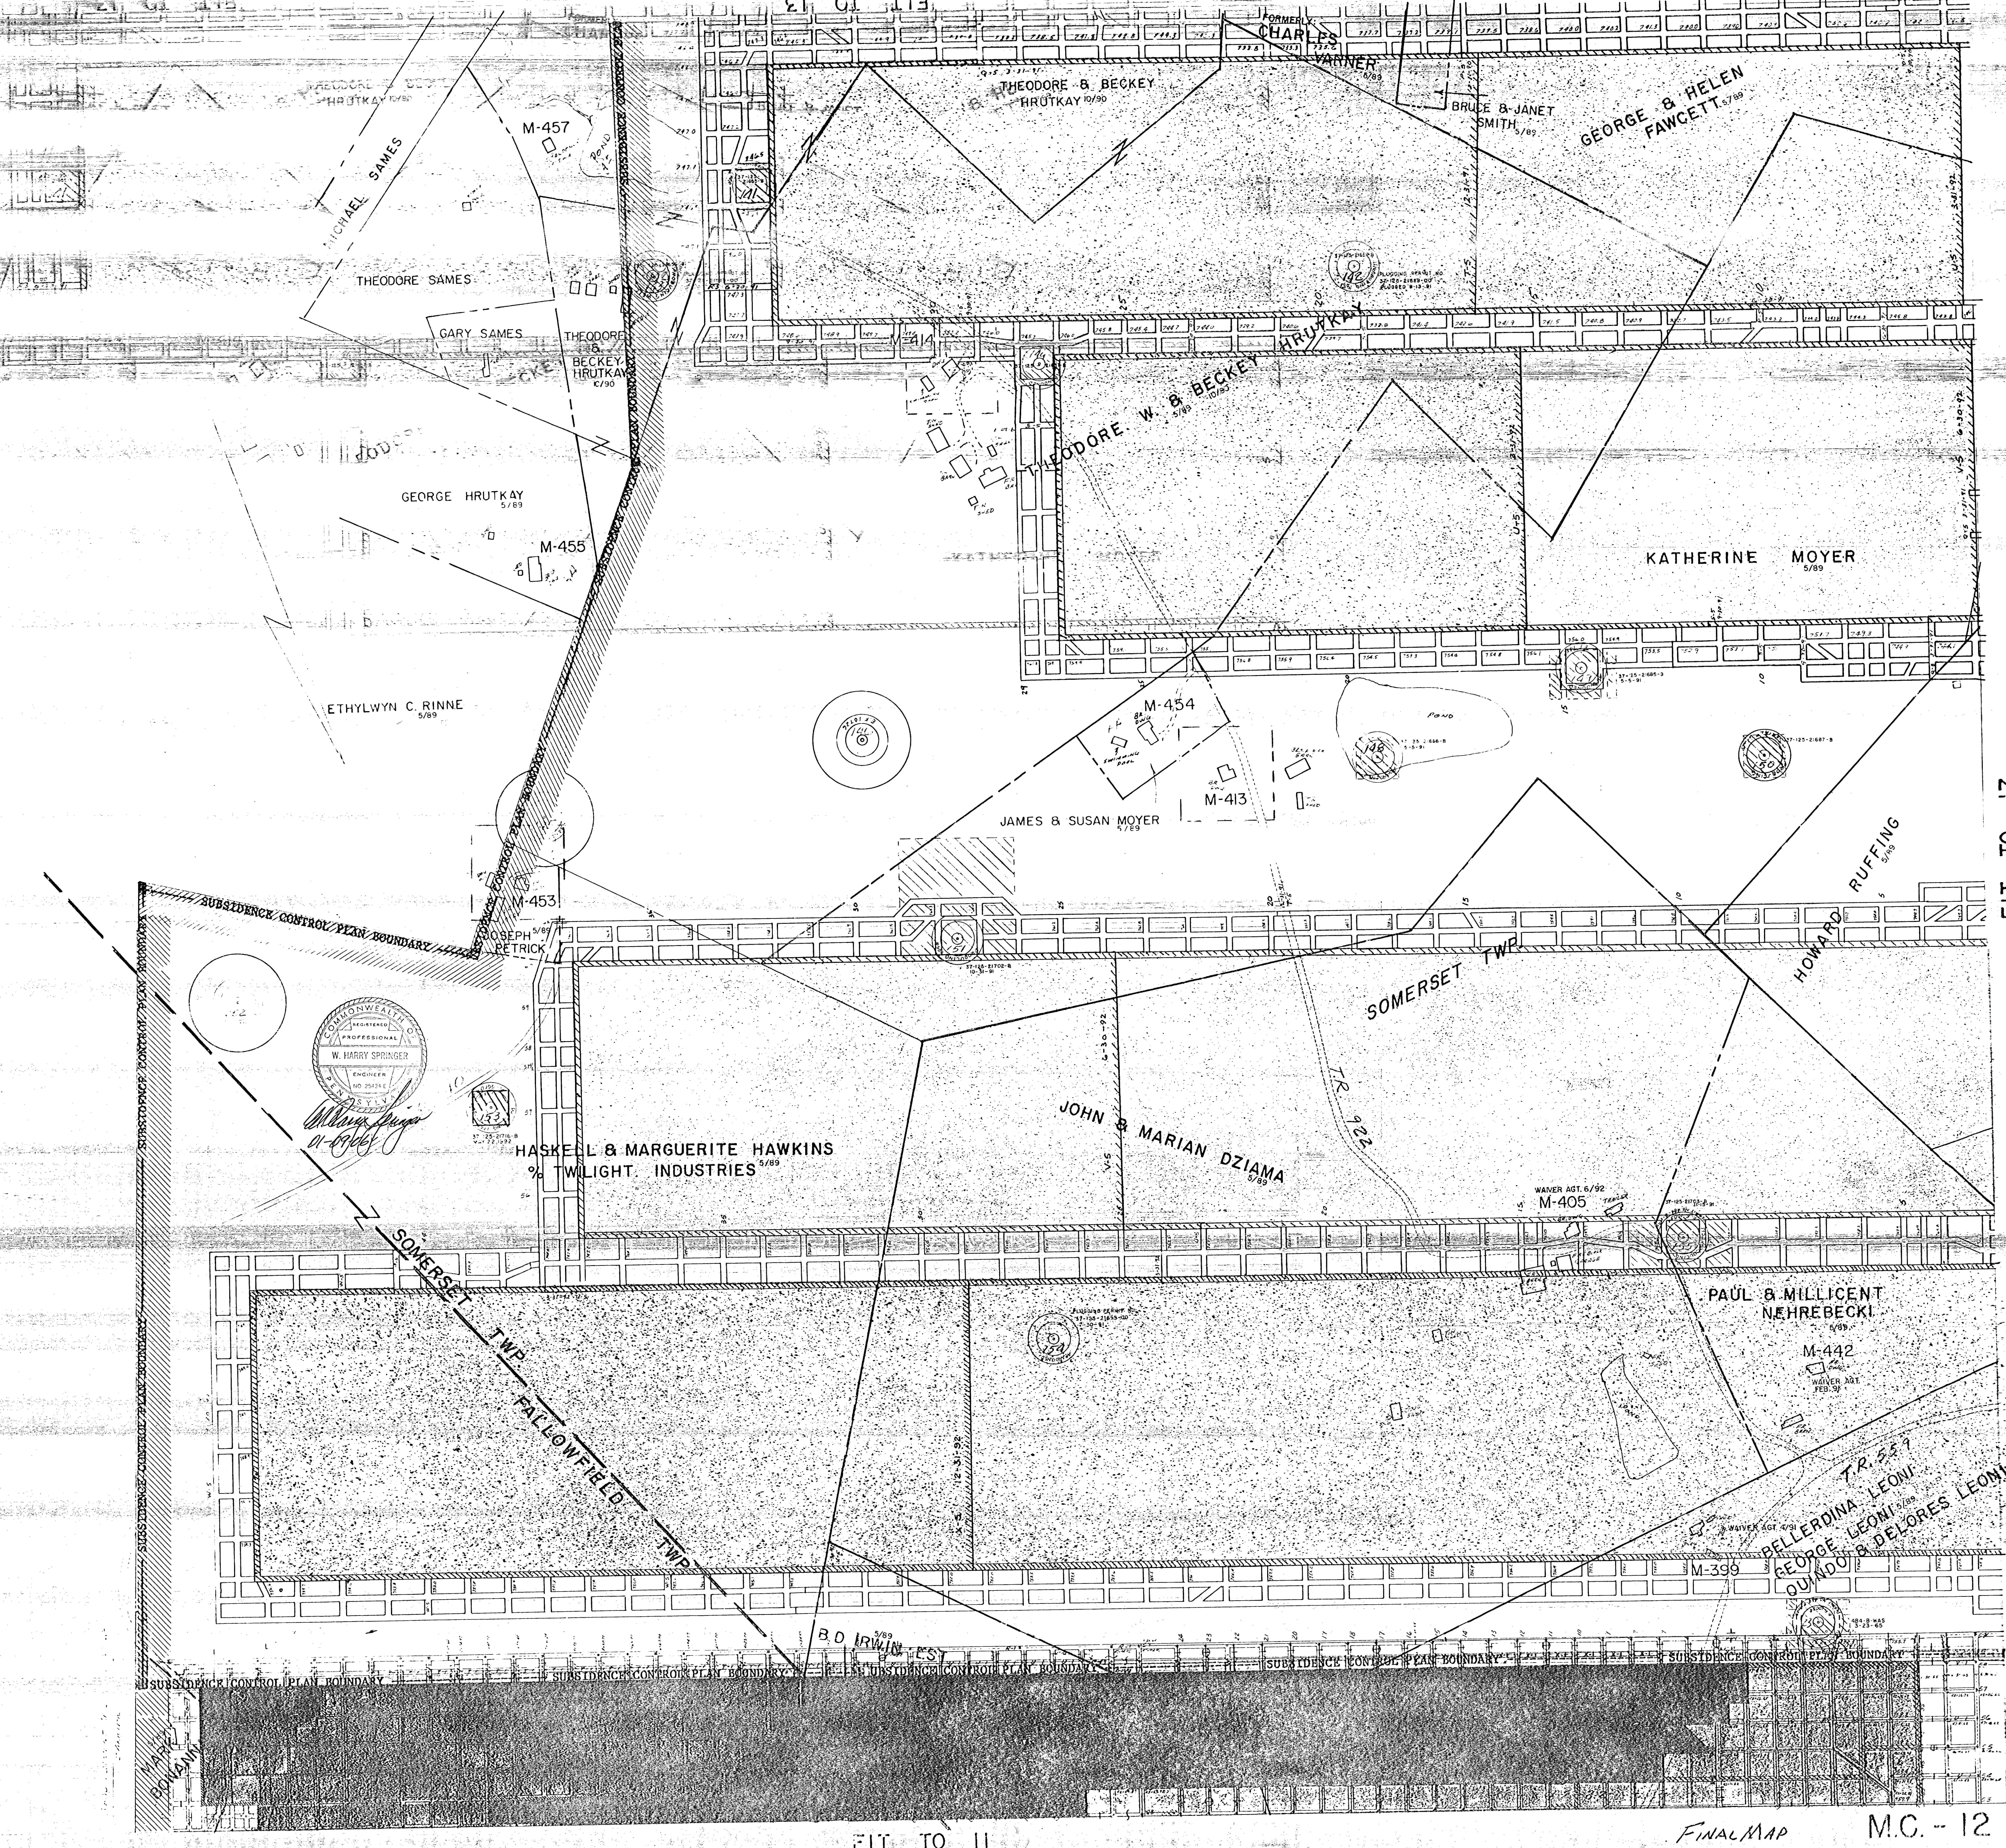
FIT TO 13
FORMERLY: CHARLES VANNER 5/89
THEODORE & BECKEY HRUTKAY 10/90
BRUCE & JANET SMITH 5/89
GEORGE & HELEN FAWCETT 5/89
M-457
POND
MICHAEL SAMES
THEODORE SAMES
GARY SAMES
THEODORE & BECKEY HRUTKAY 10/90
M-414
THEODORE W. & BECKEY HRUTKAY 5/89 10/90
GEORGE HRUTKAY 5/89
M-455
KATHERINE MOYER 5/89
ETHYLWYN C. RINNE 5/89
M-454
SWIMMING POOL
M-413
POND
JAMES & SUSAN MOYER 5/89
FIT TO 17
HOWARD RUFFING 5/89
M-453
JOSEPH PETRICK 5/89
SUBSIDENCE CONTROL PLAN BOUNDARY
37-125-21702-B 10-31-91
37-125-21685-3 5-5-91
37-125-21666-B 5-5-91
37-125-21687-B
PLUGGING PERMIT NO. 37-125-21689-00 PLUGGED 9-13-91
SOMERSET TWP.
37-125-21716-B MAY 22,1992
HASKELL & MARGUERITE HAWKINS % TWILIGHT INDUSTRIES 5/89
JOHN & MARIAN DZIAMA 5/89
T.R. 922
WAIVER AGT. 6/92
M-405
TRAILER
FR. GARAGE
PAUL & MILLICENT NEHREBECKI 5/89
M-442
WAIVER AGT. FEB. 91
PLUGGING PERMIT NO. 37-125-21655-00 7-30-91
SOMERSET TWP.
FALLOWFIELD TWP.
T.R. 559
WAIVER AGT 4/91
BELLERDINA LEONI
GEORGE LEONI 5/89
QUINDO & DELORES LEONI
M-399
484-B-WAS 3-23-65
B.D. IRWIN EST. 5/89
MARY BONANNI
FIT TO 11

W. HARRY SPRINGER
NO. 25434-E
01-09-06

FINAL MAP

M.C. - 12