


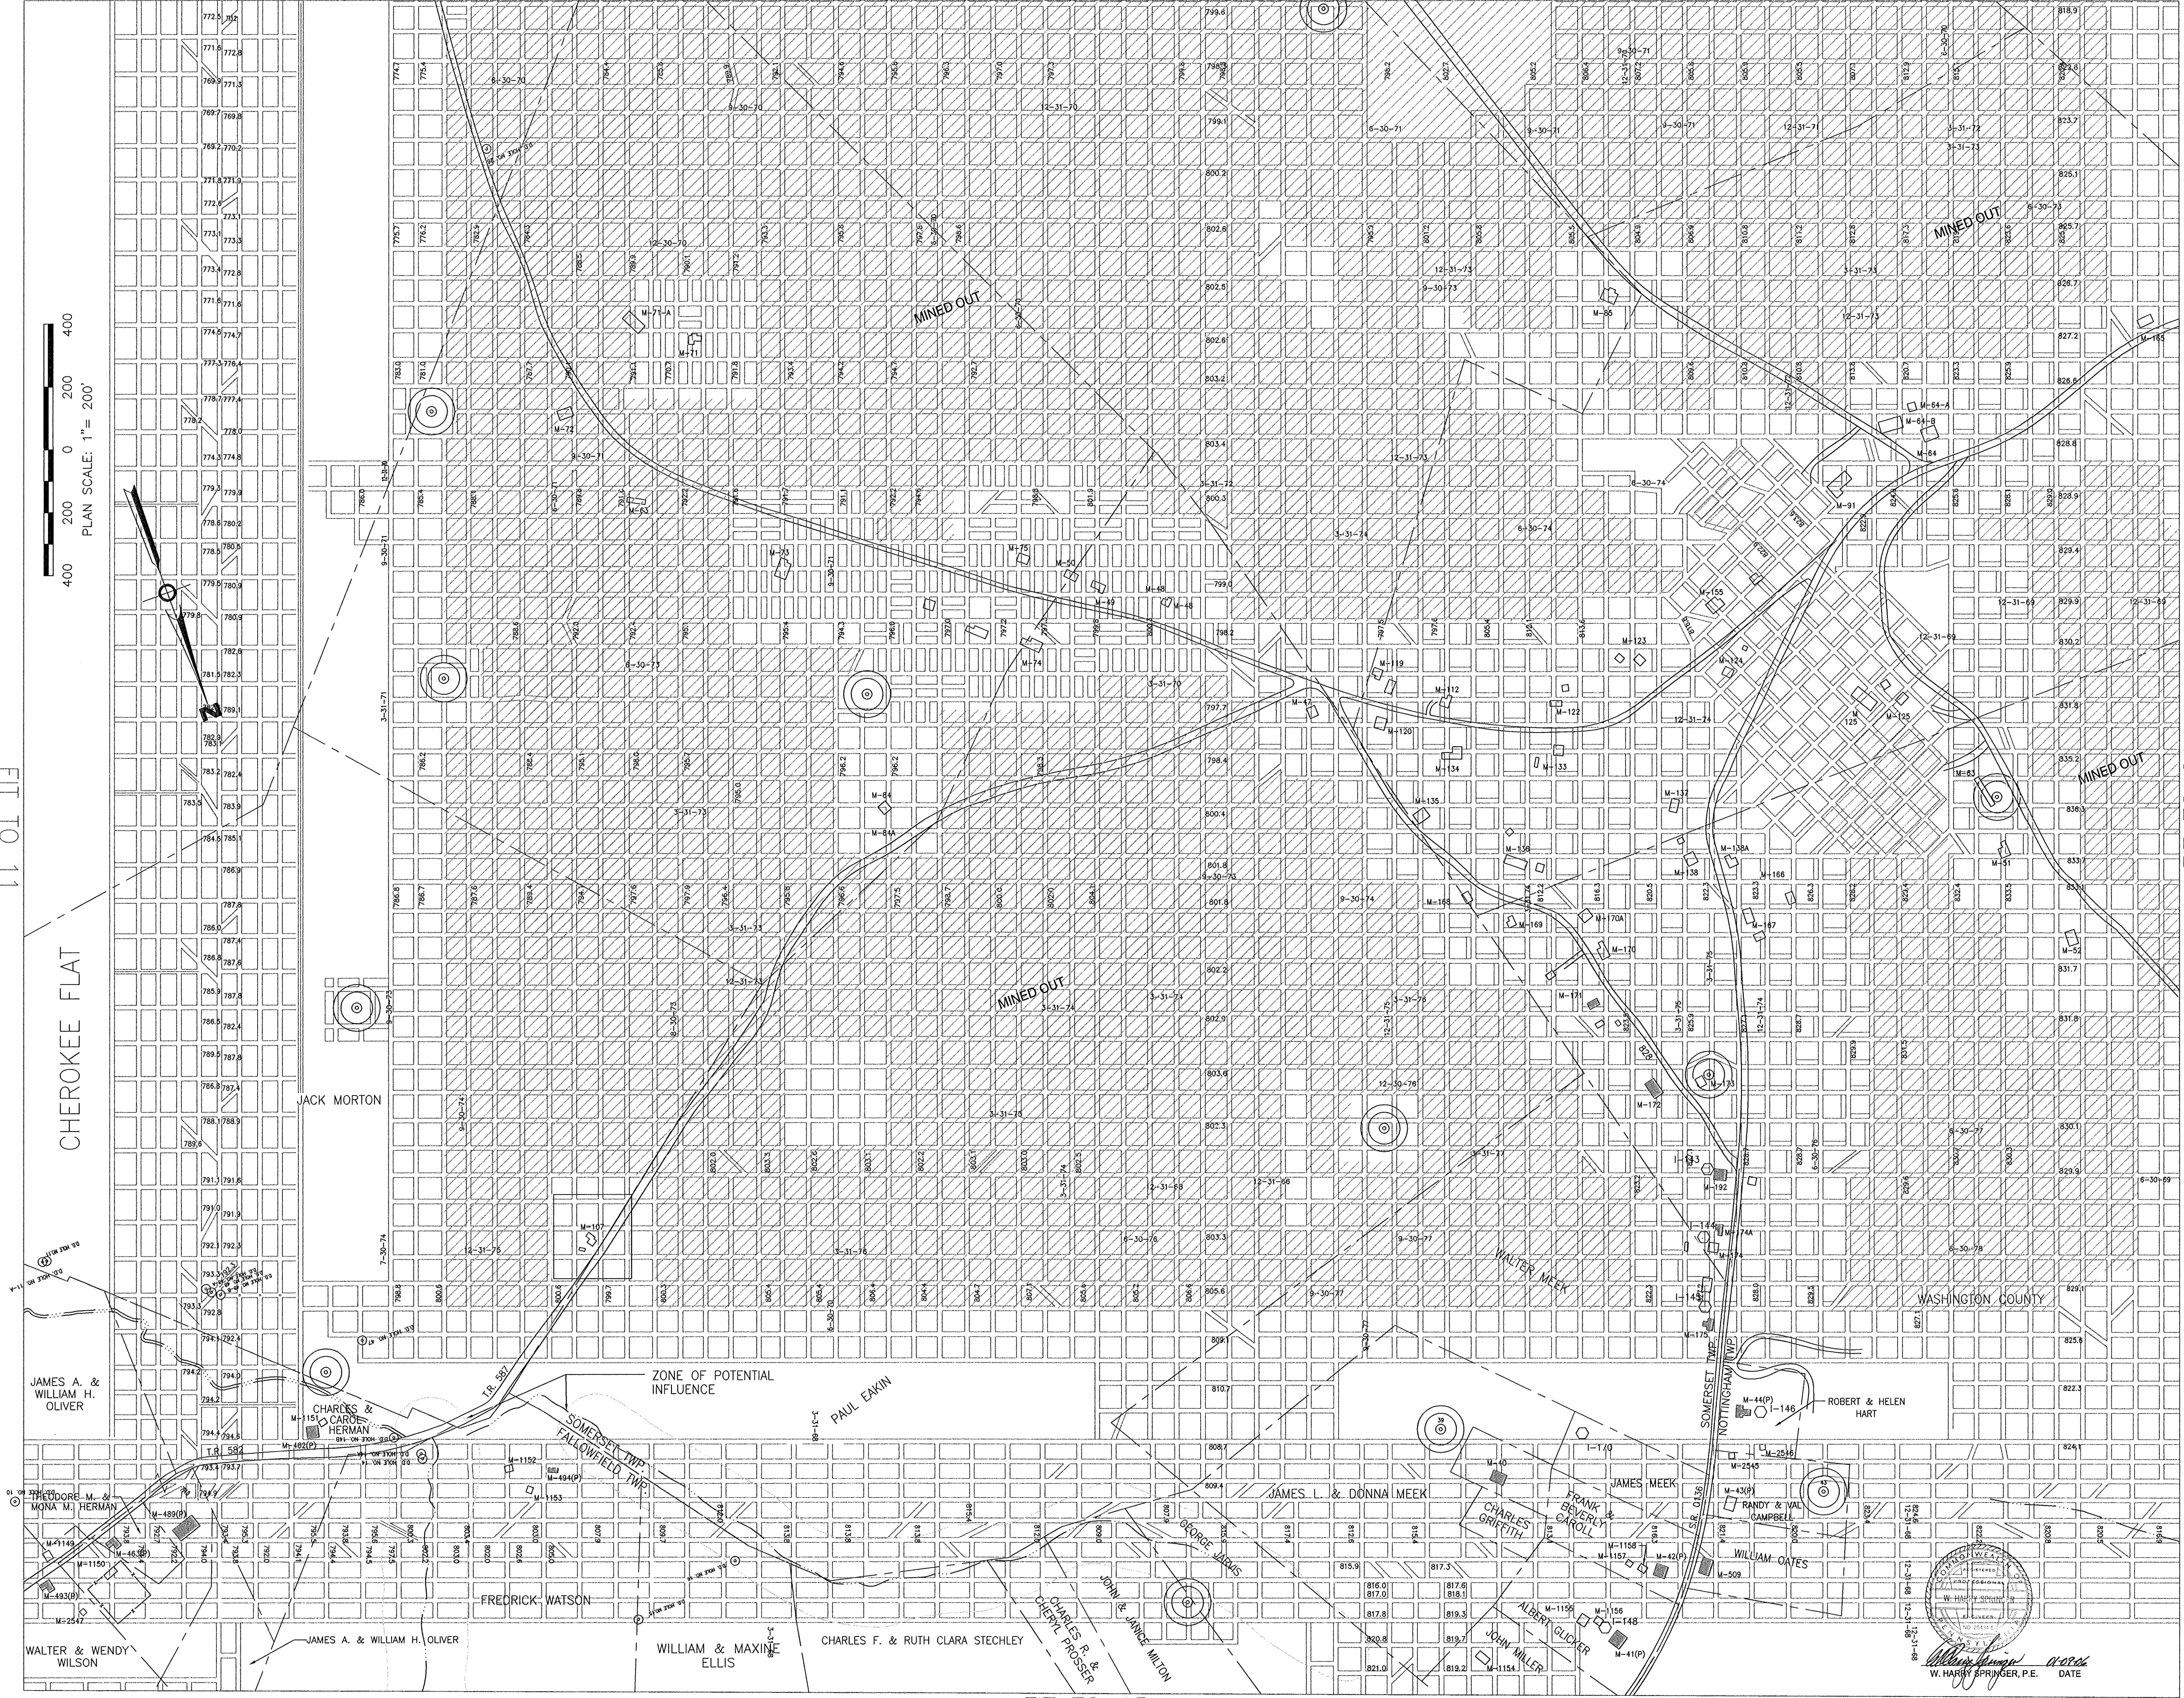

FIT TO 11

CHEROKEE FLAT



FIT TO 21

FIT TO 15