
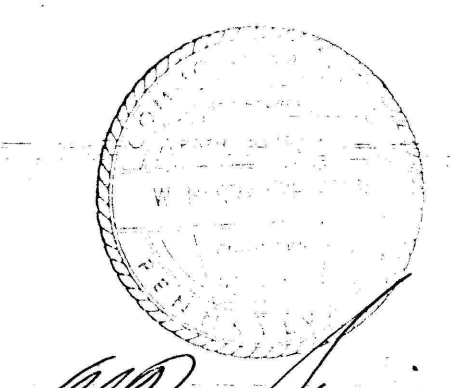


FIT TO 28

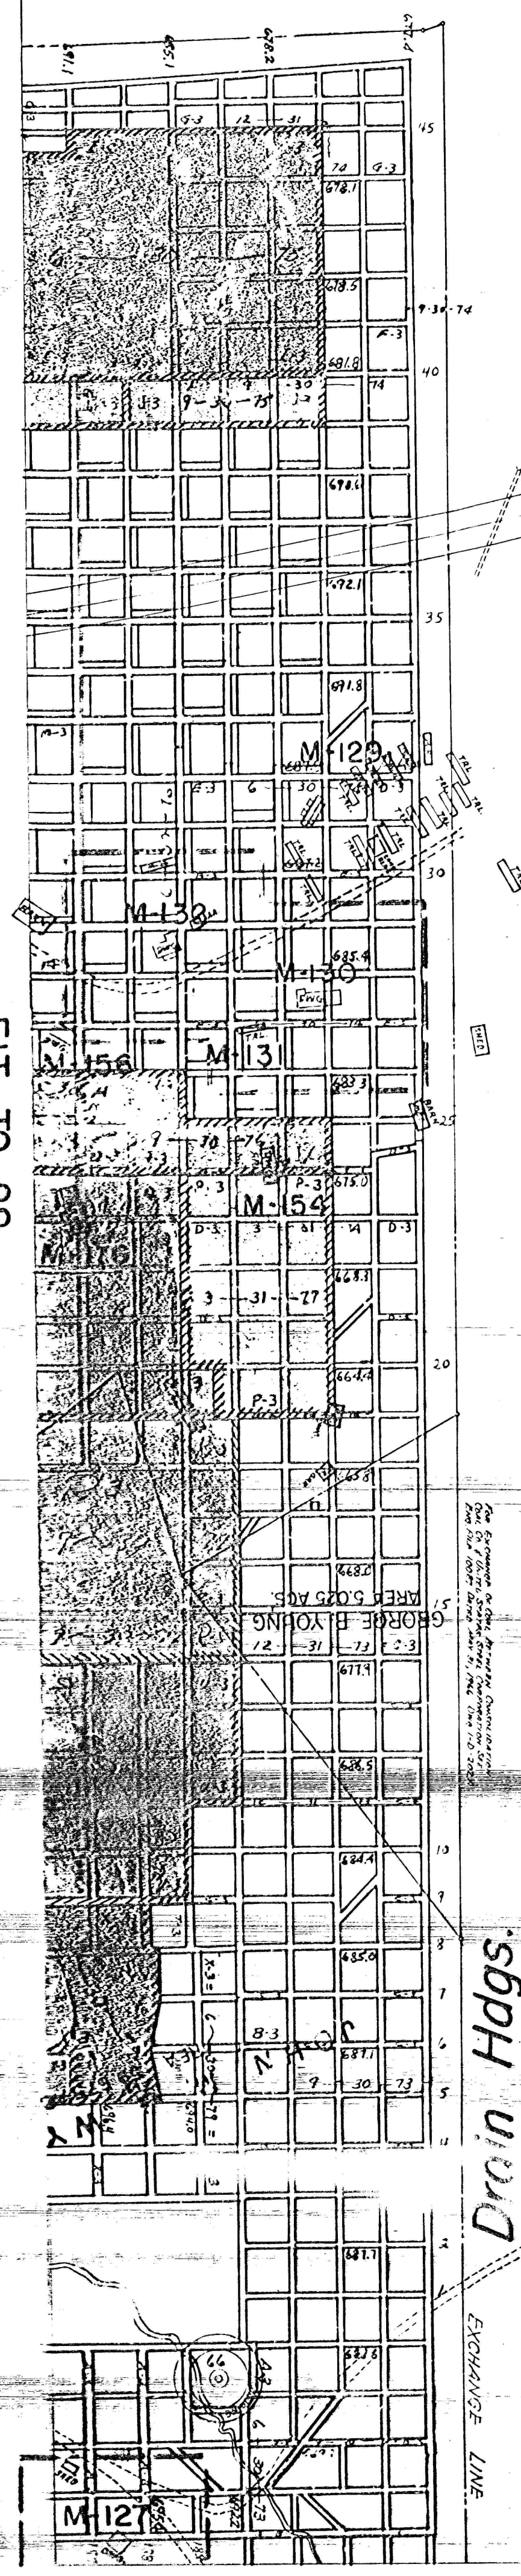

M. D. Young 11-17-06

FIT TO 32