

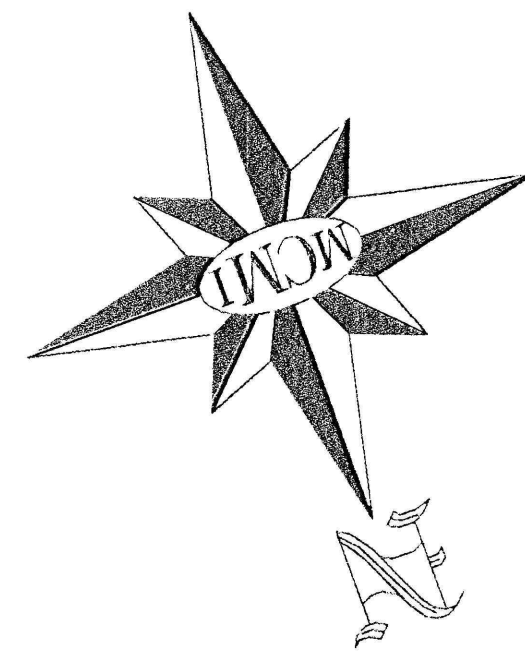


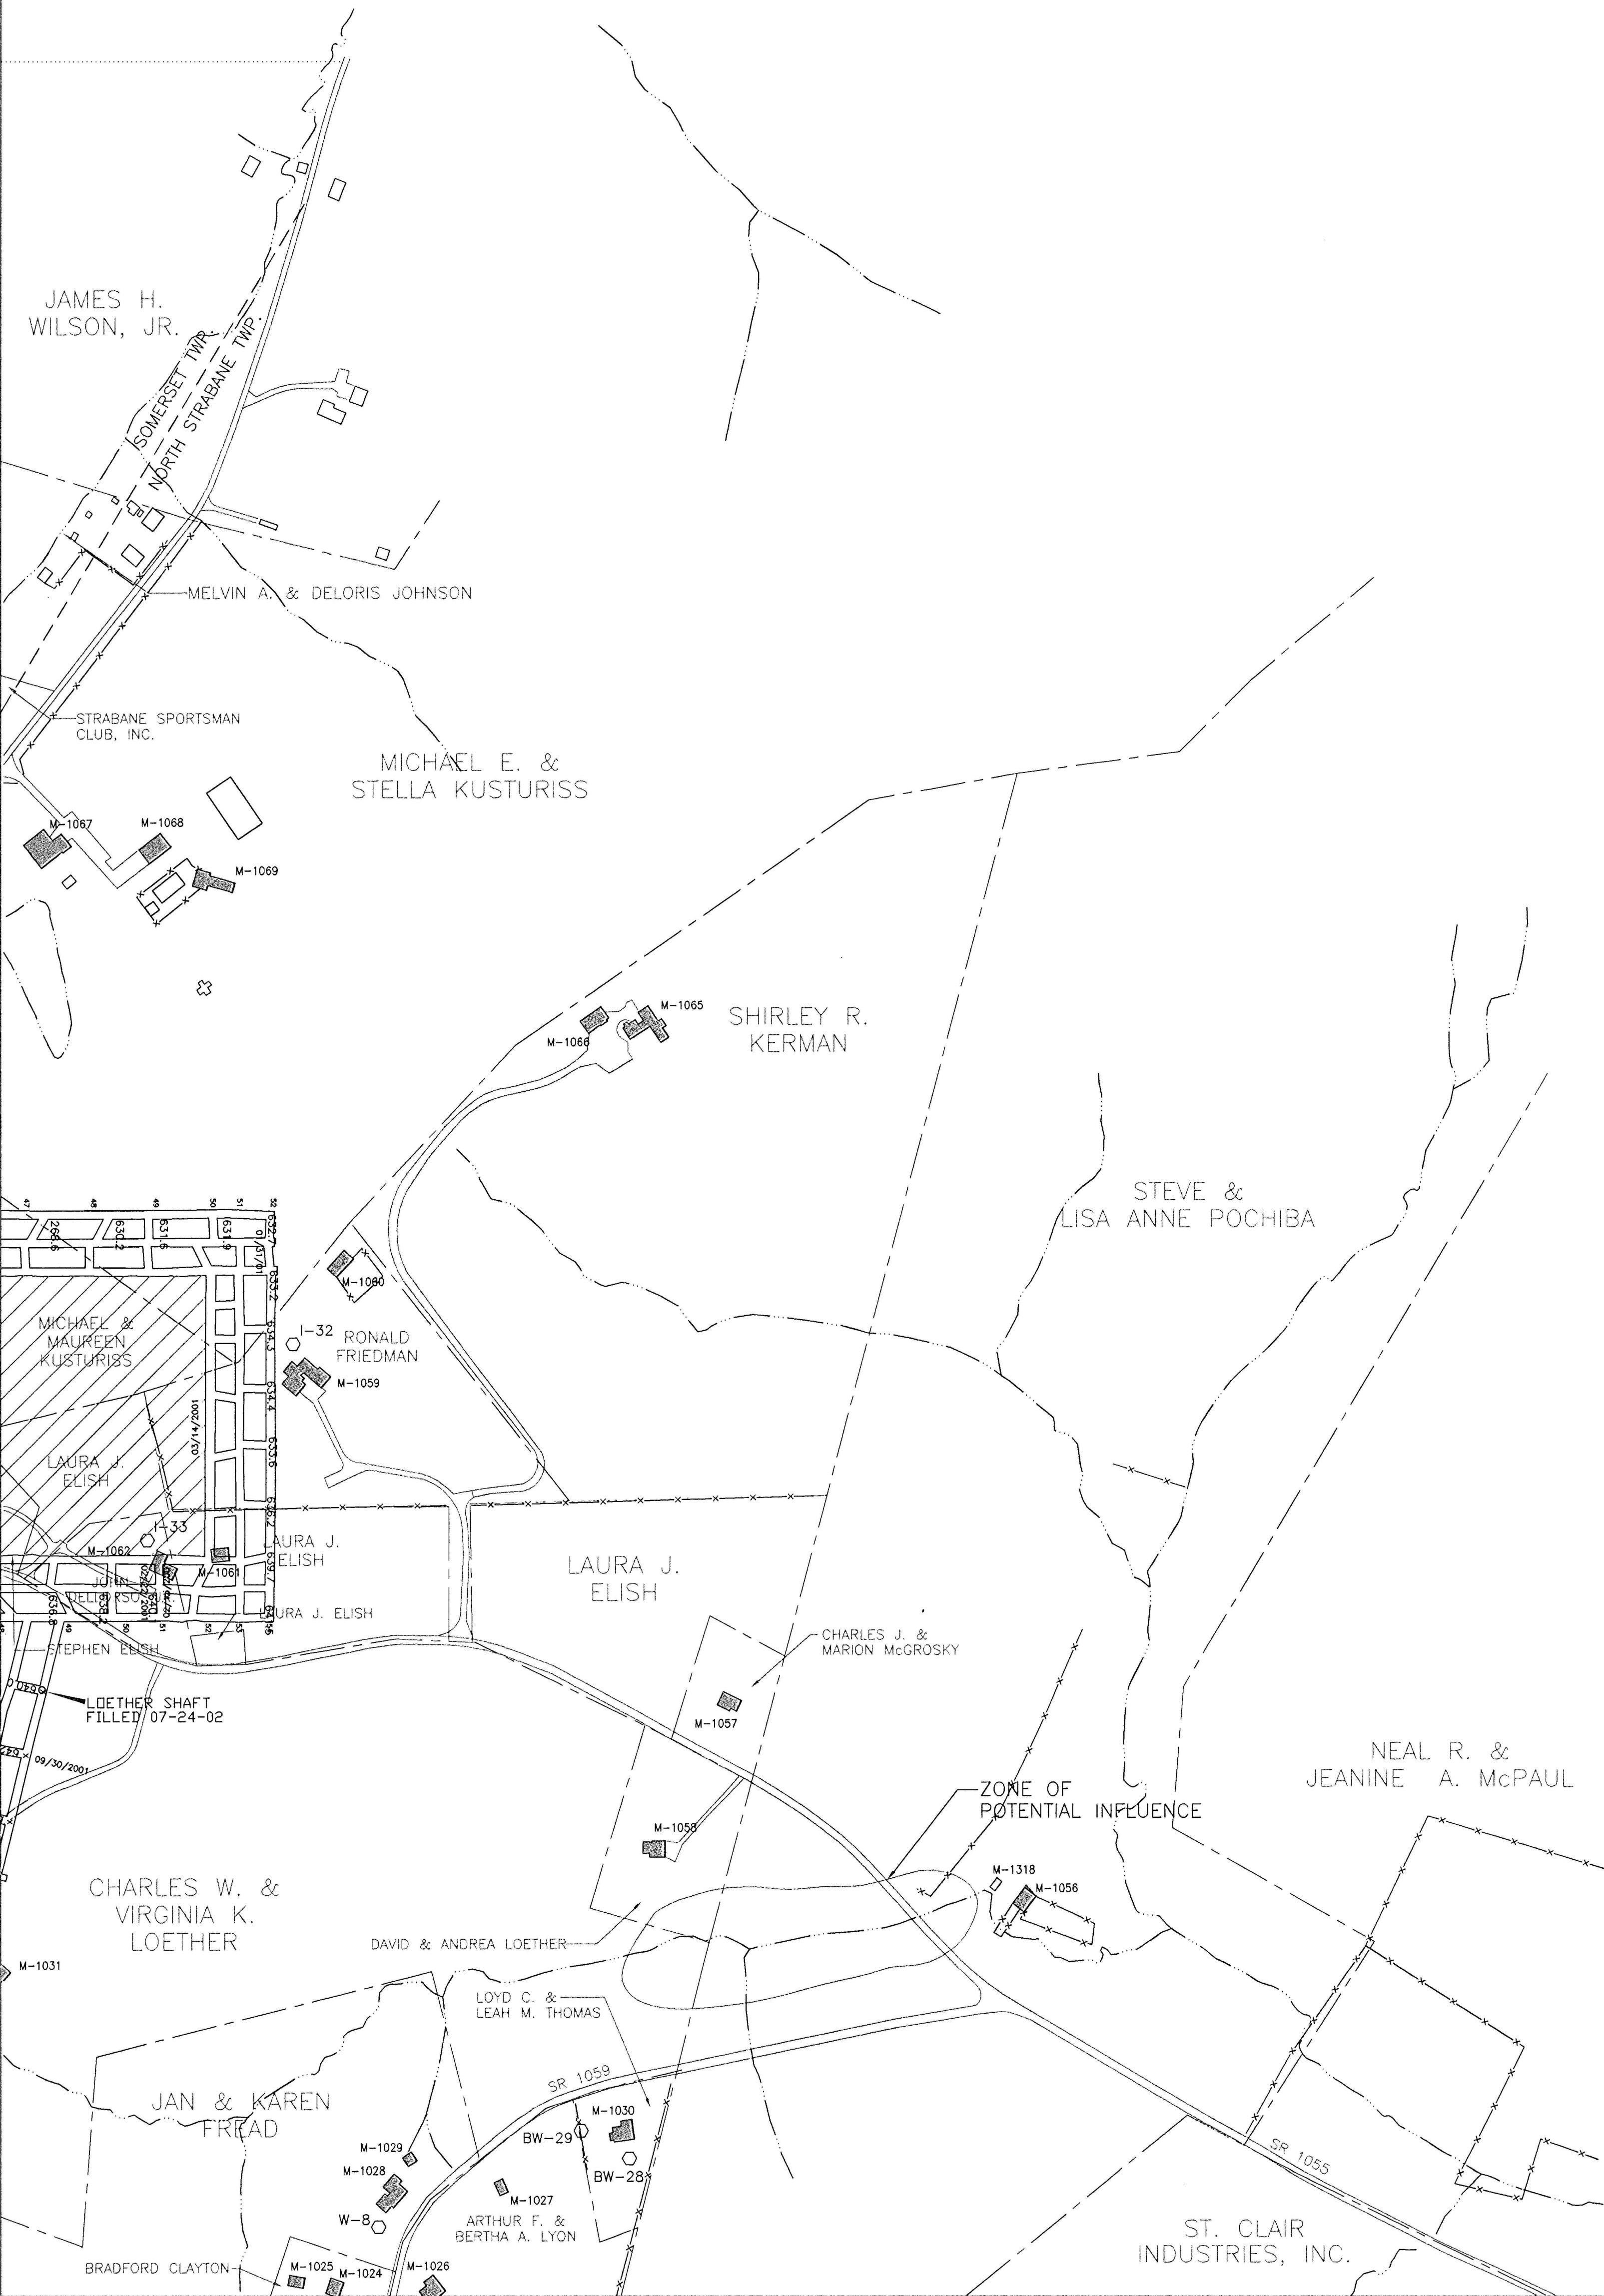

400 200 0 200 400
PLAN SCALE: 1" = 200'

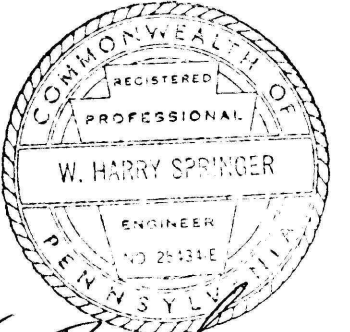

W. Harry Springer
W. Harry Springer, P.E.
Date 01-07-06