


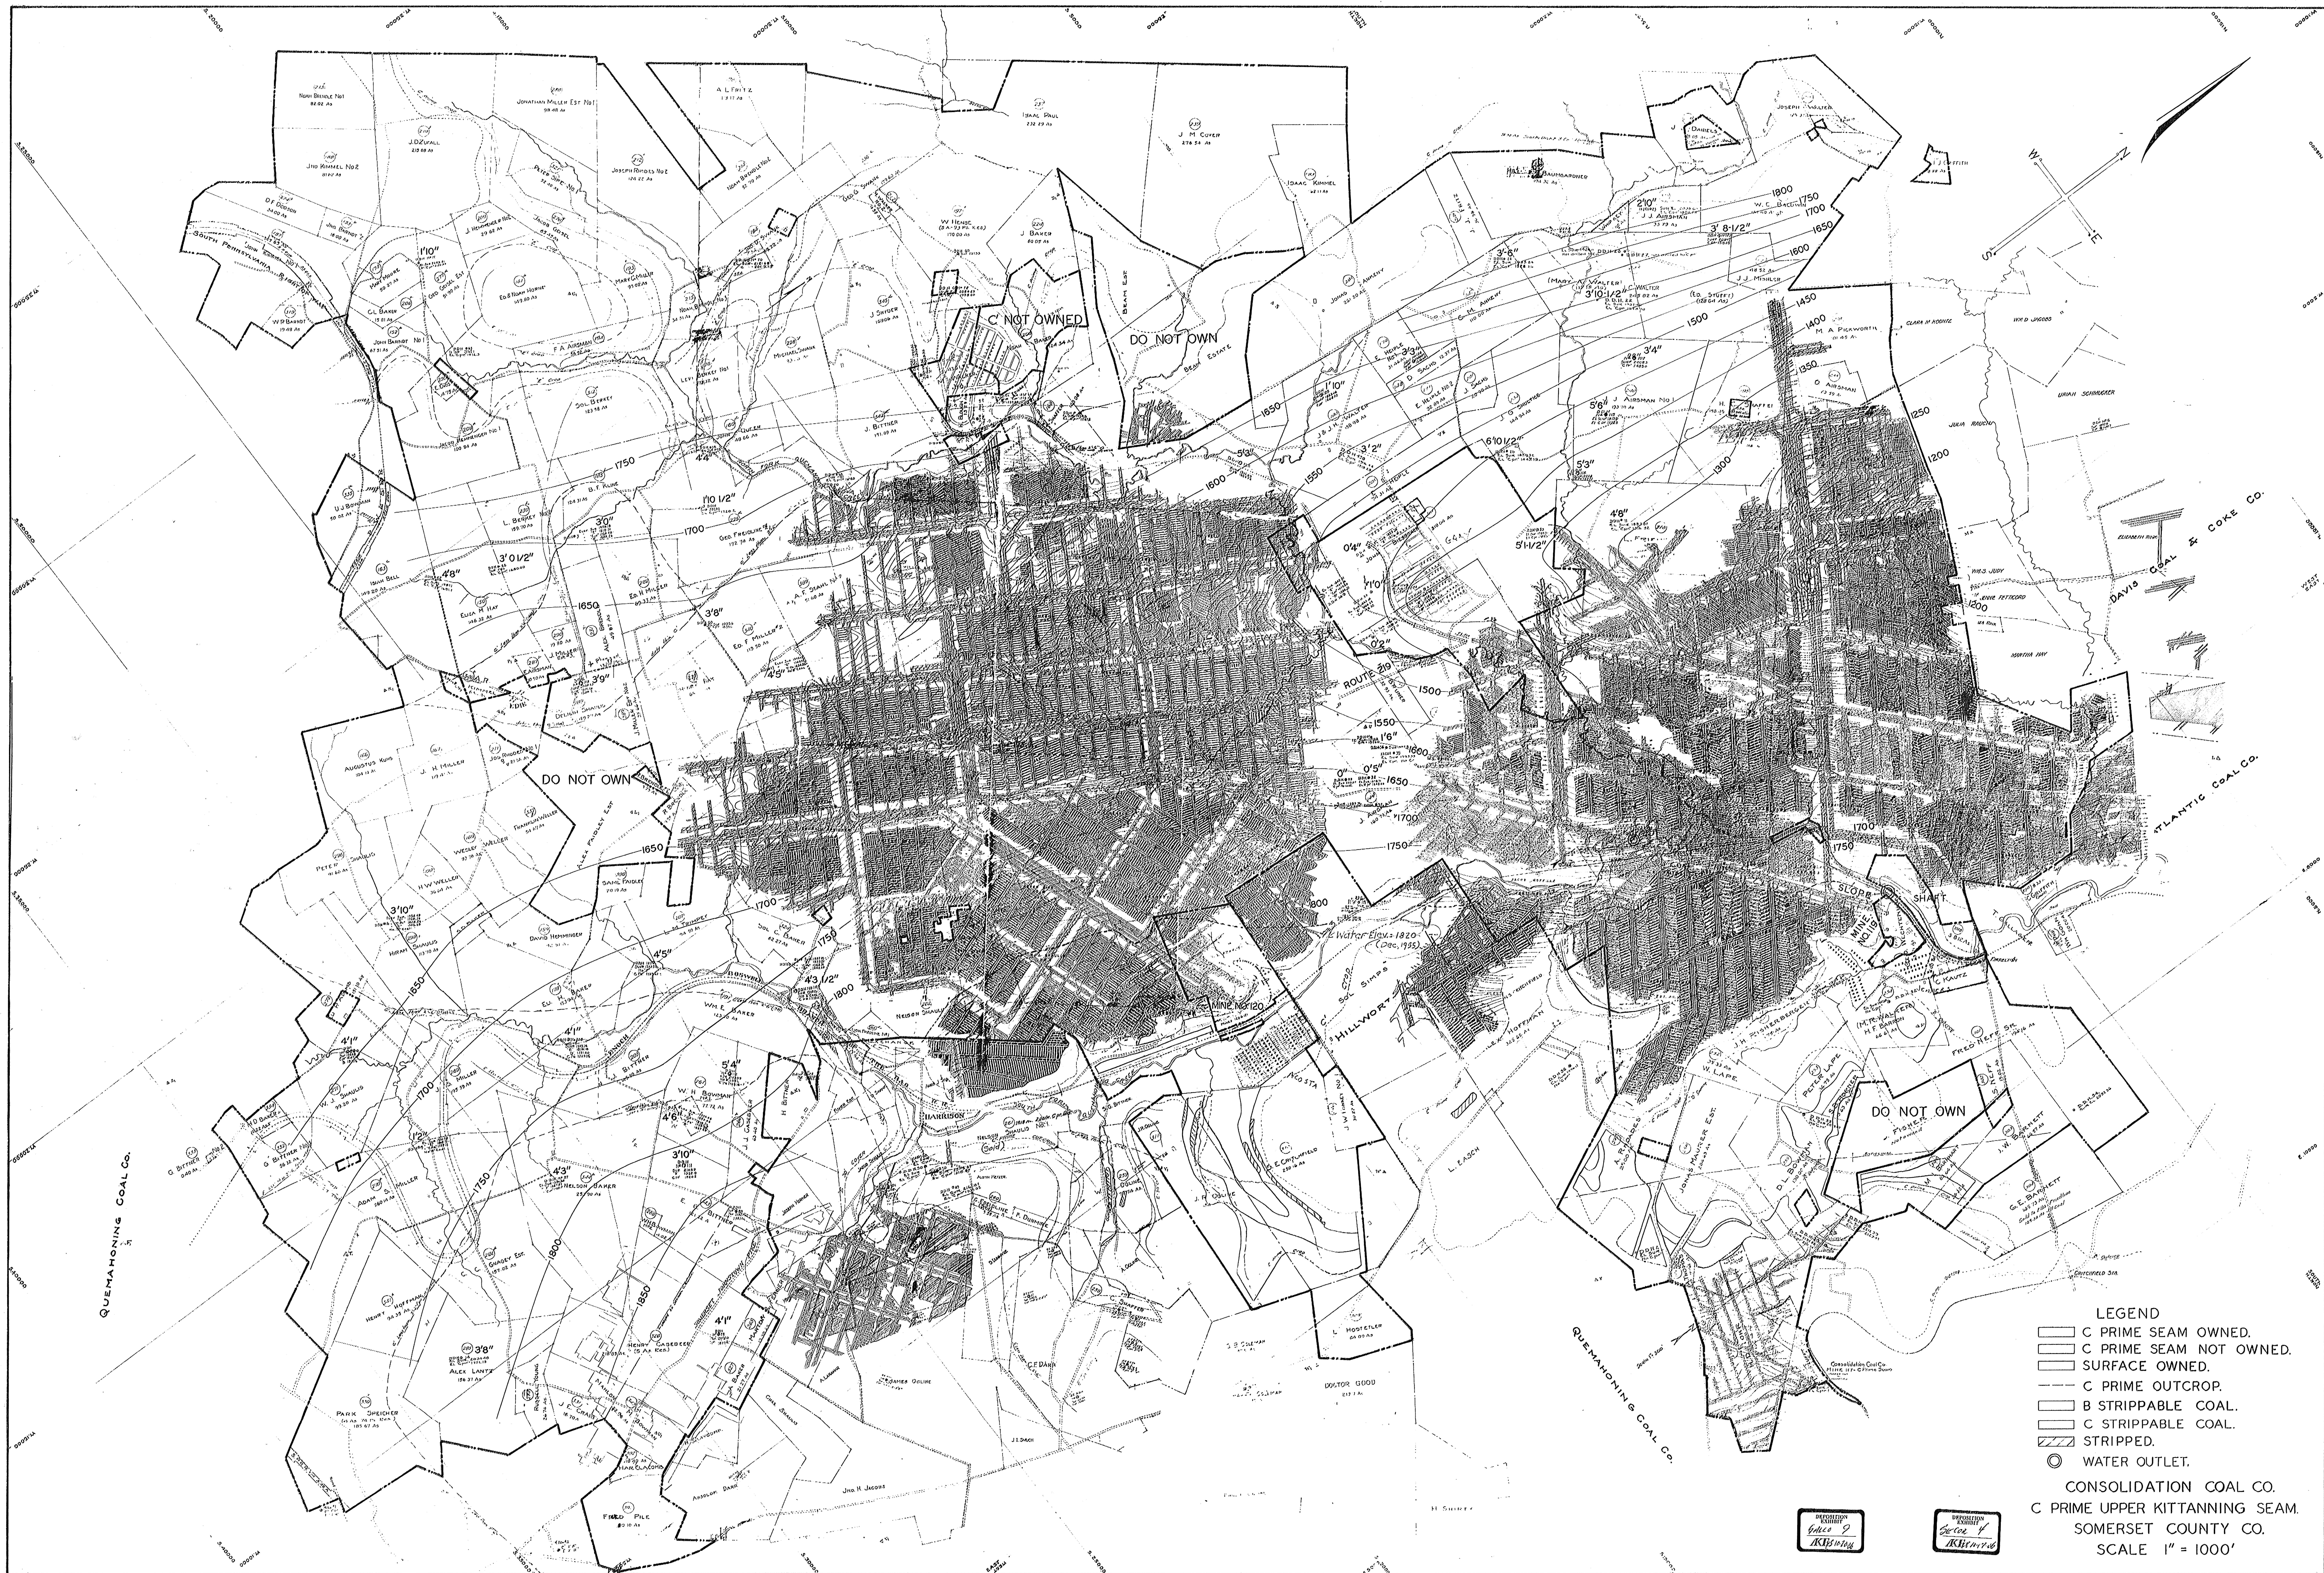

LEGEND

- C PRIME SEAM OWNED.
- C PRIME SEAM NOT OWNED.
- SURFACE OWNED.
- C PRIME OUTCROP.
- B STRIPPABLE COAL.
- C STRIPPABLE COAL.
- STRIPPED.
- WATER OUTLET.

CONSOLIDATION COAL CO.
C PRIME UPPER KITTANNING SEAM.
SOMERSET COUNTY CO.
SCALE 1" = 1000'