


LEGEND

Index	Engineer	Date
11	Geo. Kimmel	Oct 1926
B	F.B. Fluck	Jan 22-27

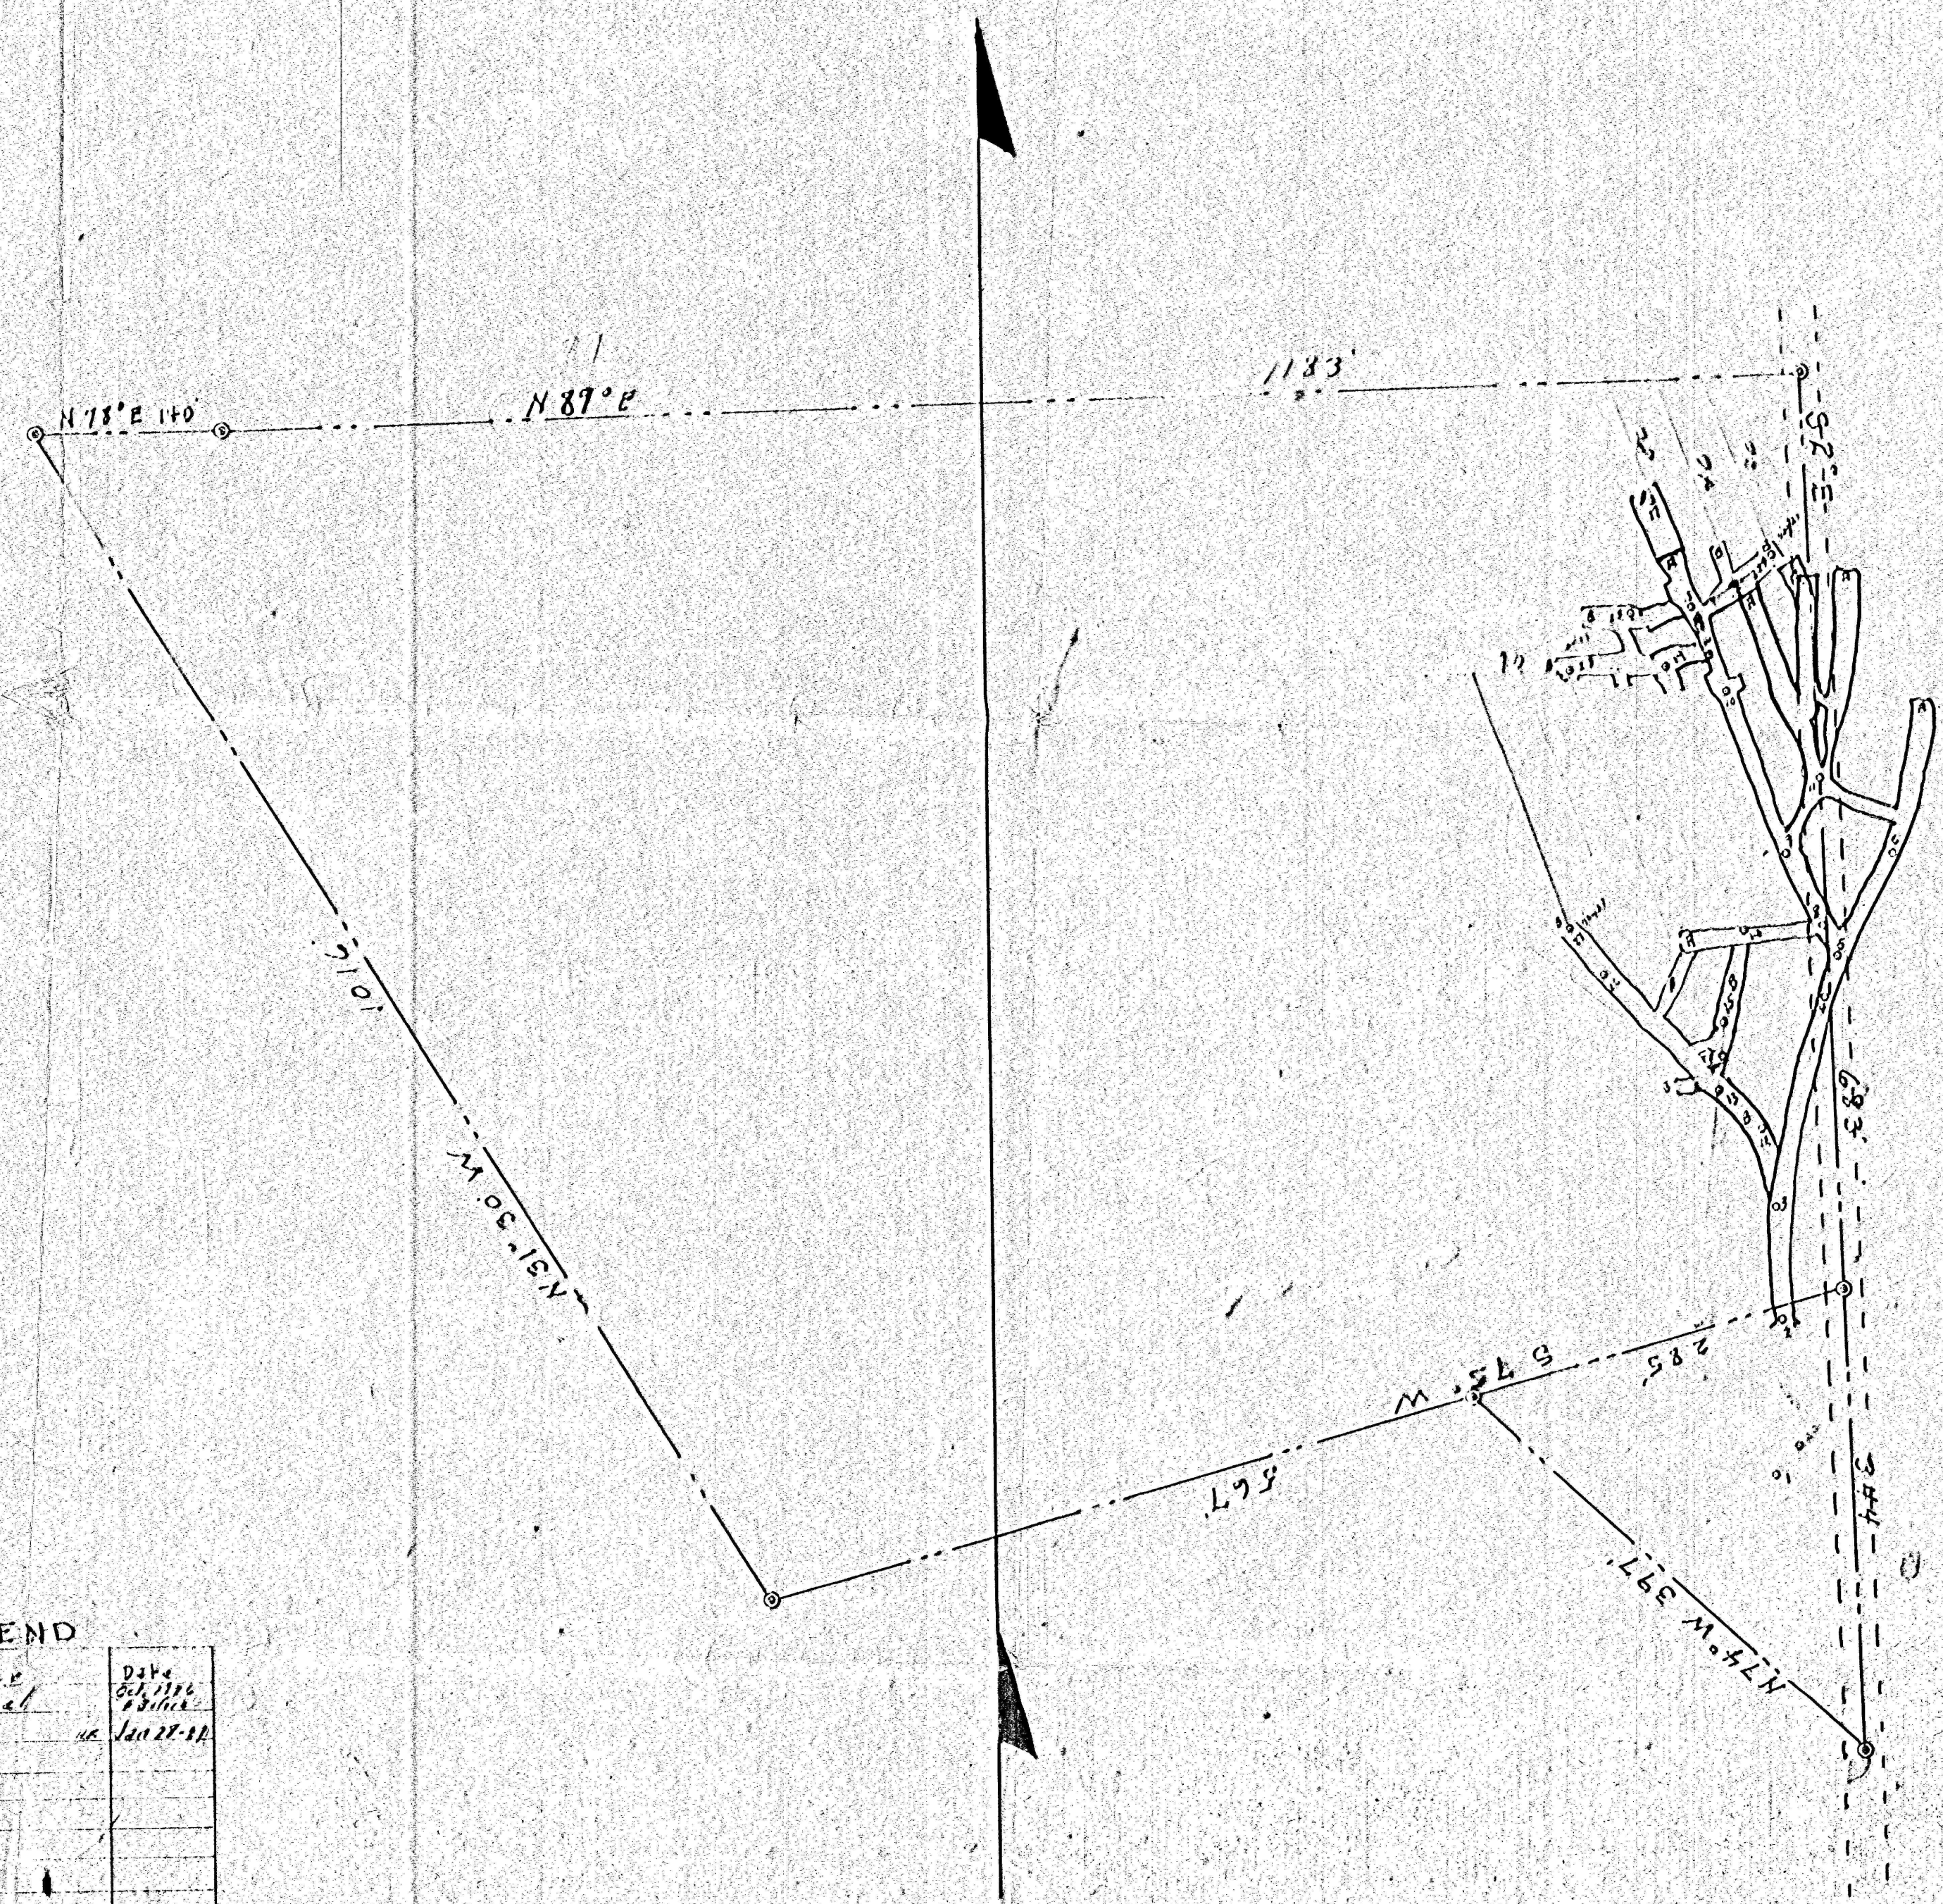

C.L. Davis & Co.
Helen Mine
Somerset Twp.
Scale 1"=100' Oct 1926
F.B. Fluck C.E. & M.E.