


3 & H COAL COMPANY
No. 2 Mine Permit No. 3061311
Rankard Twp., Greene County, PA.
Sewickley Coal Seam Scale: 1"=100'
Outline of mining property
1 Dwelling completed after 1966 or (1966-68 houses or other structures)
2 Protected surface structures
3 Shed, barn, or abandoned house
Outline of mining area for period
Permanent air stoppage
Mine air regulator
Mine air overcast
Engineer surveying stations
920' Contour of bottom of coal seam
Mining height of entry
Air door or air lock
Proposed final mine seals
Outline of 5 year mining plan.



"FINAL MAP"
SHEET NO. 5

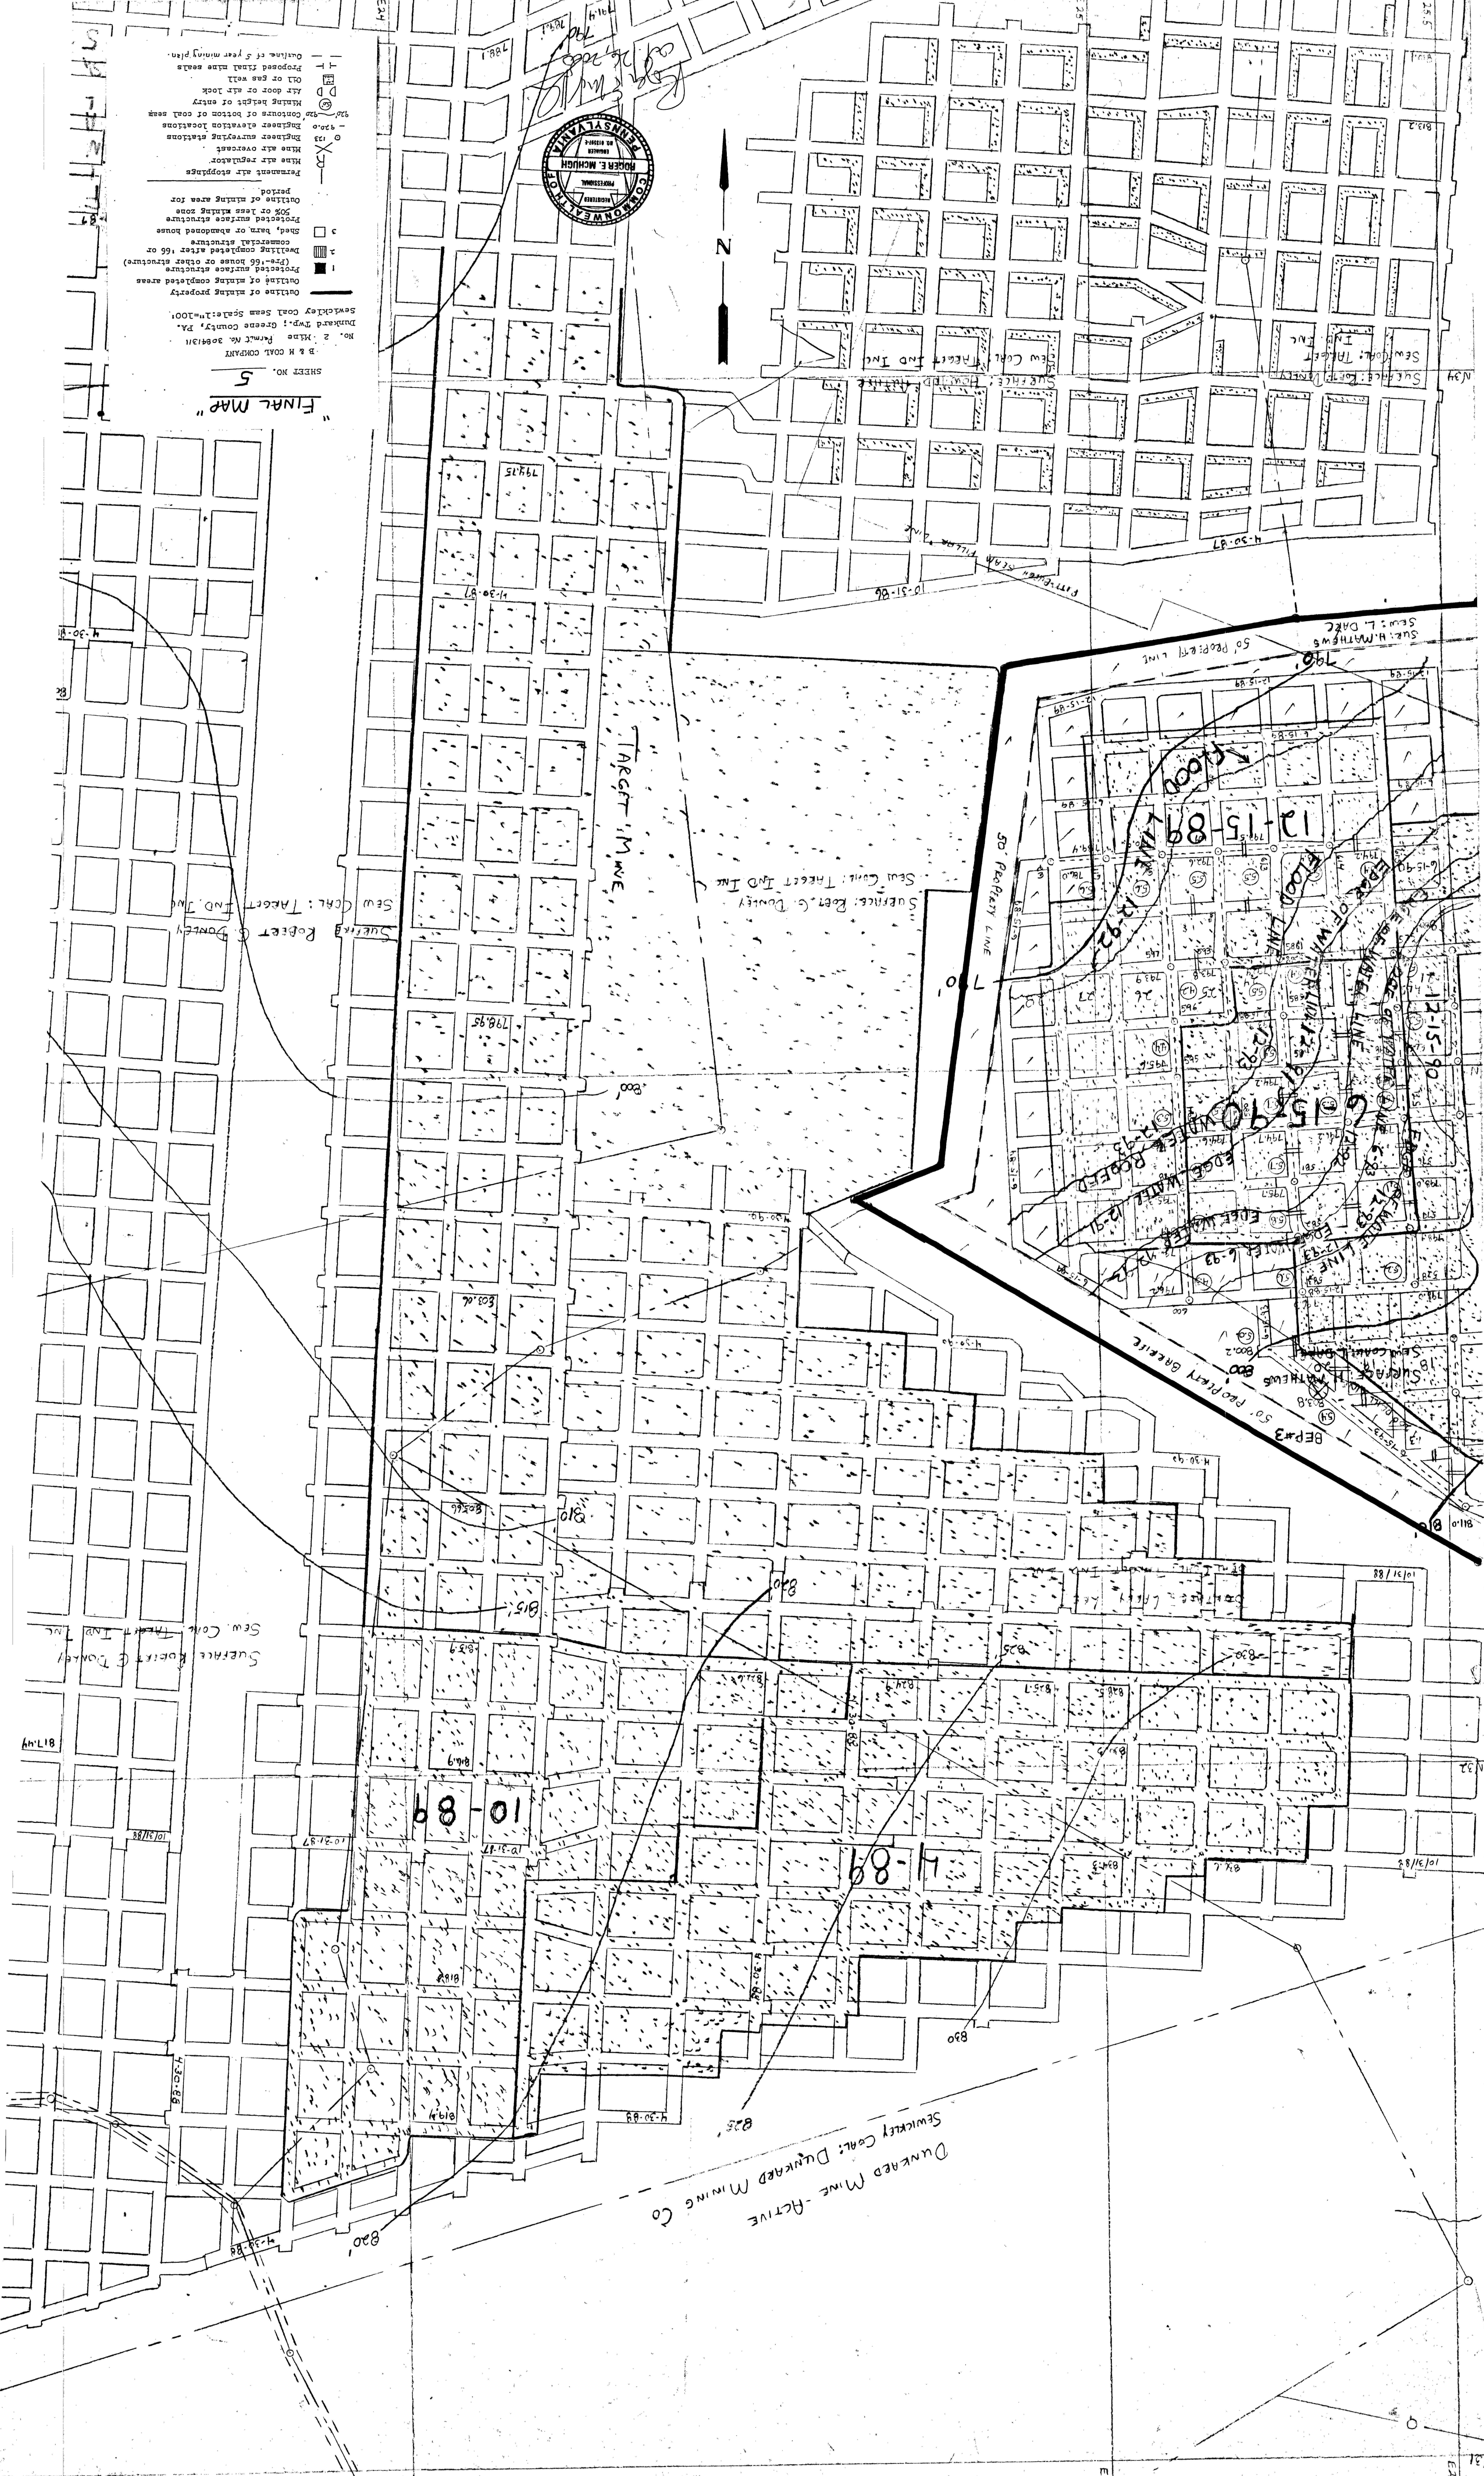

Dunkard Mine - Active
Sewickley Coal: Dunkard Mining Co