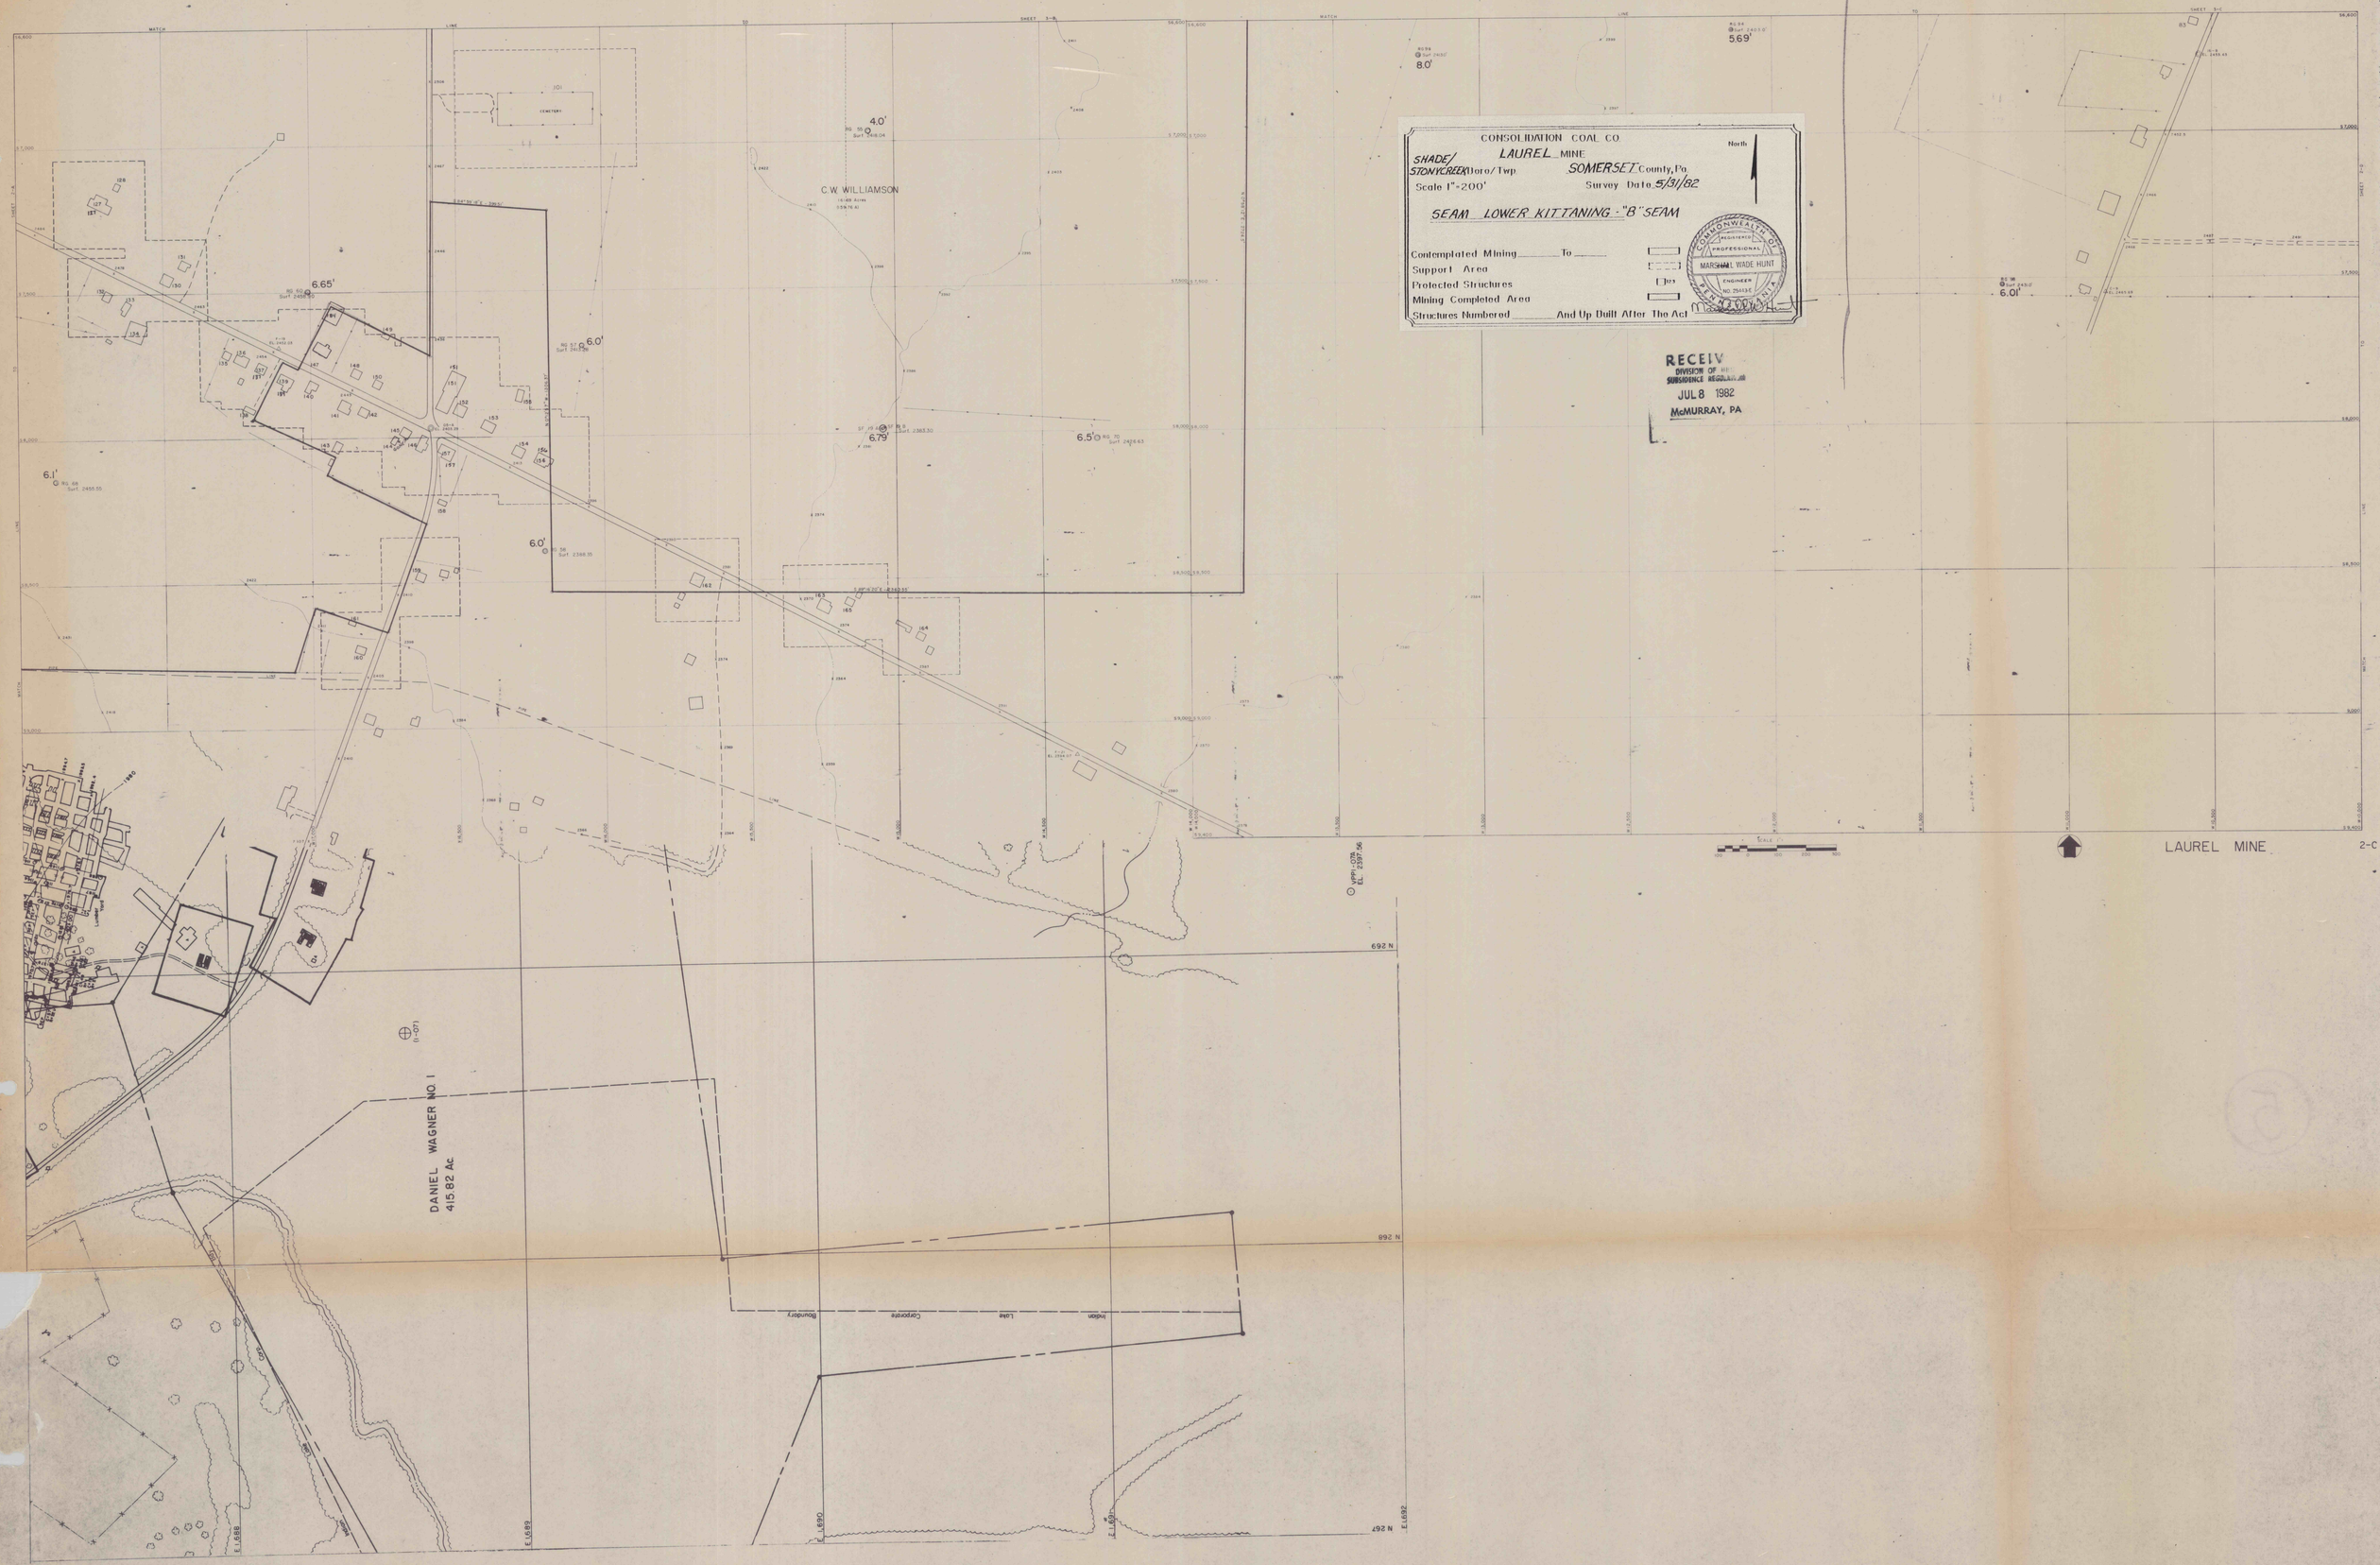
CONSOLIDATION COAL CO.
LAUREL MINE
SHADE/STONYCREEK(Boro/Twp.
SOMERSET County, Pa.
Scale 1"=200'
Survey Date 5/31/82
SEAM LOWER KITTANING - "B" SEAM
Contemplated Mining To
Support Area
Protected Structures
Mining Completed Area
Structures Numbered And Up Built After The Act
North
COMMONWEALTH OF PENNSYLVANIA
REGISTERED PROFESSIONAL ENGINEER
MARSHALL WADE HUNT
NO. 25413-E
RECEIVED
DIVISION OF MINE SUBSIDENCE REGULATION
JUL 8 1982
McMURRAY, PA
C.W. WILLIAMSON
DANIEL WAGNER NO. 1
415.82 Ac.
Indian Lake Corporate Boundary
LAUREL MINE
2-C

LAUREL-005