

LAUREL MINES CORPORATION

P. O. BOX 12022
LEXINGTON, KENTUCKY 40579

DATE: AUGUST 1984

LOWER KITTANNING ("B") SEAM

SHADE AND STONY CREEK
TOWNSHIPS IN SOMERSET
COUNTY

SCALE: 1"=200'

REVISED 8/91


- PROPERTY BOUNDARY
- PERMIT BOUNDARY
- SUBSIDENCE CONTROL BOUNDARY
- PRE - 1966 DWELLING
- POST - 1966 DWELLING
- PUBLIC BUILDINGS
- PRE - 1966 CEMETERIES



RECEIVED

AUG 19 1991

Dept. of Environmental Resources
McMurray District Office

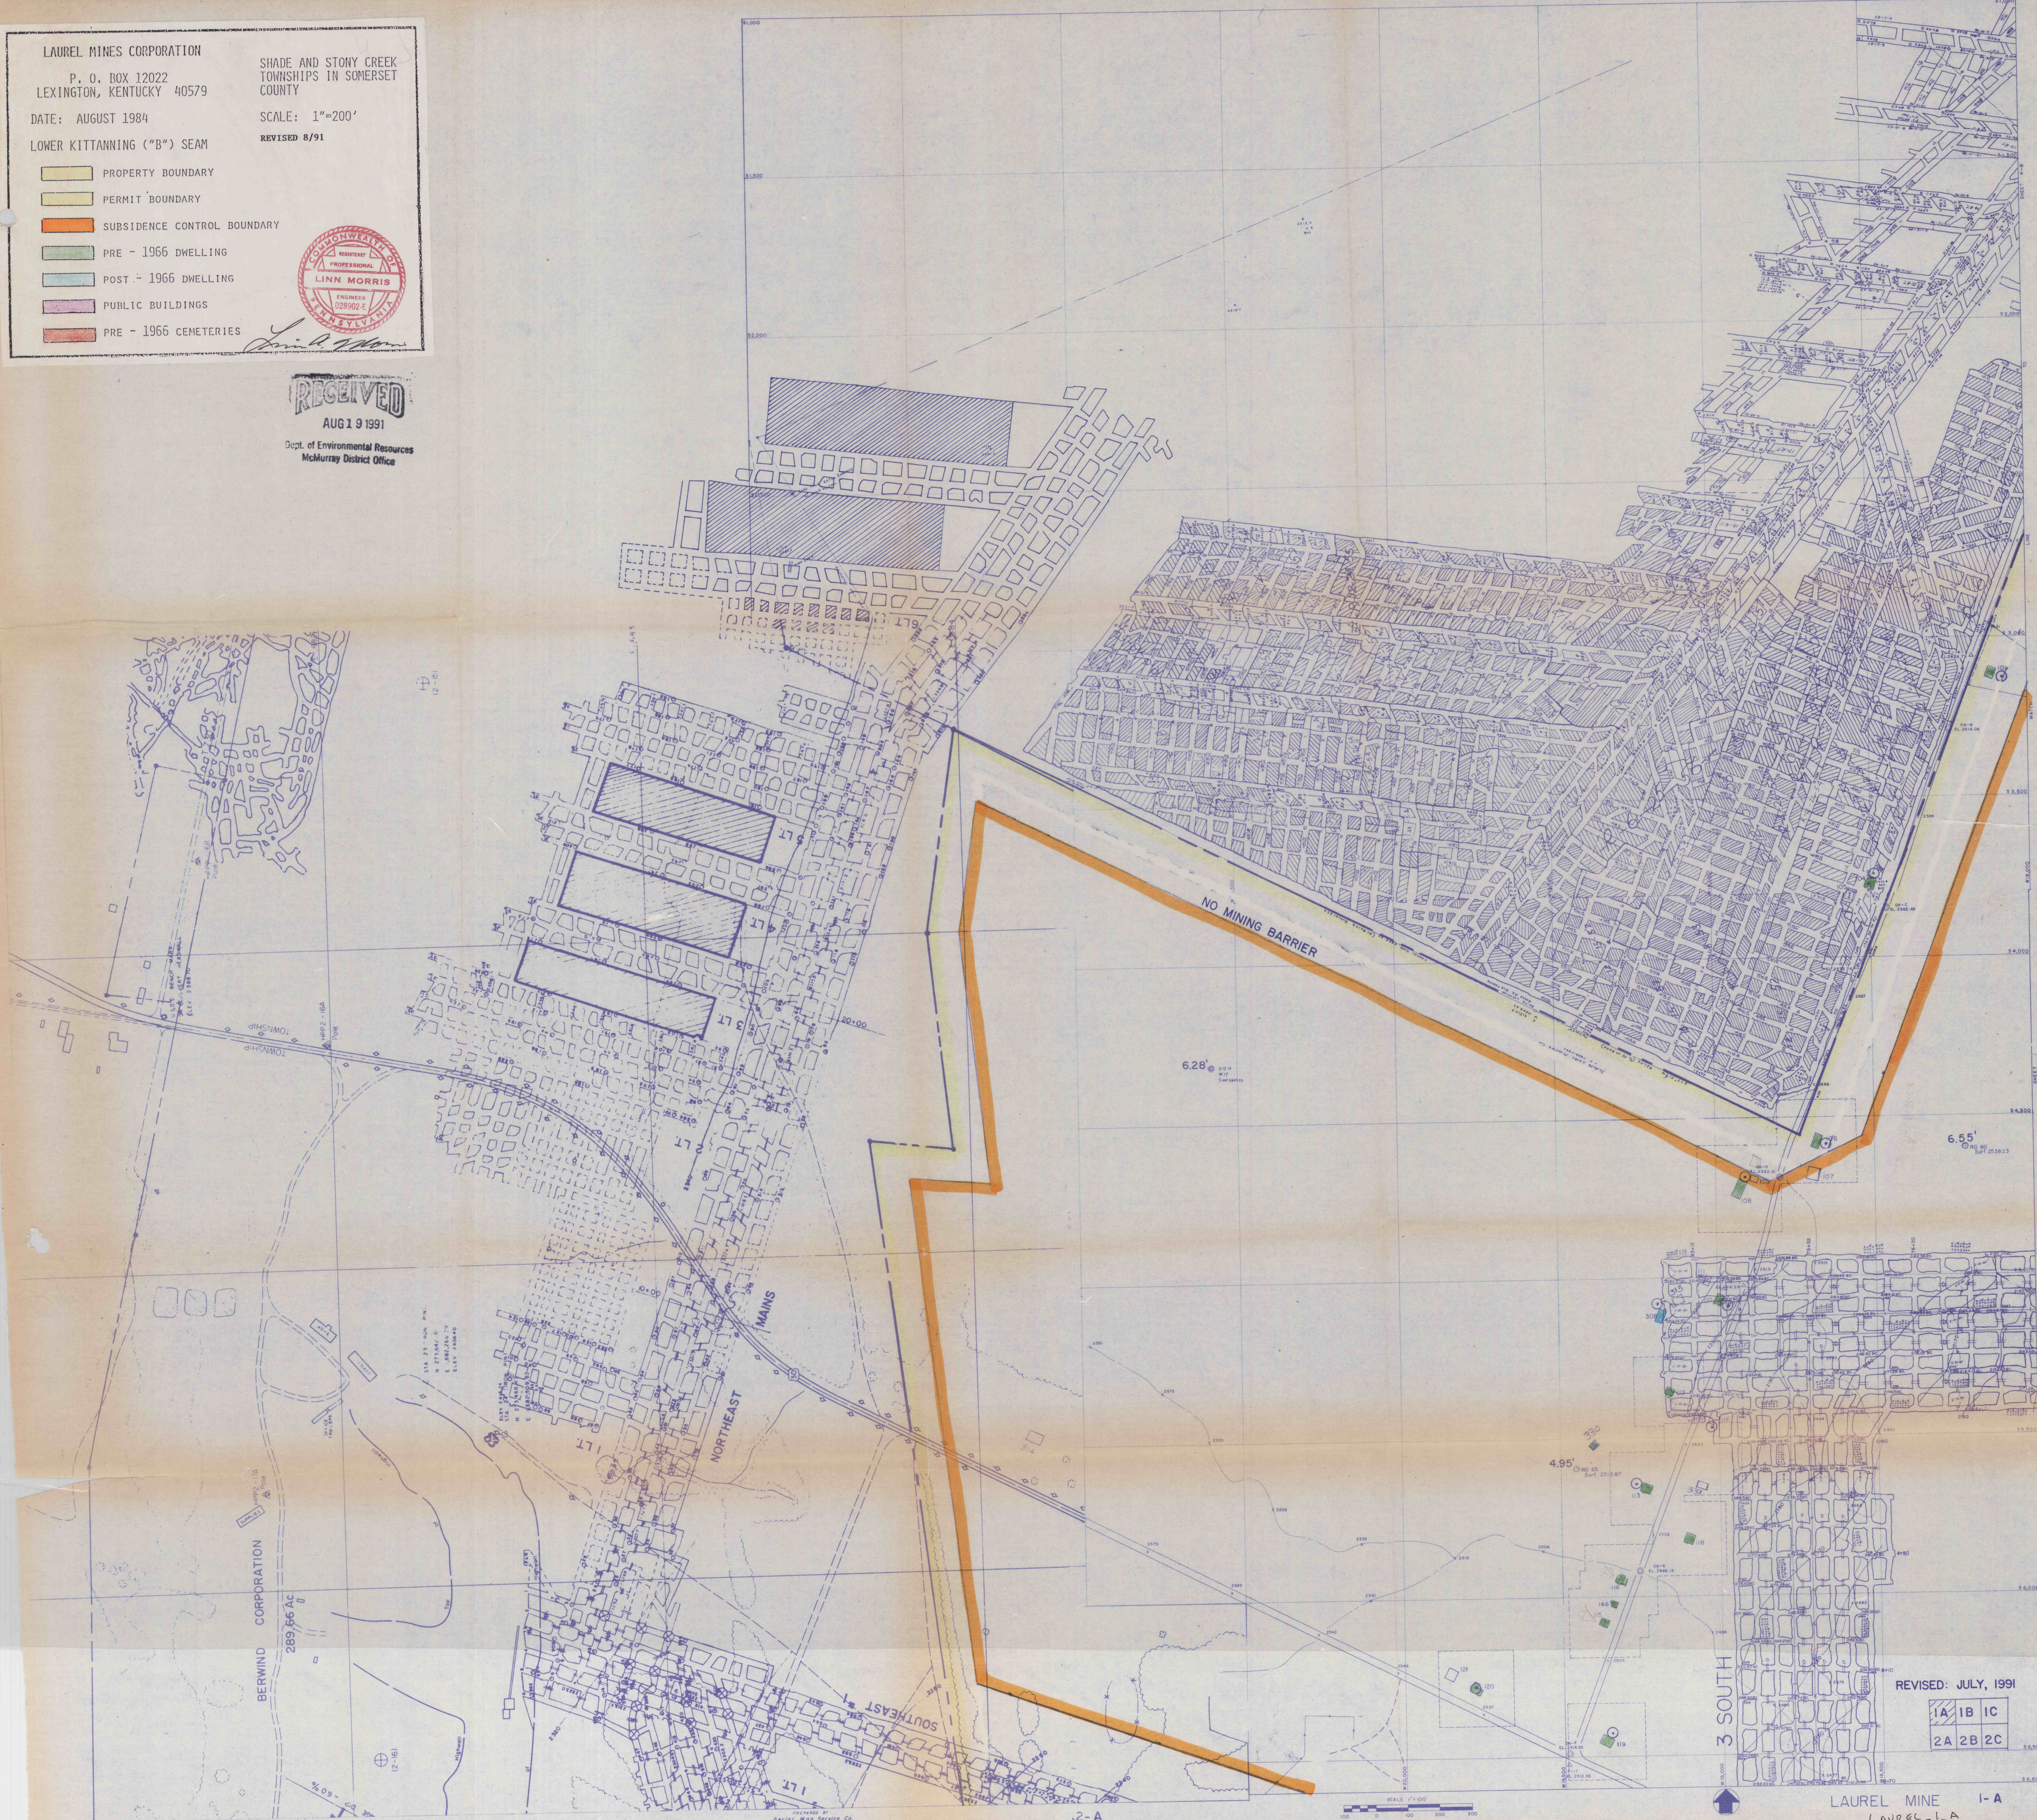

REVISED: JULY, 1991

1A	1B	1C
2A	2B	2C

LAUREL MINE
LAUREL-1-A