

LAUREL MINES CORPORATION

P. O. BOX 12022

LEXINGTON, KENTUCKY 40579

DATE: AUGUST 1984

LOWER KITTANNING ("B") SEAM

SHADE AND STONY CREEK

TOWNSHIPS IN SOMERSET

COUNTY

SCALE: 1"=200'

REVISED 8/91

- PROPERTY BOUNDARY
- PERMIT BOUNDARY
- SUBSIDENCE CONTROL BOUNDARY
- PRE - 1966 DWELLING
- POST - 1966 DWELLING
- PUBLIC BUILDINGS
- PRE - 1966 CEMETERIES

RECEIVED

AUG 19 1991

Dept. of Environmental Resources


McMurray District Office

REGISTERED PROFESSIONAL ENGINEER

LINN MORRIS



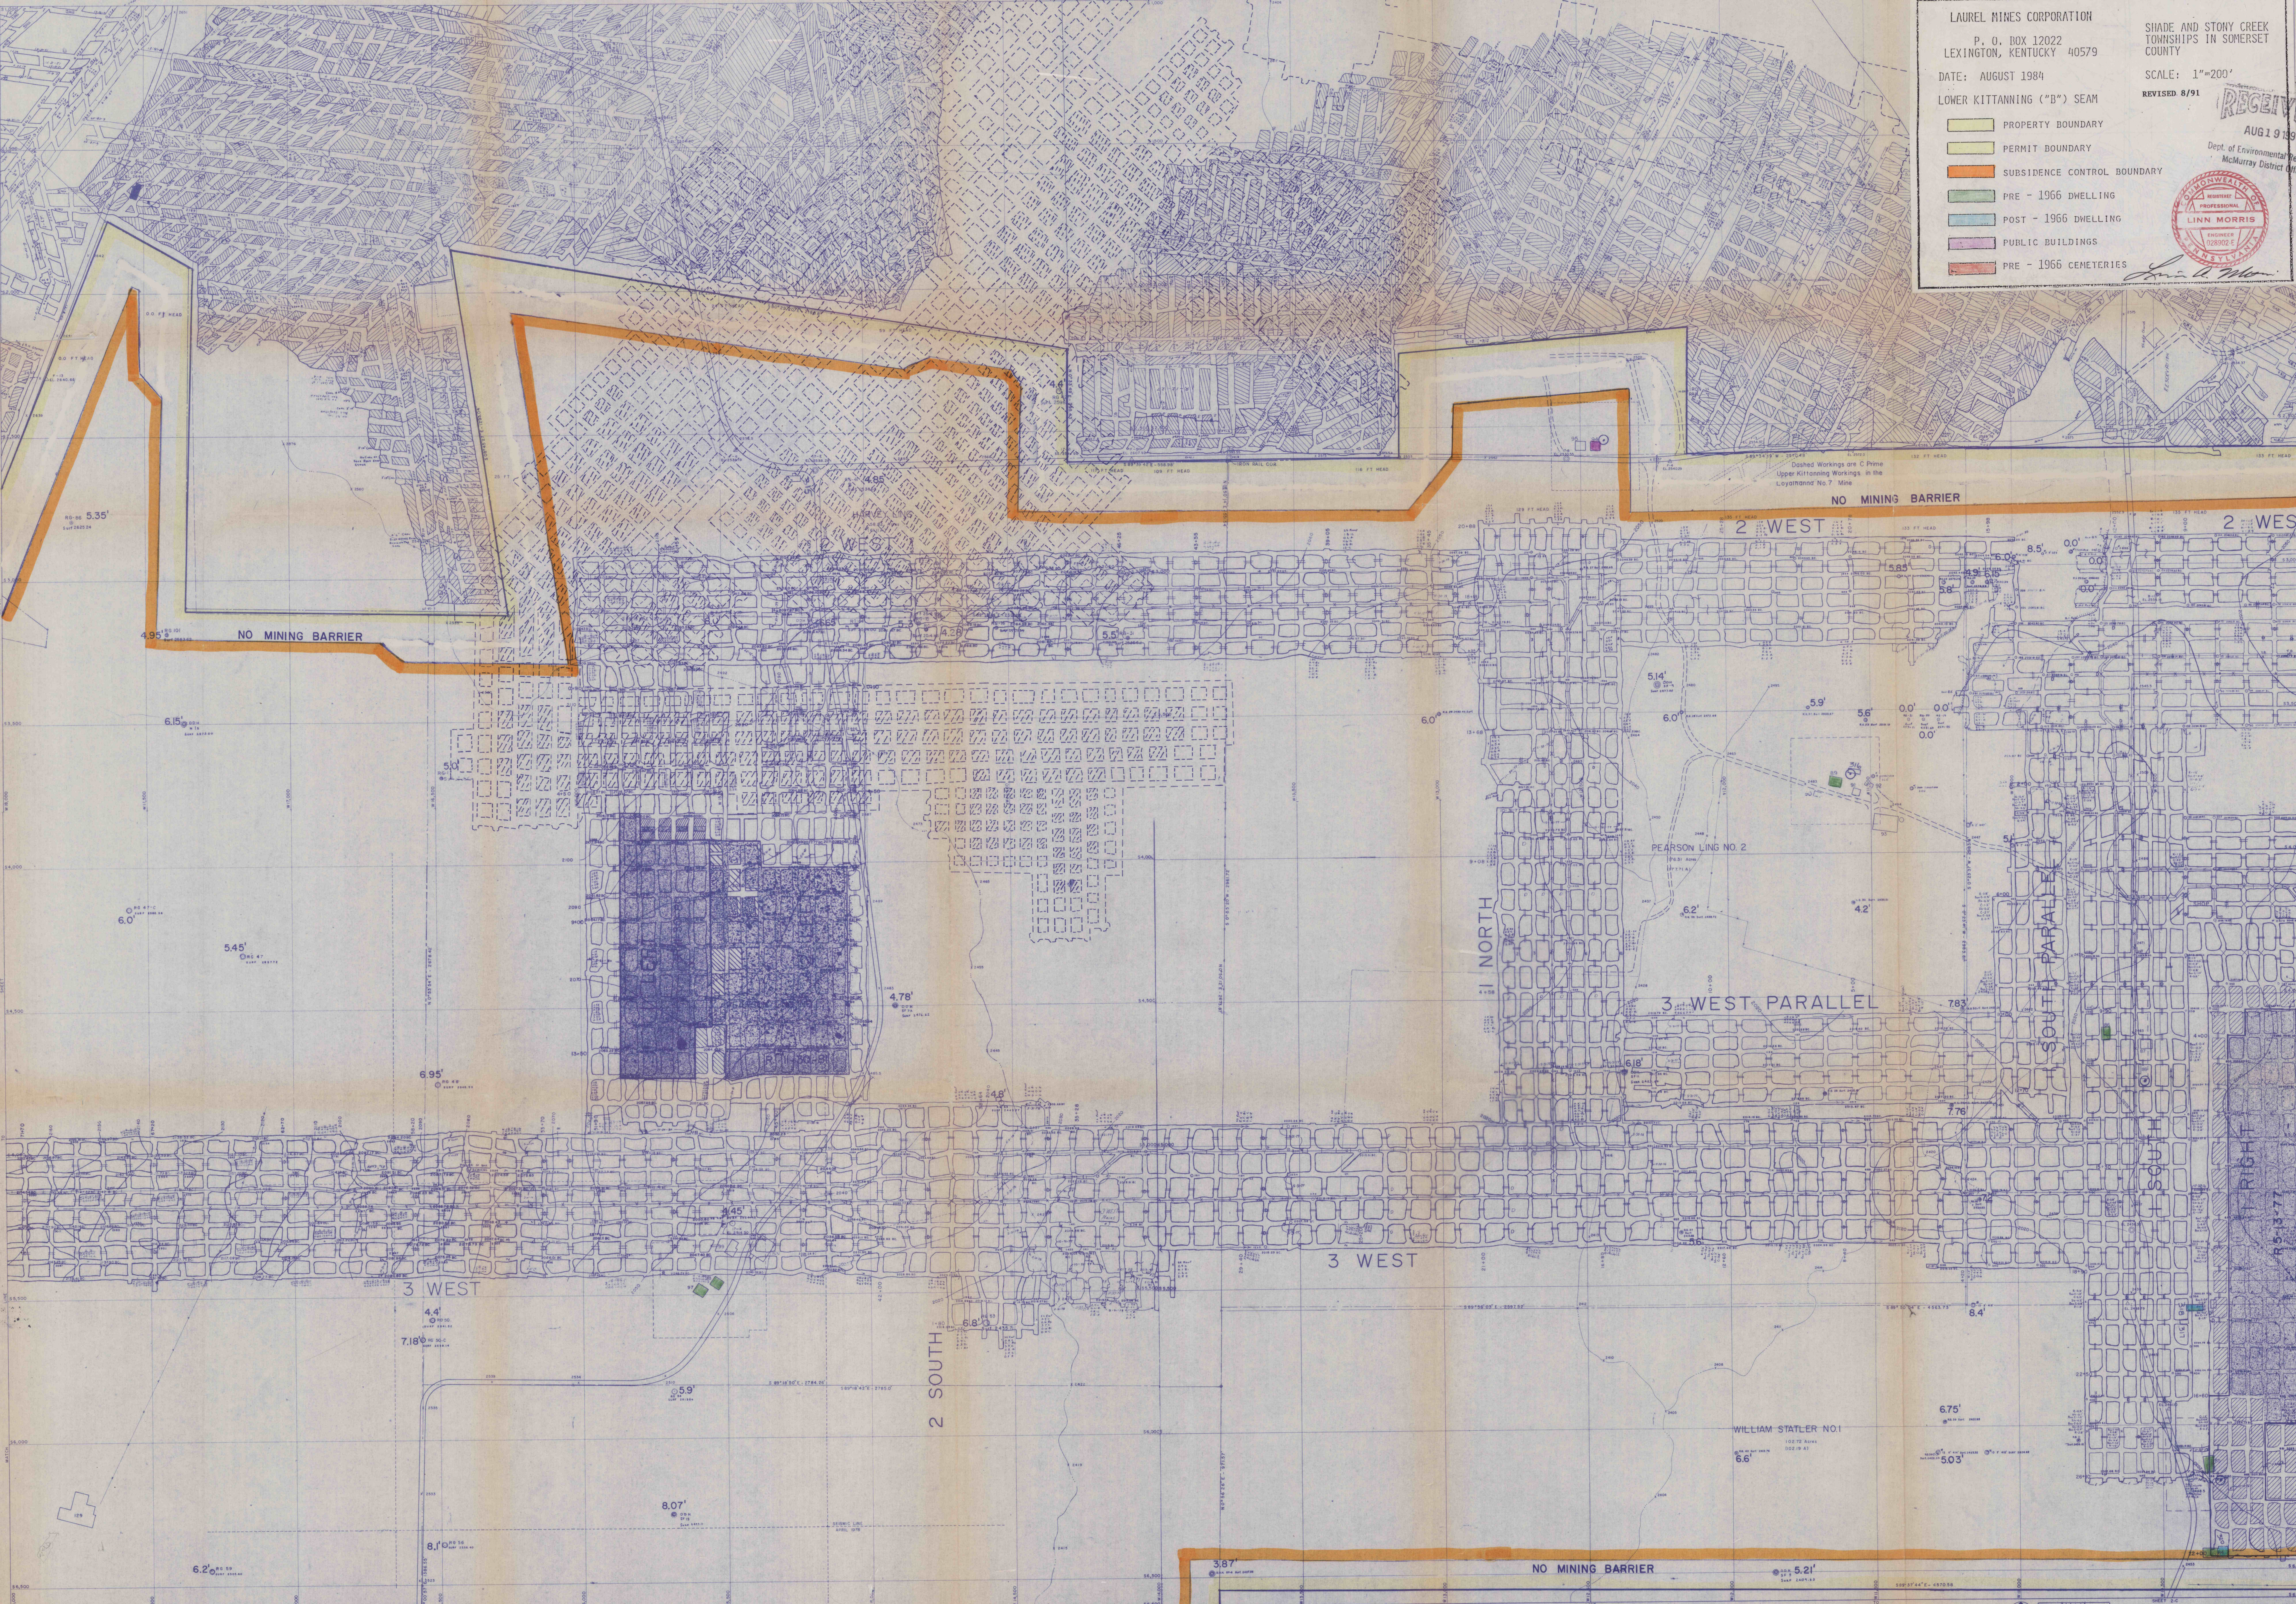

I-A

I-B