


LOCAL MINE COORDINATE SYSTEM				
PERMANENT MONUMENT INFORMATION				
Monument ID	Description	Northing	Easting	Elevation
PM #1	Rootbolt In Concrete	39416.584	28760.096	896.82'
PM #2	Rootbolt In Concrete	39080.499	29080.182	943.53'
PM #3	Rootbolt In Concrete	39081.585	28598.455	930.68'

STATE PLAN COORDINATE SYSTEM NAD83				
PERMANENT MONUMENT INFORMATION				
Monument ID	Description	Northing	Easting	Elevation
PM #1	Rootbolt In Concrete	151675.91	1493308.53	896.82'
PM #2	Rootbolt In Concrete	151329.68	1493619.99	943.53'
PM #3	Rootbolt In Concrete	151345.07	1493138.57	930.68'

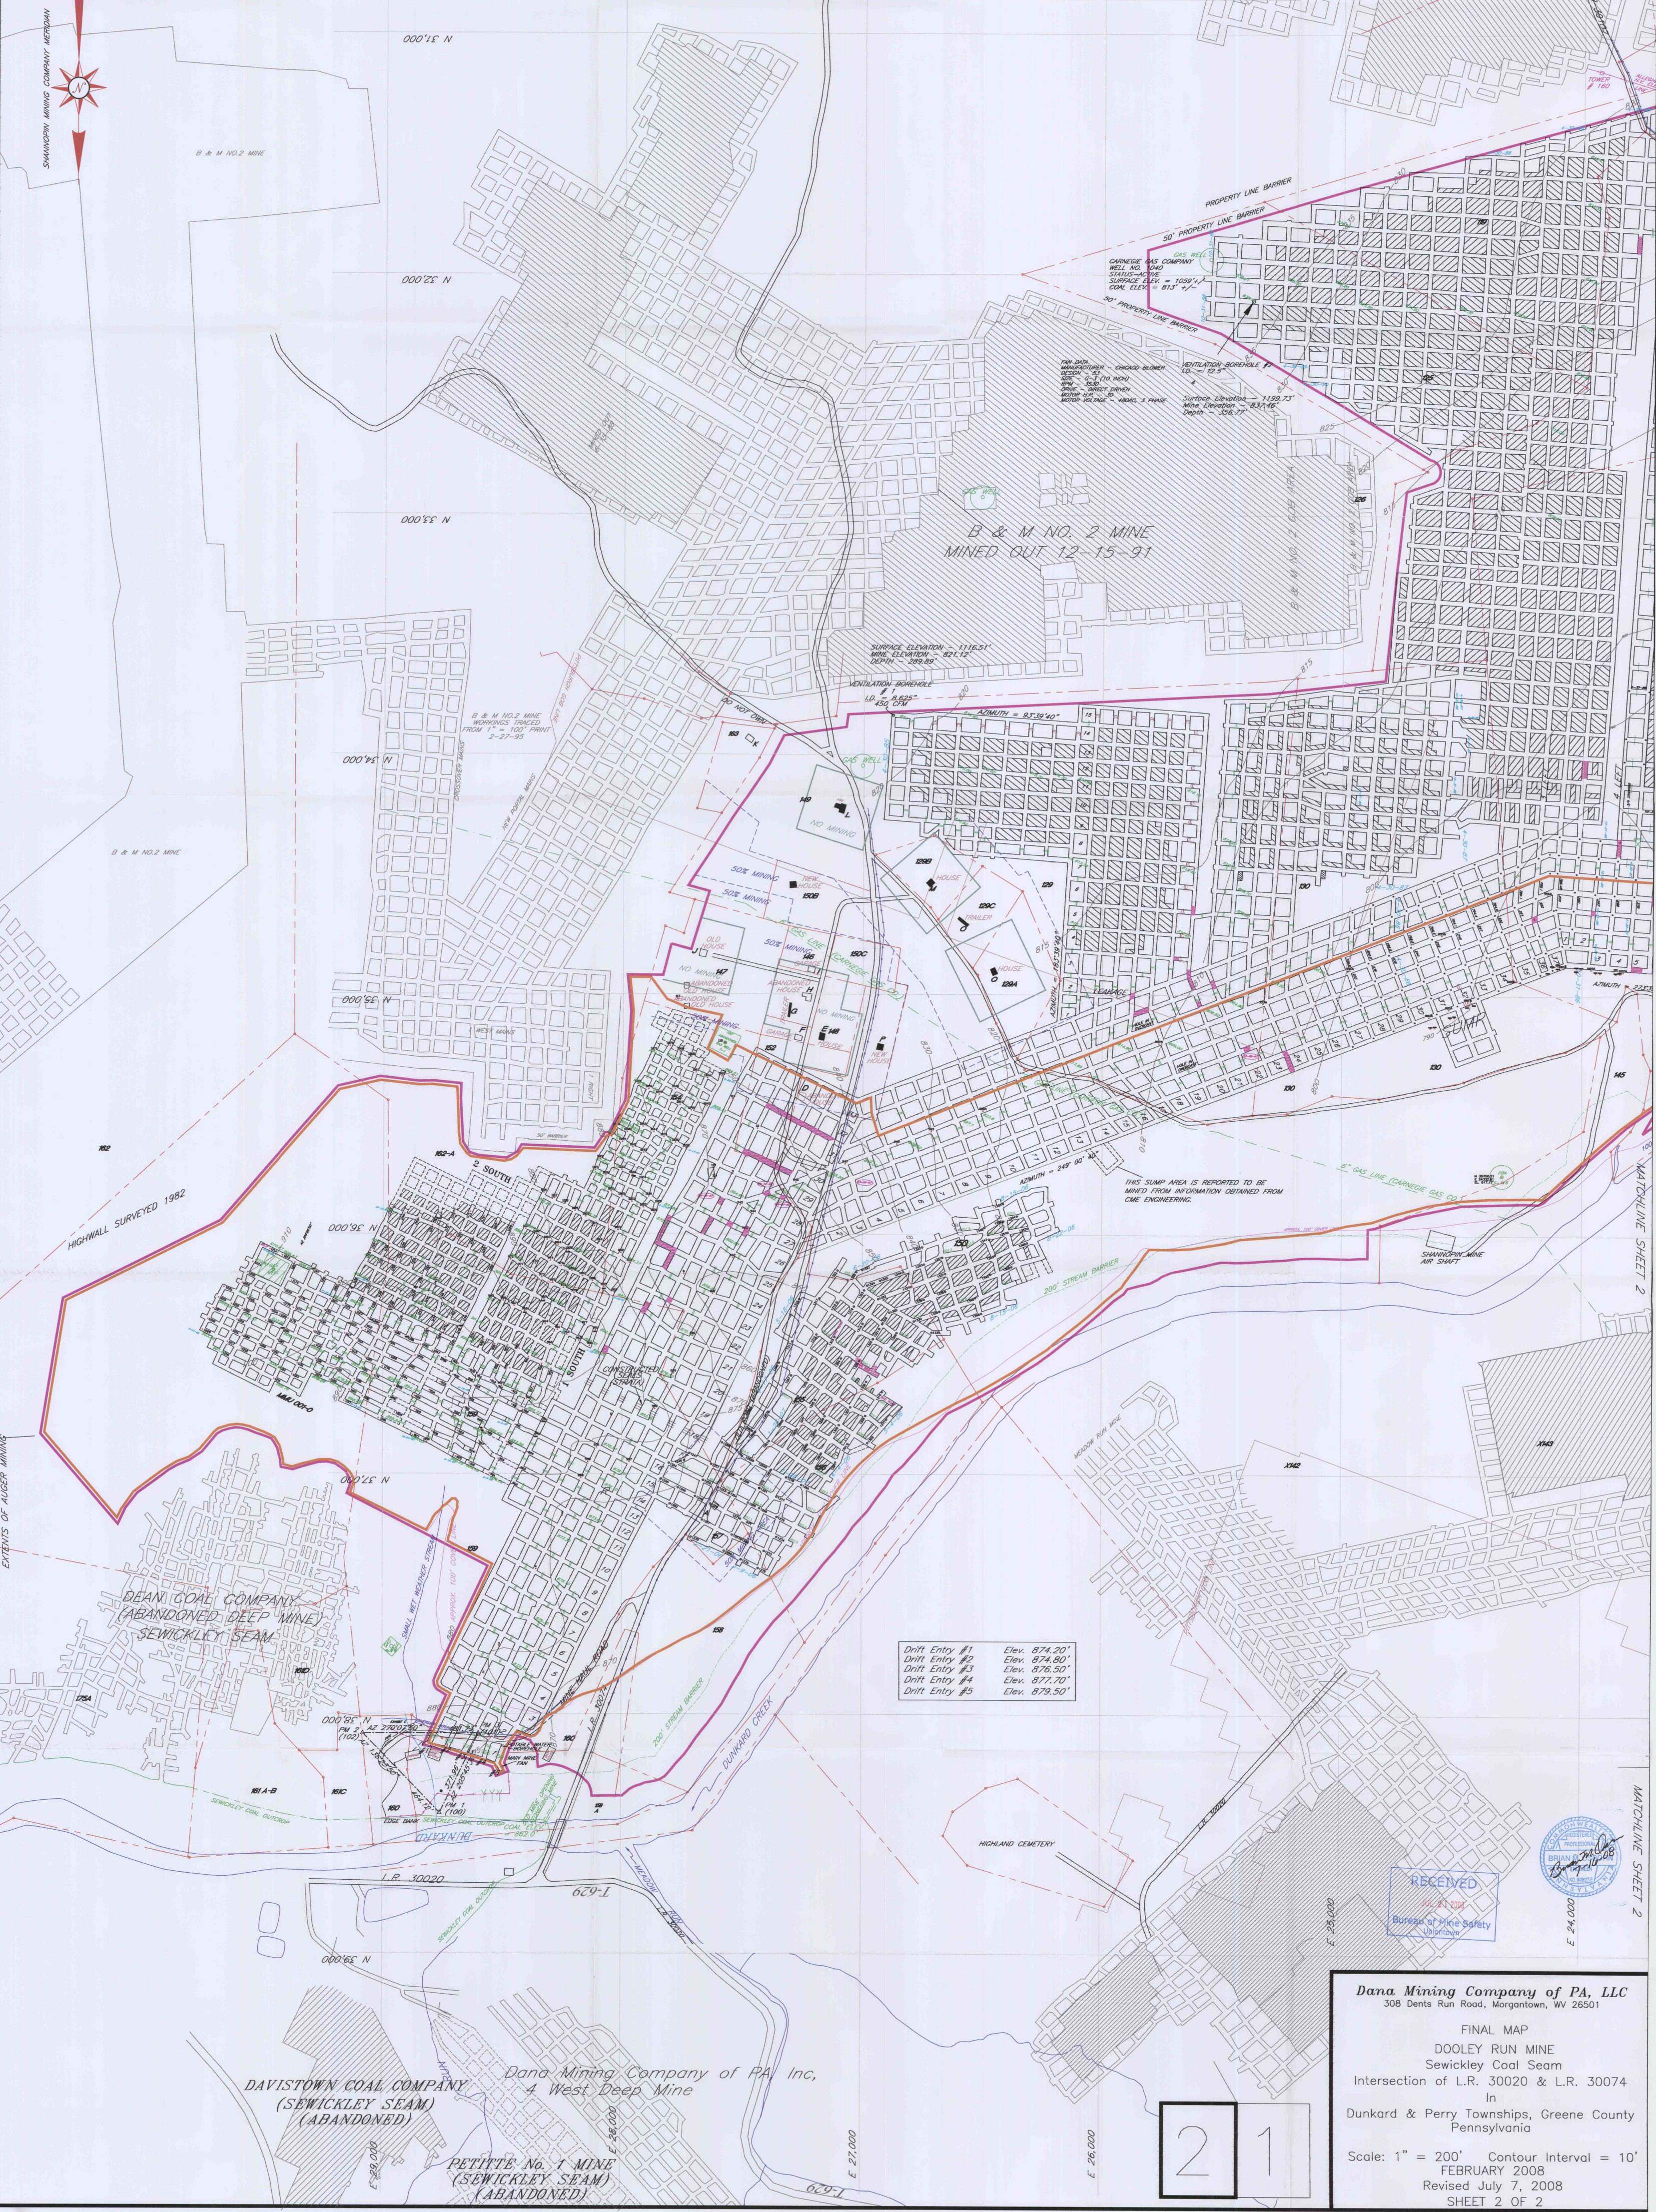

Drift Entry #1	Elev. 874.20'
Drift Entry #2	Elev. 874.80'
Drift Entry #3	Elev. 876.50'
Drift Entry #4	Elev. 877.70'
Drift Entry #5	Elev. 879.50'

Dana Mining Company of PA, LLC
 308 Dents Run Road, Morgantown, WV 26501

FINAL MAP
 DOOLEY RUN MINE
 Sewickley Coal Seam
 Intersection of L.R. 30020 & L.R. 30074
 In
 Dunkard & Perry Townships, Greene County
 Pennsylvania

Scale: 1" = 200' Contour Interval = 10'
 FEBRUARY 2008
 Revised July 7, 2008
 SHEET 2 OF 2