


MAP
 SHOWING
 "D" SEAM WORKINGS
 OF
 CHILCOTE COAL CO. MINE #1
 READE TWP., CAMBRIA CO., PA.
 SCALE 1"=100' 8-11-56
 J.L. BANFIELD REG. ENG.

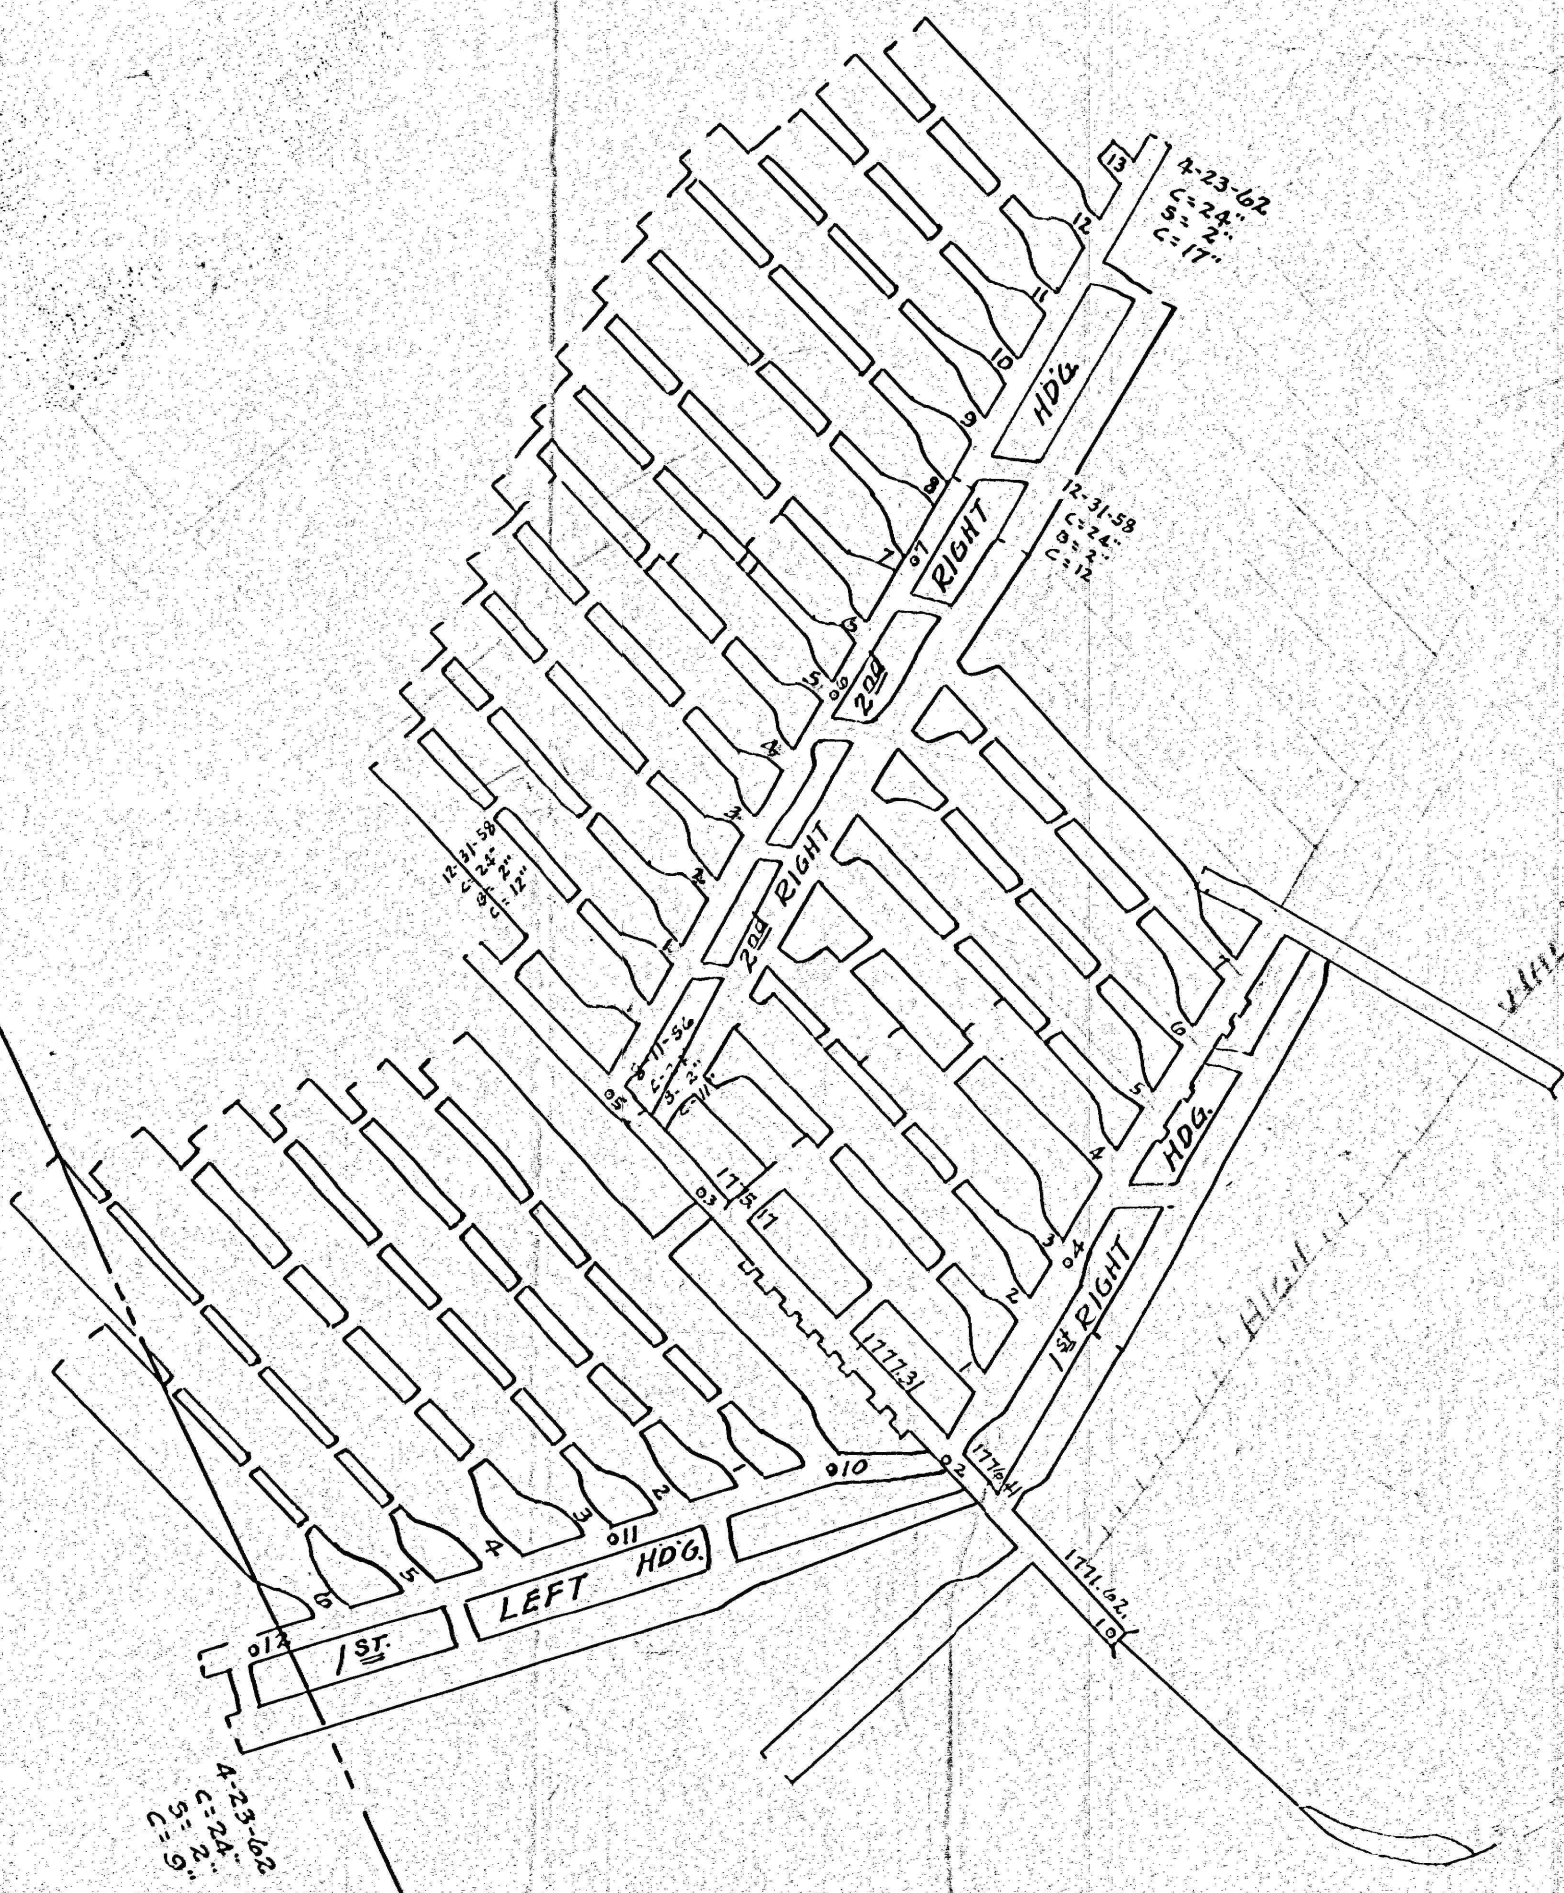

#533
 6-21-99
 CC