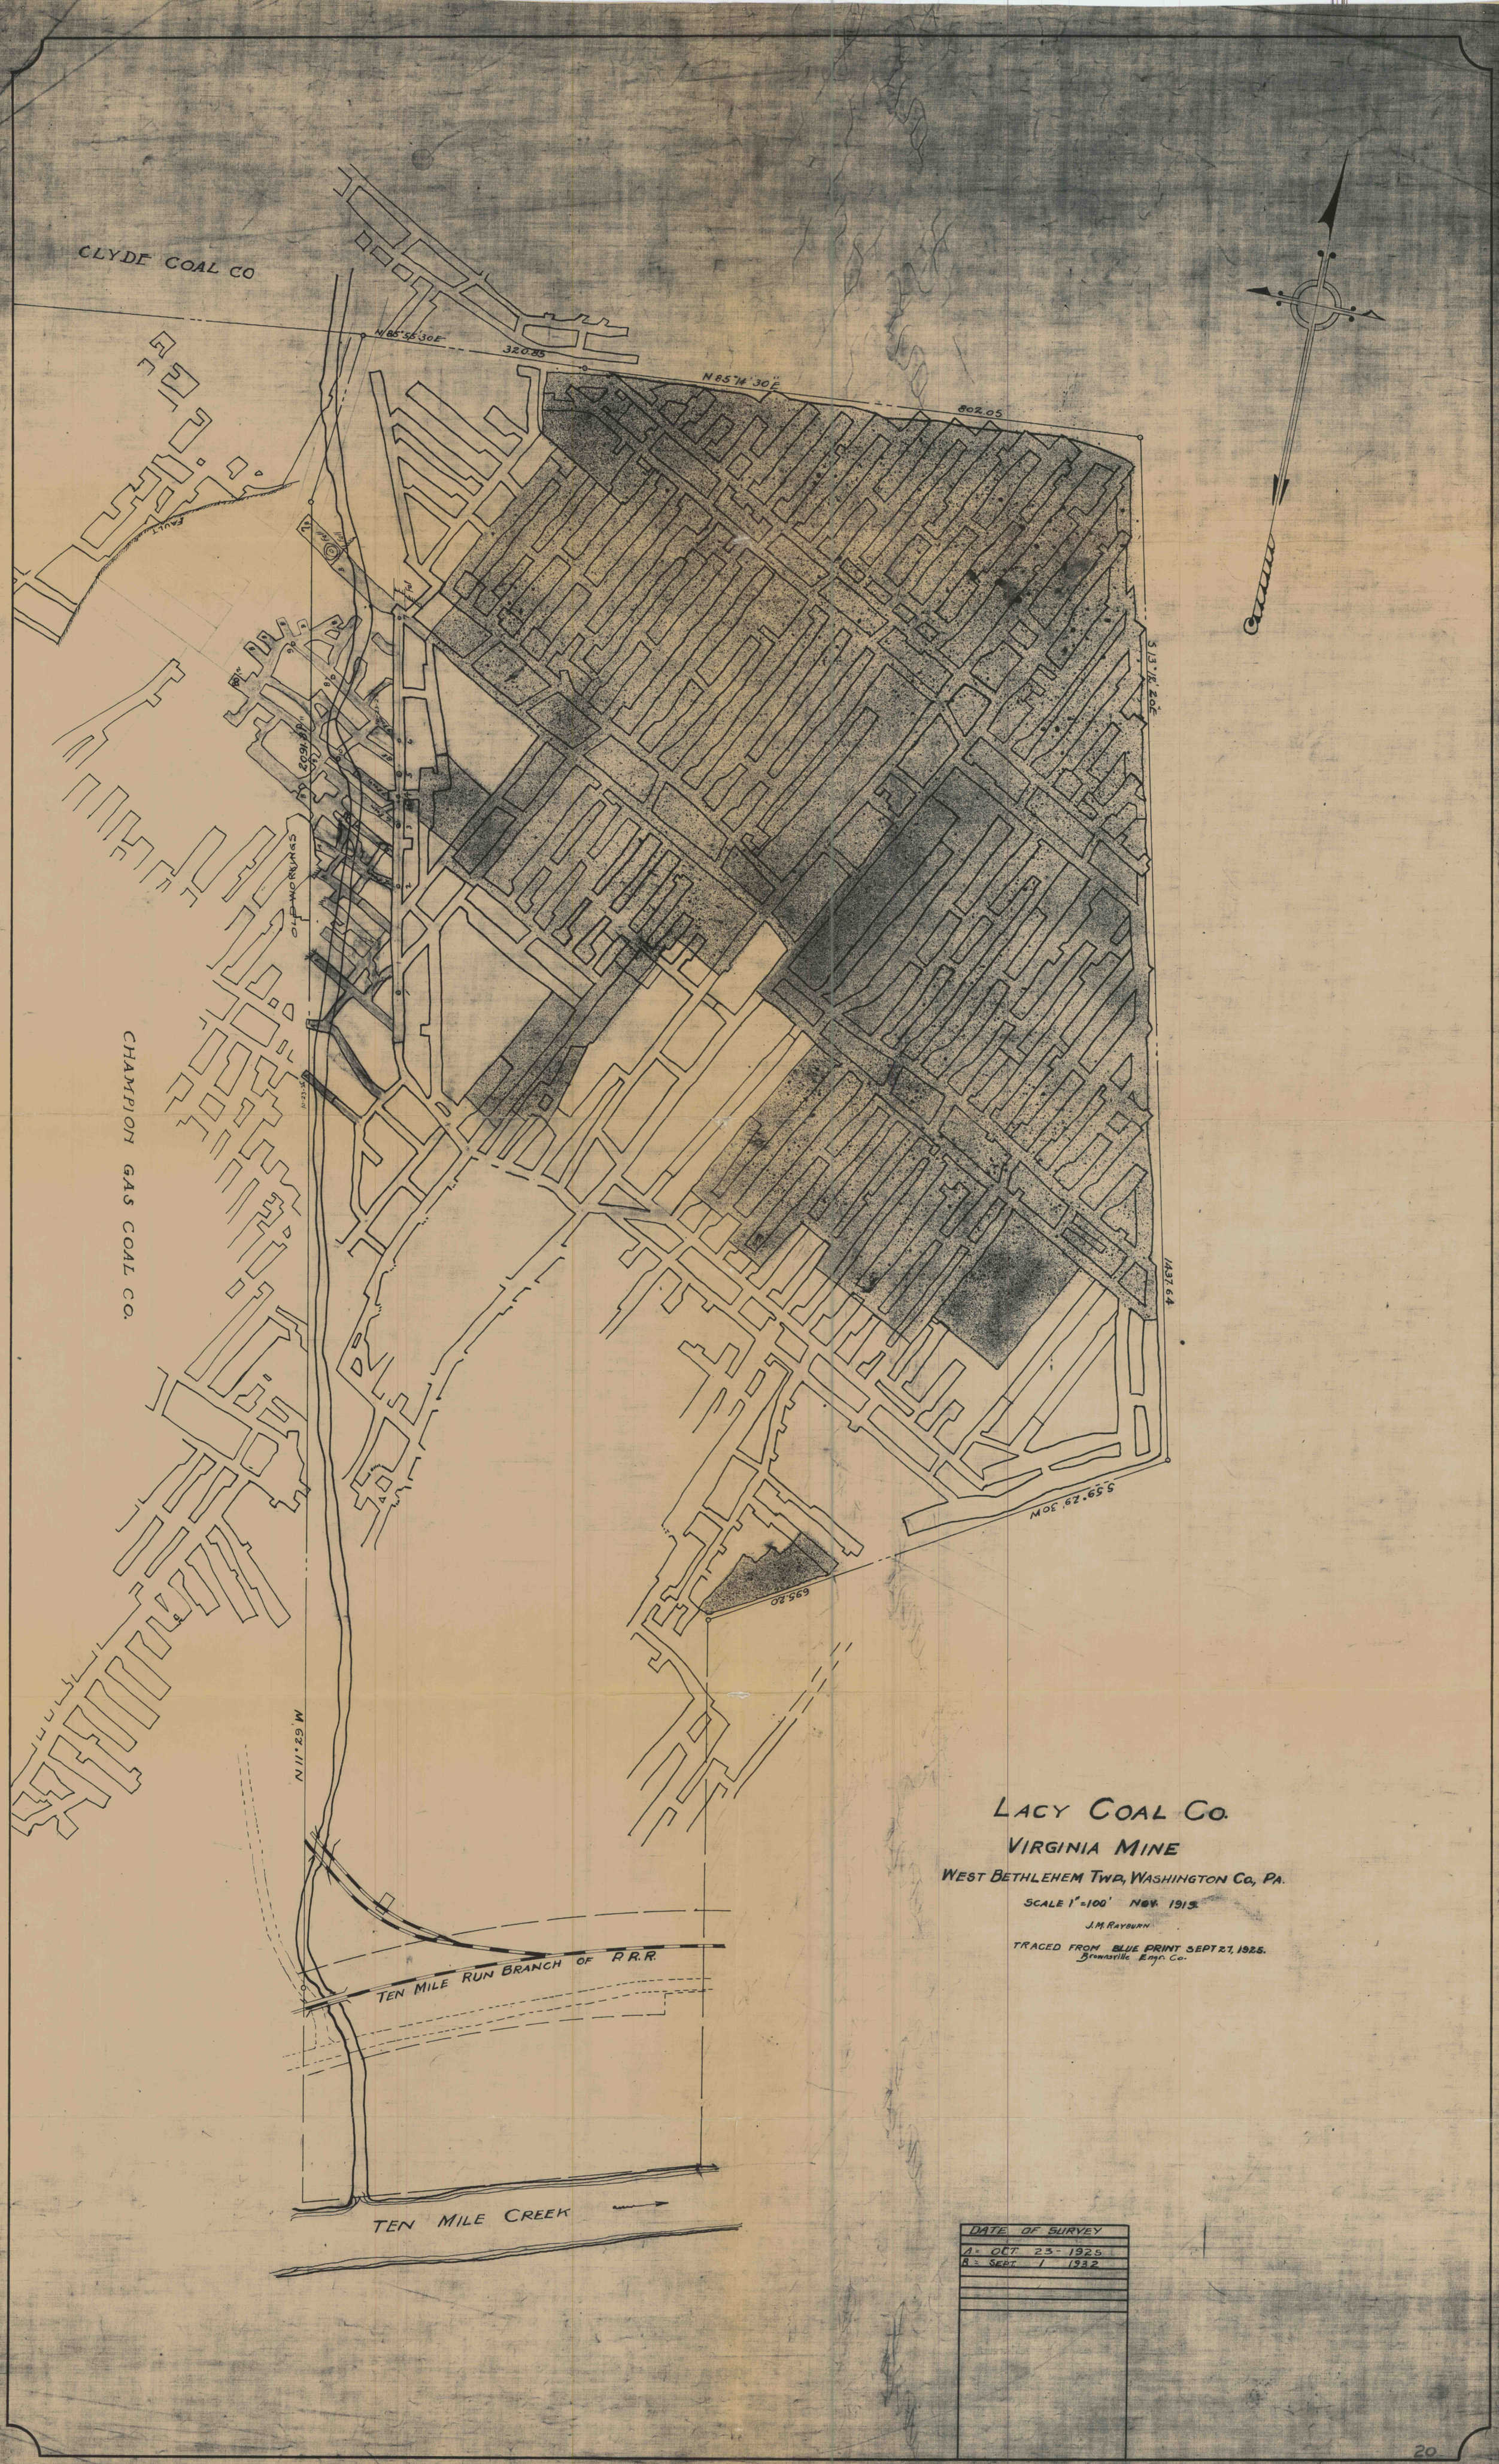
CLYDE COAL CO
N 85°55'30"E
320.85
N 85°14'30"E
802.05
S 13°18'20"E
1437.64
S 59°29'30"W
695.20
N 11°29'W
2091.50'
OLD WORKINGS
FAULT
CHAMPION GAS COAL CO.
TEN MILE RUN BRANCH OF P.R.R.
TEN MILE CREEK
LACY COAL CO.
VIRGINIA MINE
WEST BETHLEHEM TWP, WASHINGTON CO, PA.
SCALE 1"=100' NOV. 1913
J.M. RAYBURN
TRACED FROM BLUE PRINT SEPT 27, 1925.
Brownsville Engr. Co.
DATE OF SURVEY
A = OCT. 23 - 1925
B = SEPT. 1 1932