


MARTHA E SNYDER ESTATE
(OLD OGLE NO 1 WORKINGS PILLARS DRAWN)

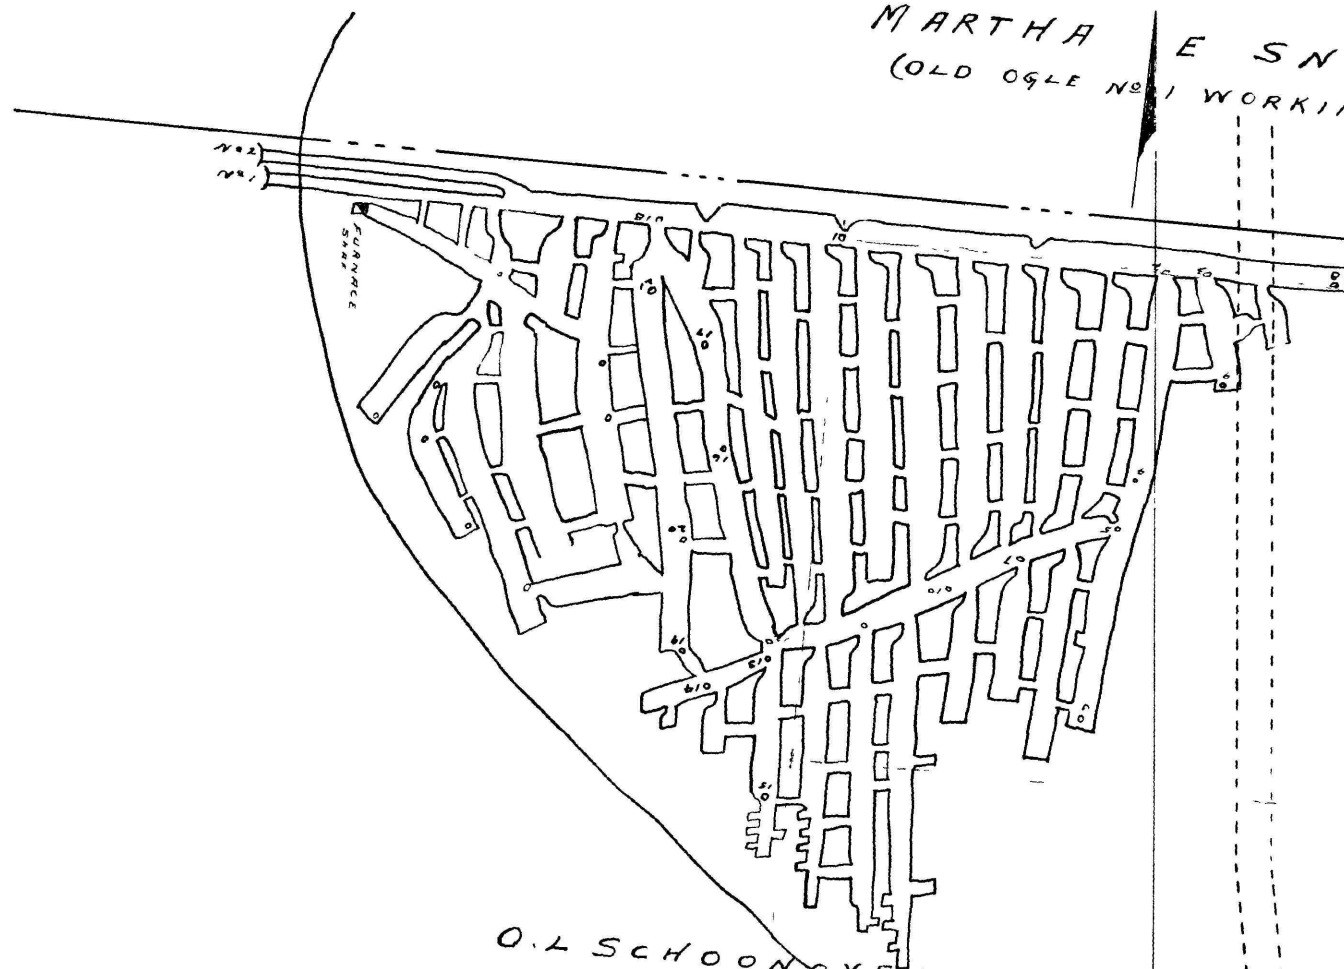

O. L. SCHOONOVER ESTATE

REYNOLDS LLOYD & CO.

MAP OF MINE NO 1
OPERATED BY CHRISTIANSON AND JOHNSON
NEAR LANSE CLEARFIELD COUNTY PA
SCALE 1" = 100'
H. A. REESE ENGR
APRIL 1-1918