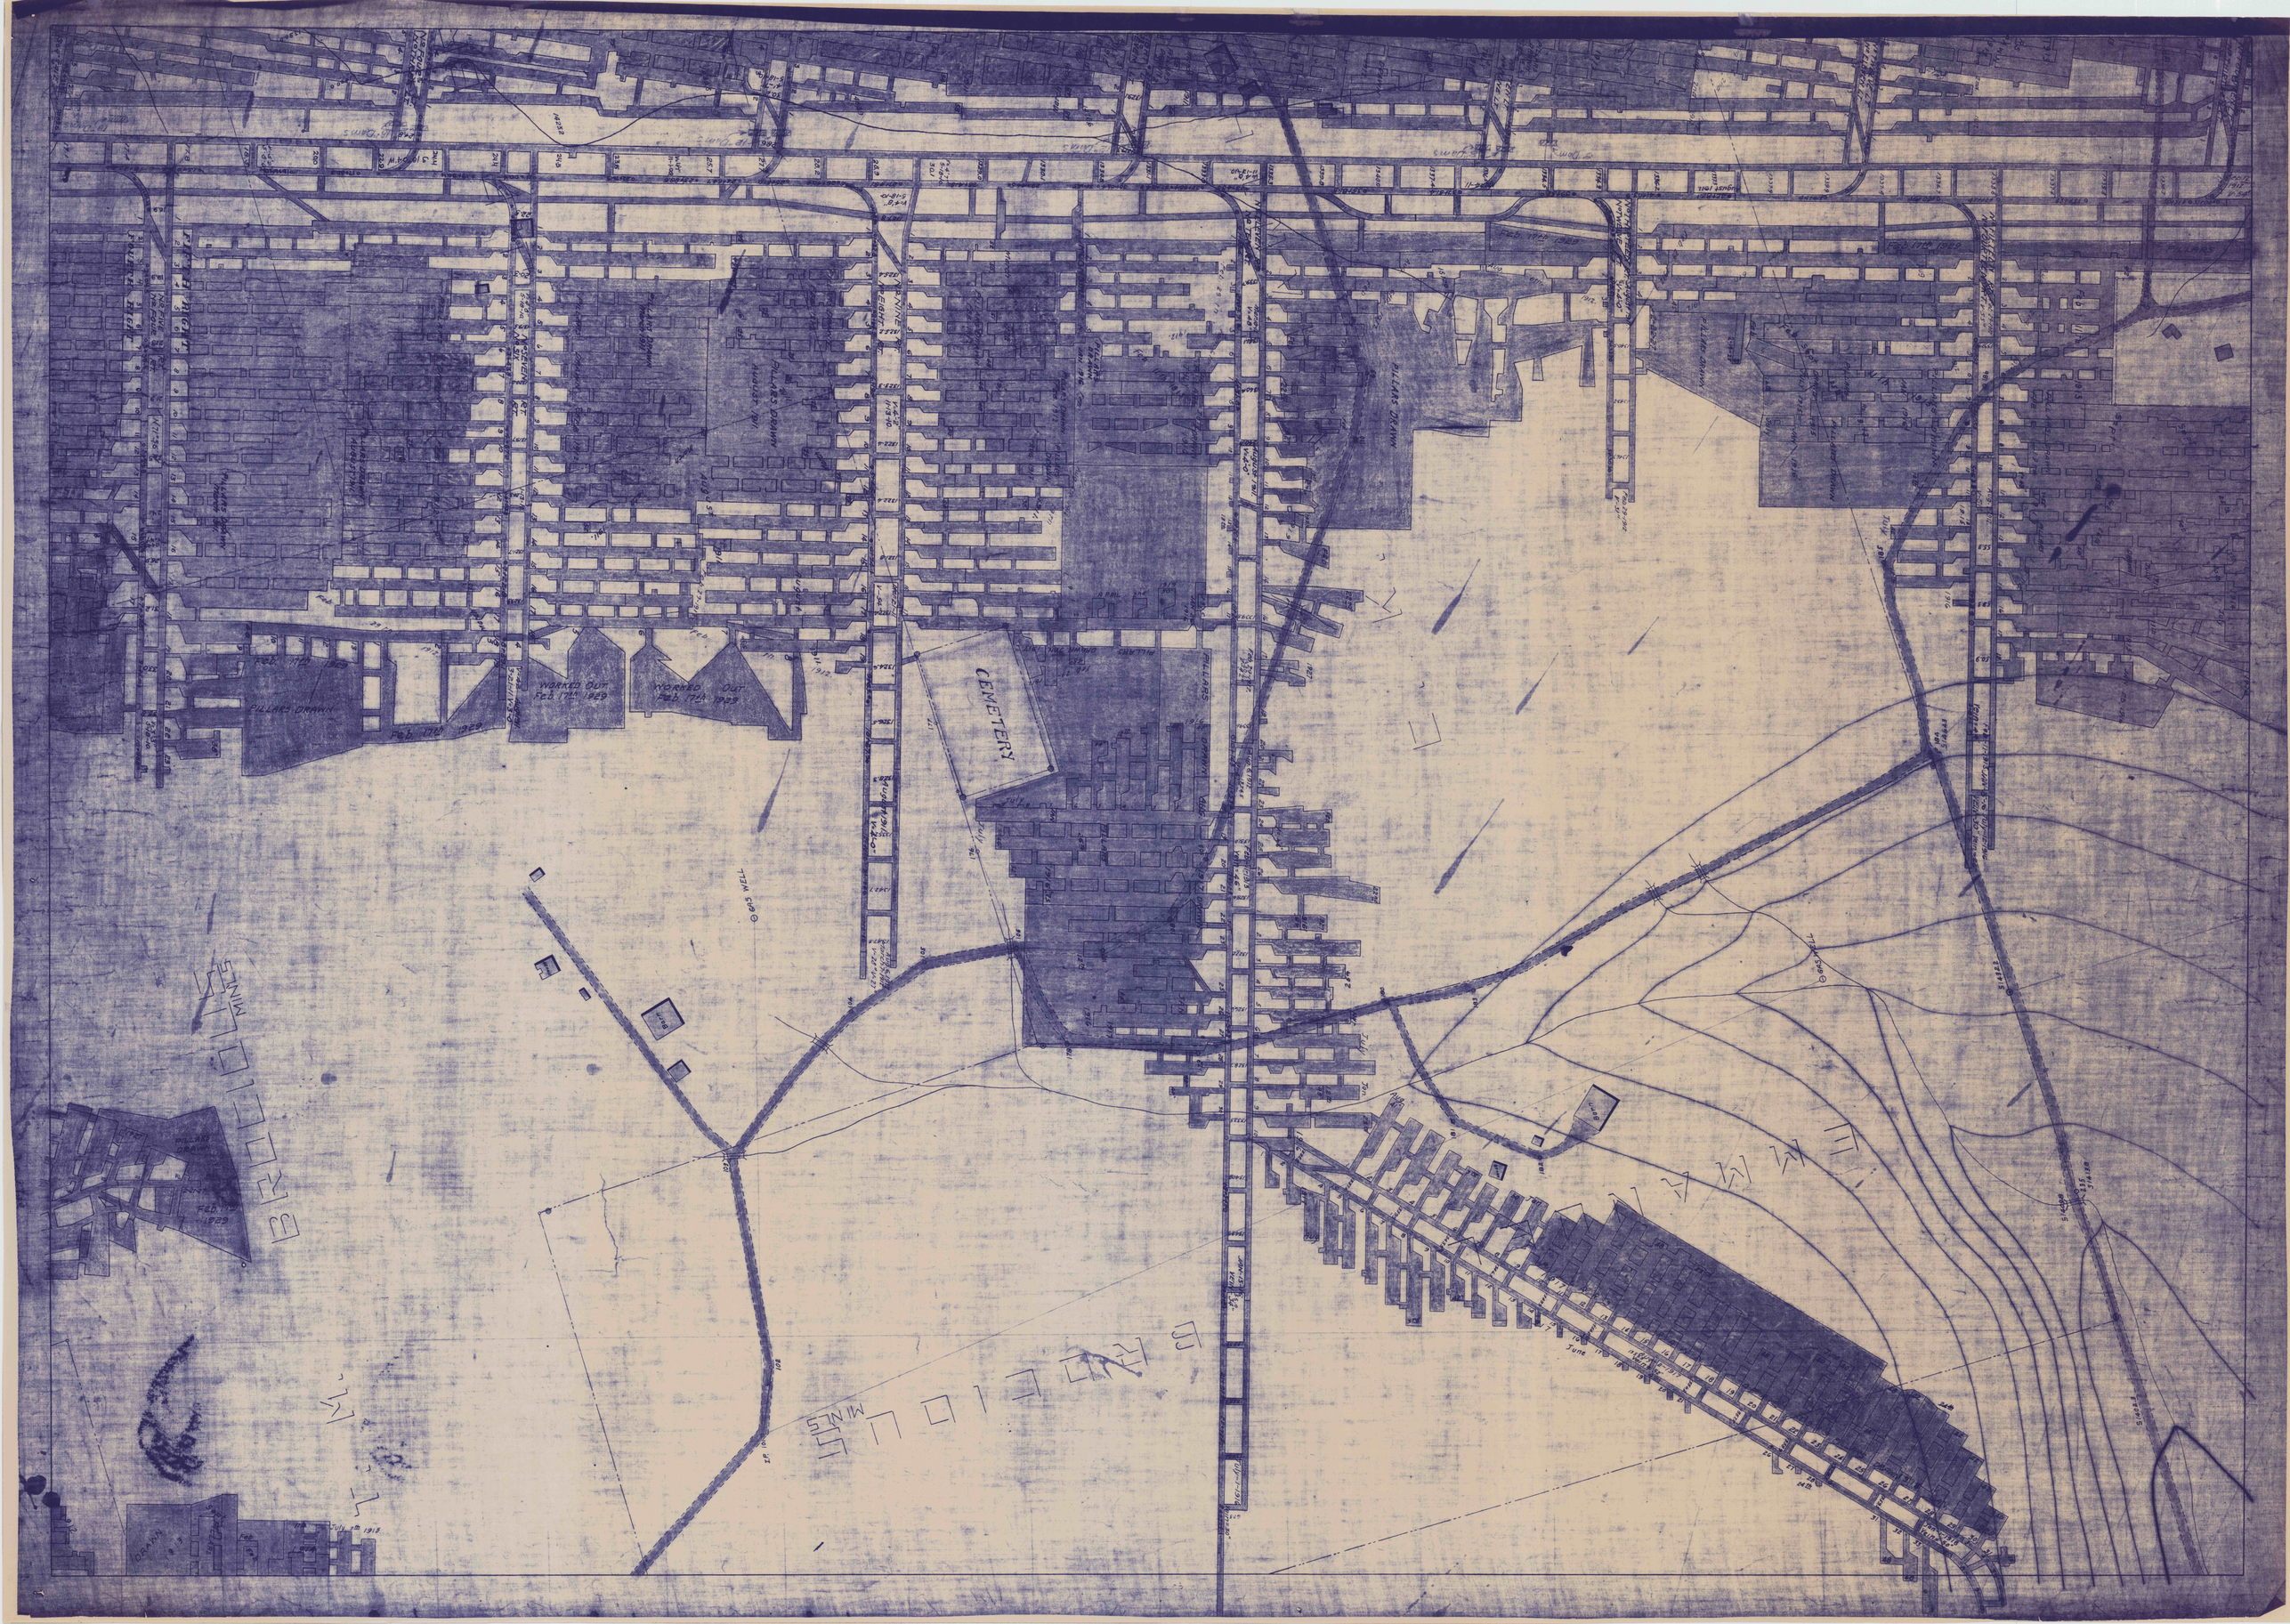
CEMETERY
WORKED OUT FEB 17th 1909
WORKED OUT FEB 17th 1909
PILLARS DRAIN
PILLARS
COLLIERY
COLLIERY